
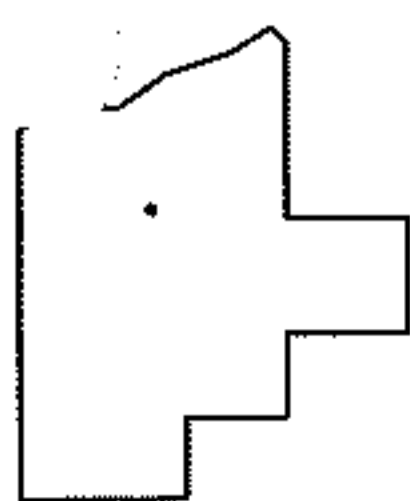
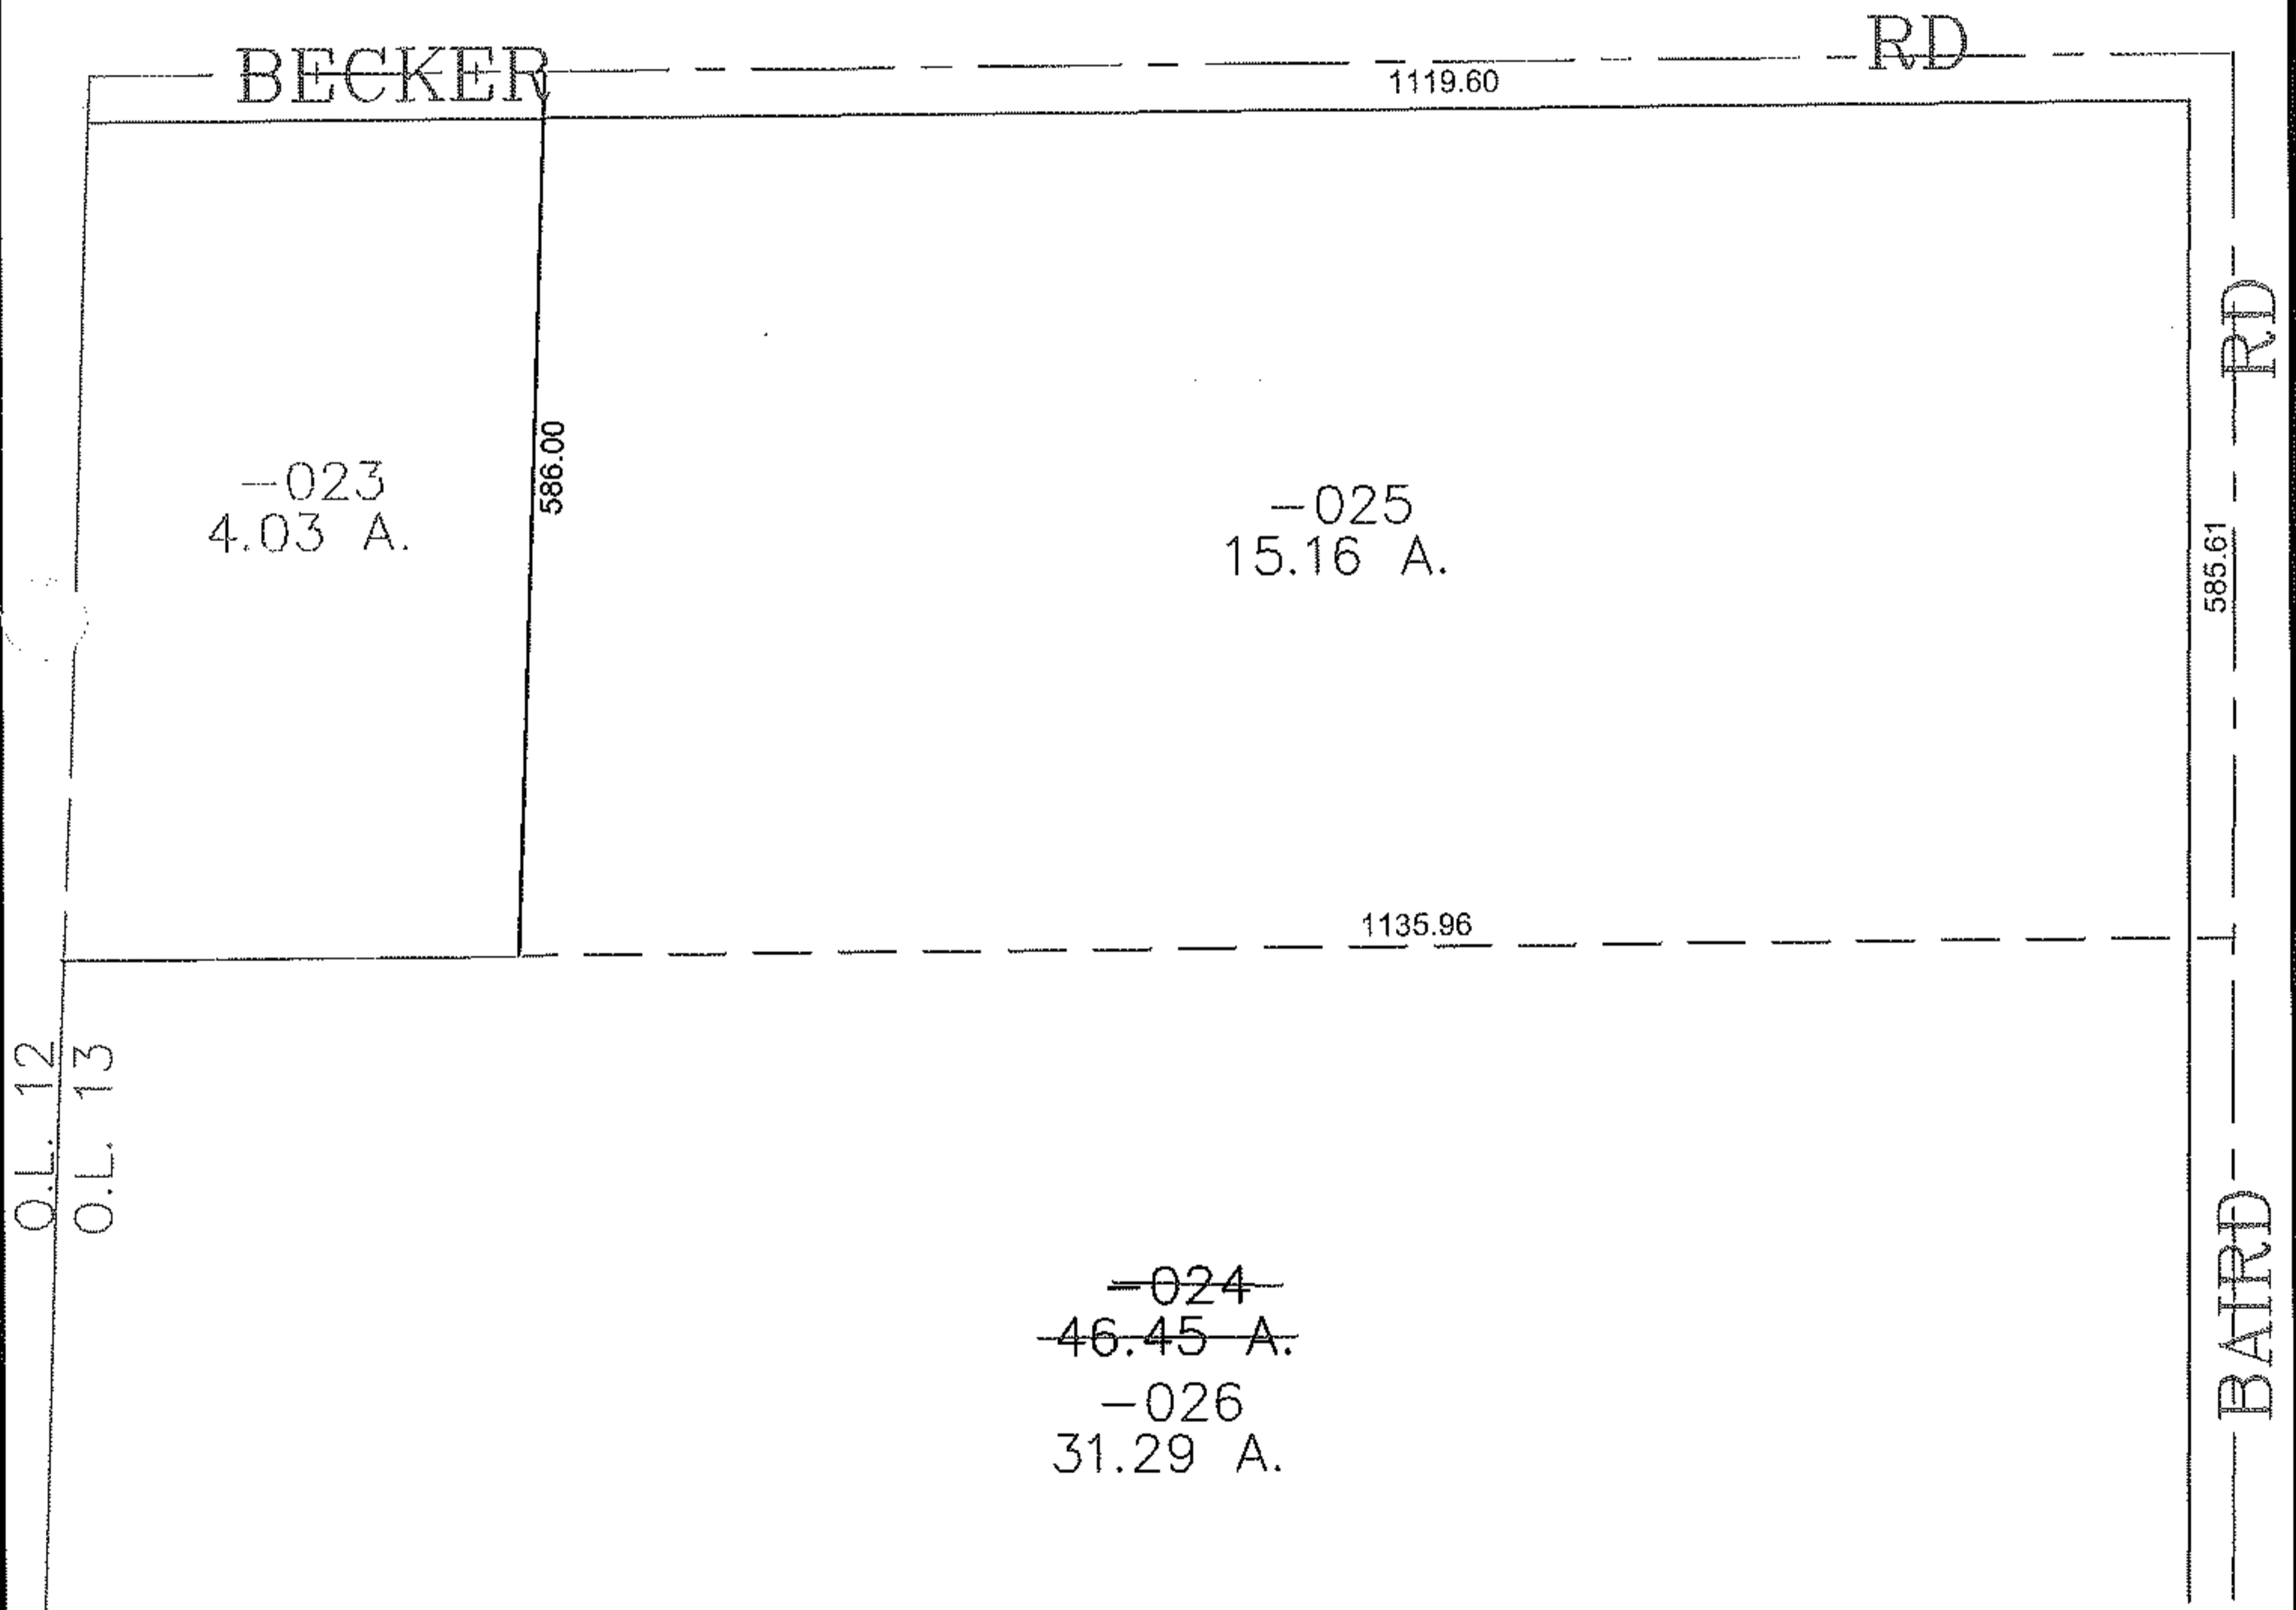


PARENT PARCEL: 08-12-013-000-024

CHILD PARCEL: 08-12-013-000-025, -026

12-03095

STARTING POINT: CENTERLINE OF BECKER RD & BAIRD RD

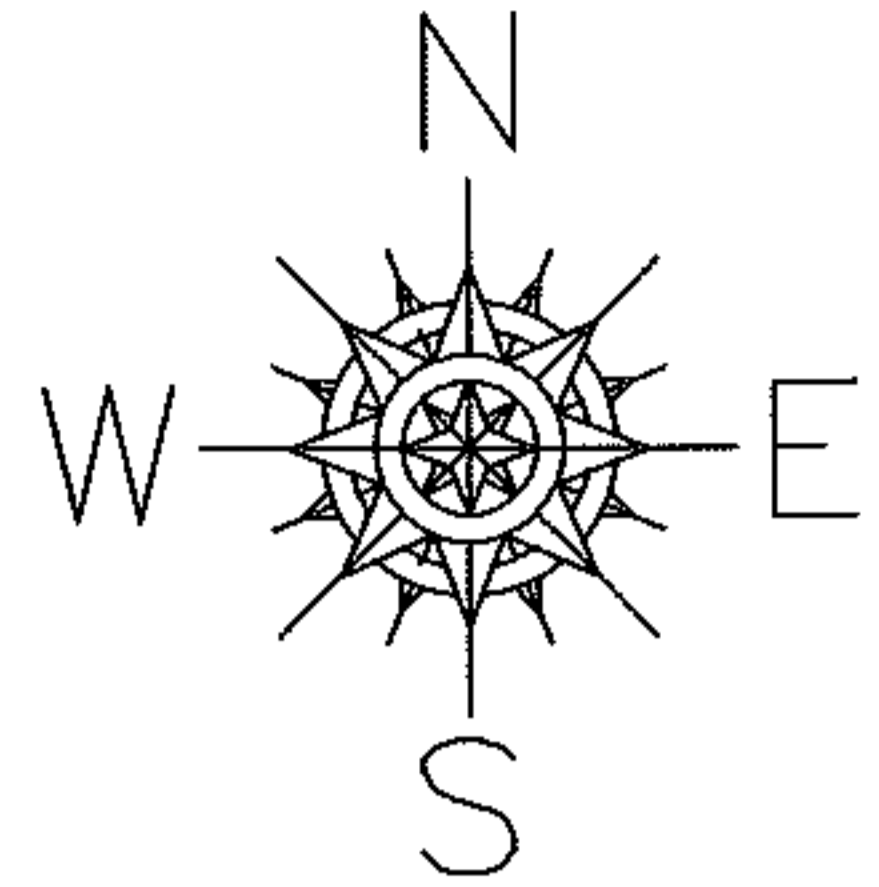

SPLITS/DEEDS PROCESSED
 LORAIN COUNTY TAX MAP DEPARTMENT
 226 MIDDLE AVE. ELYRIA, OHIO

SURVEYED BY: THOMAS SNEZEK
 CLOSURE: 0.00 : 10,000
 MAP PAGE(S): 8-E
 APPROVED BY: JAH DATE: 11/19/2012
 SCALE: 1" = 200 PRIOR INSTRUMENT: 20020868846