


PARENT PARCEL: 06-25-030-102-032 DROP FROM DUPLICATE  
 CHILD PARCEL: ADD TO DUPLICATE 06-25-030-900-002  
 STARTING POINT: P.V. 22 PG. 35

15-03098-C



DROP FROM DUPLICATE

06-25-030-102-032  
 3.95 A.  
 SHOULD BE IN CITY'S NAME

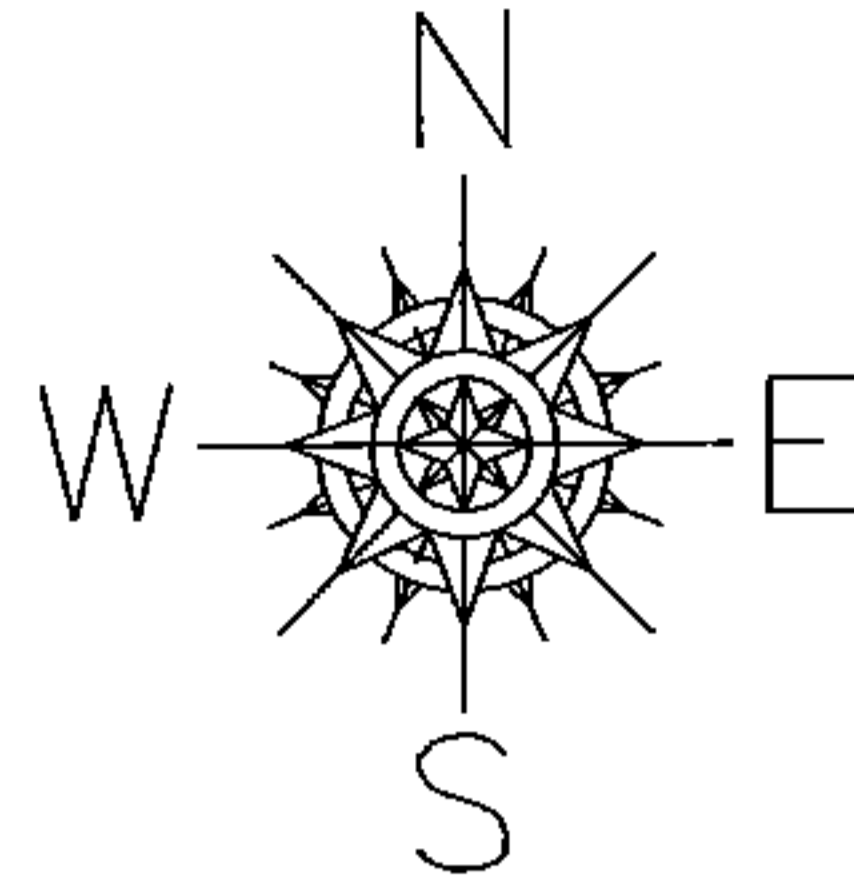

ADD TO DUPLICATE

06-25-030-900-002  
 3.95 A.  
 PER PV. 22 PG. 35

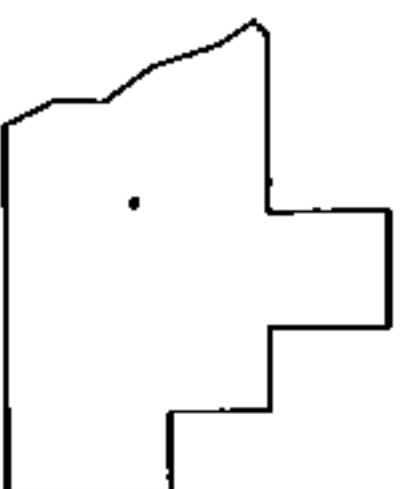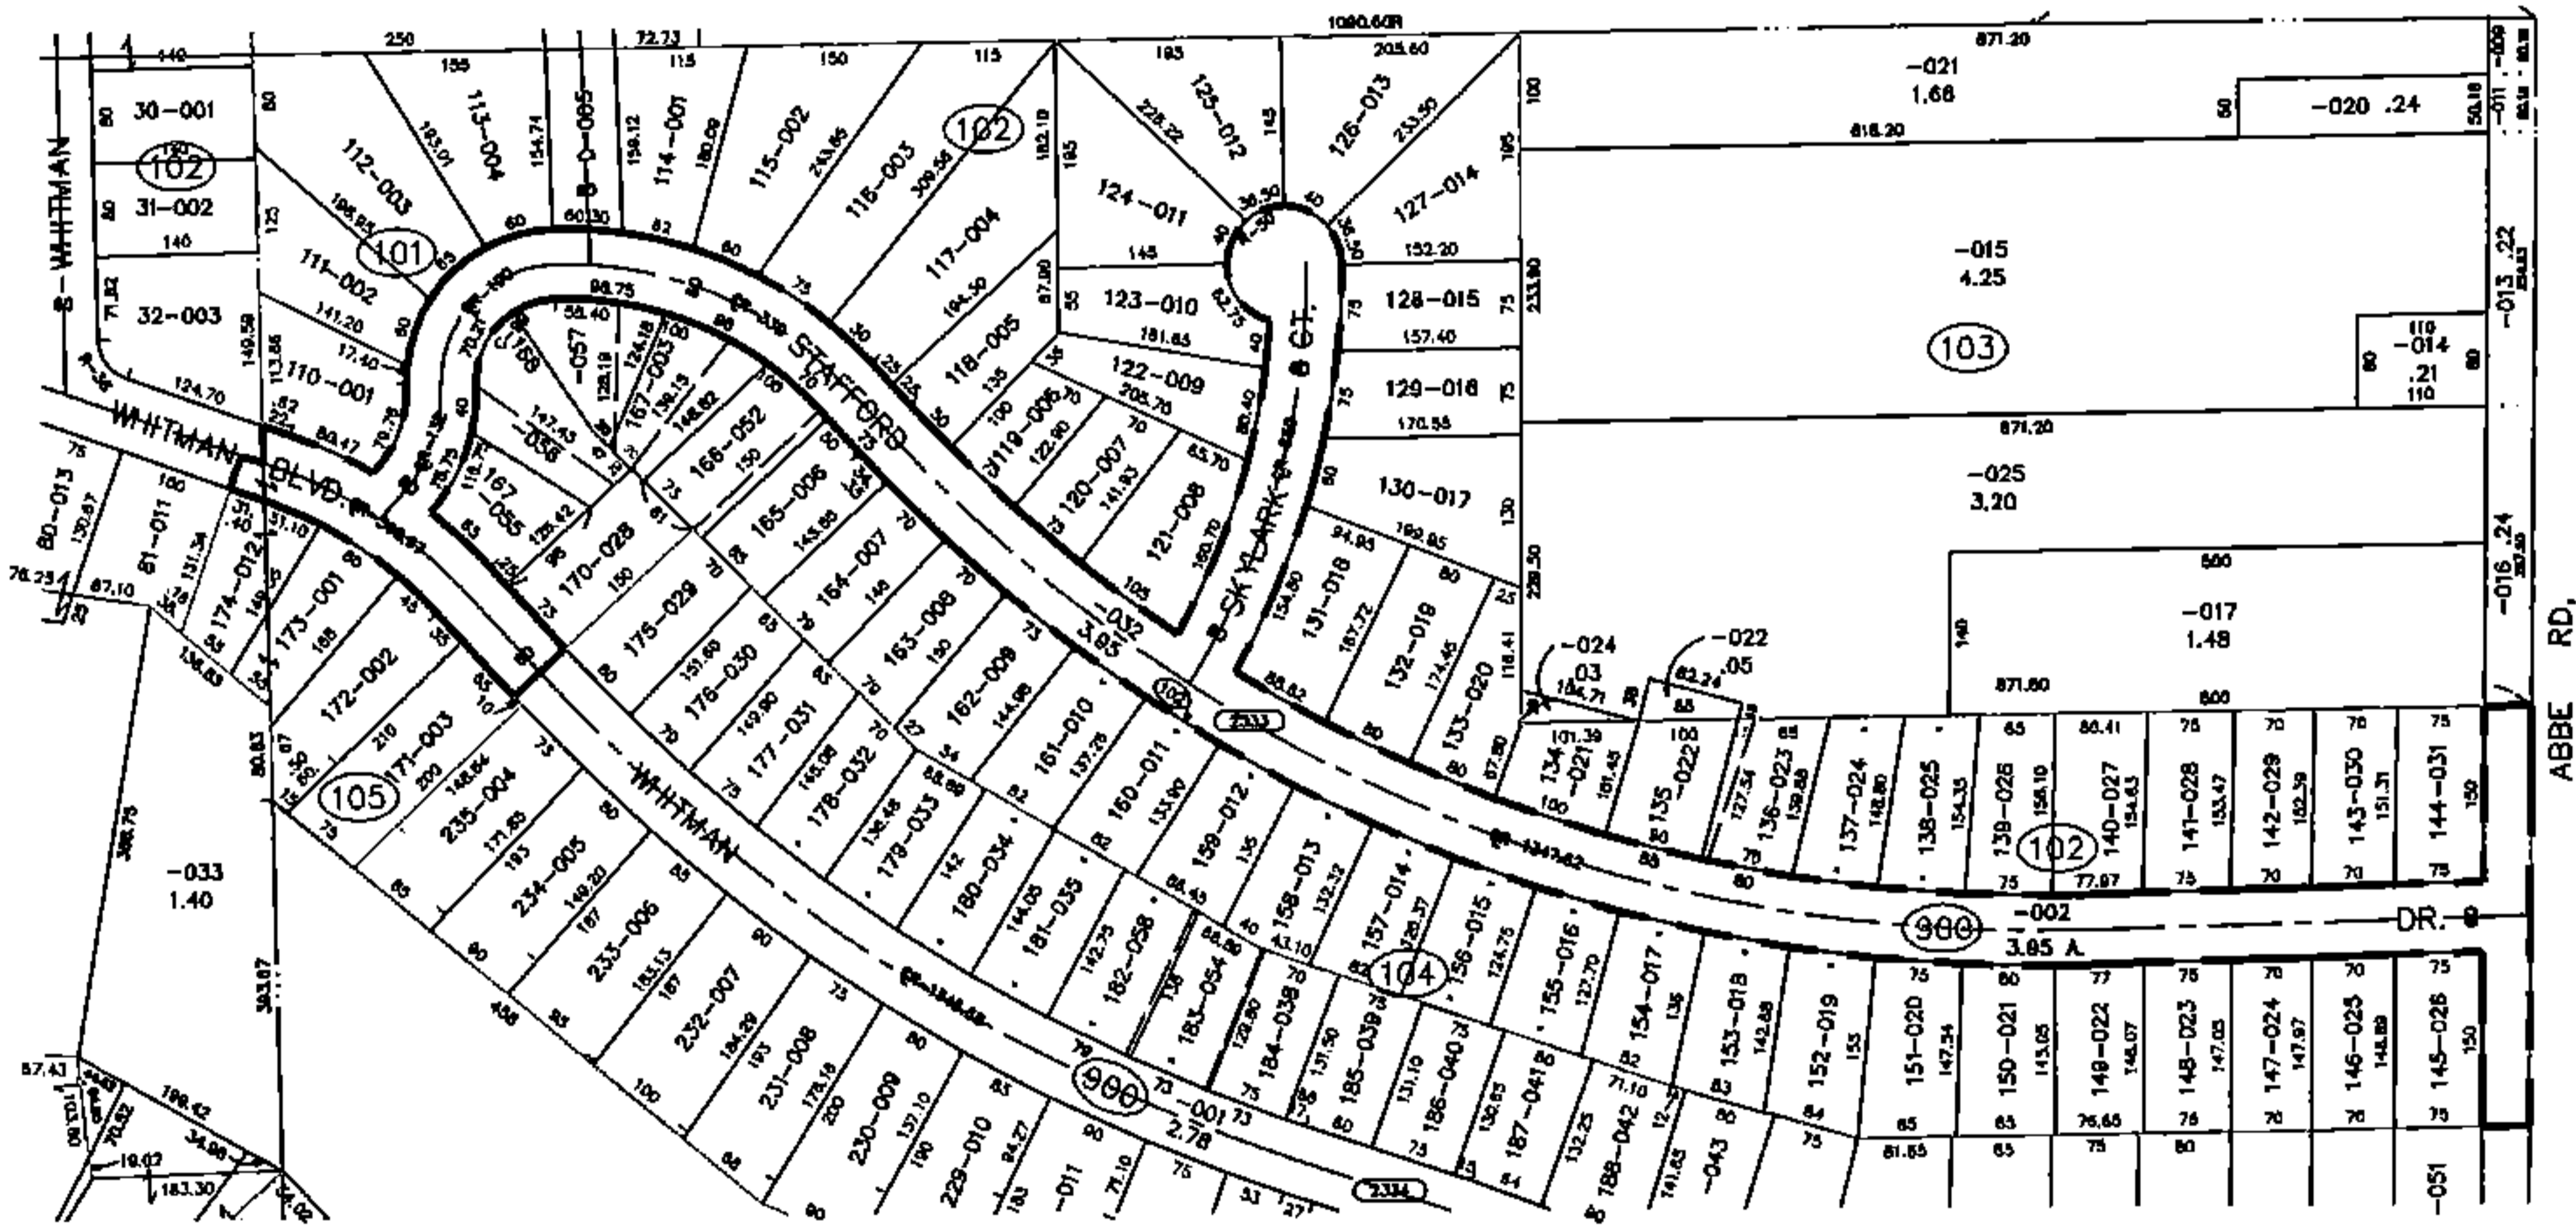

SPLITS/DEEDS PROCESSED  
 LORAIN COUNTY TAX MAP DEPARTMENT  
 226 MIDDLE AVE. ELYRIA, OHIO

SURVEYED BY: J. W. WARDEN  
 CLOSURE: NA  
 MAP PAGE(S): 06-25-030  
 APPROVED BY: TJS DATE: 1/22/15  
 SCALE: 1" = 300' PRIOR INSTRUMENT: DV XXXX/XXX