
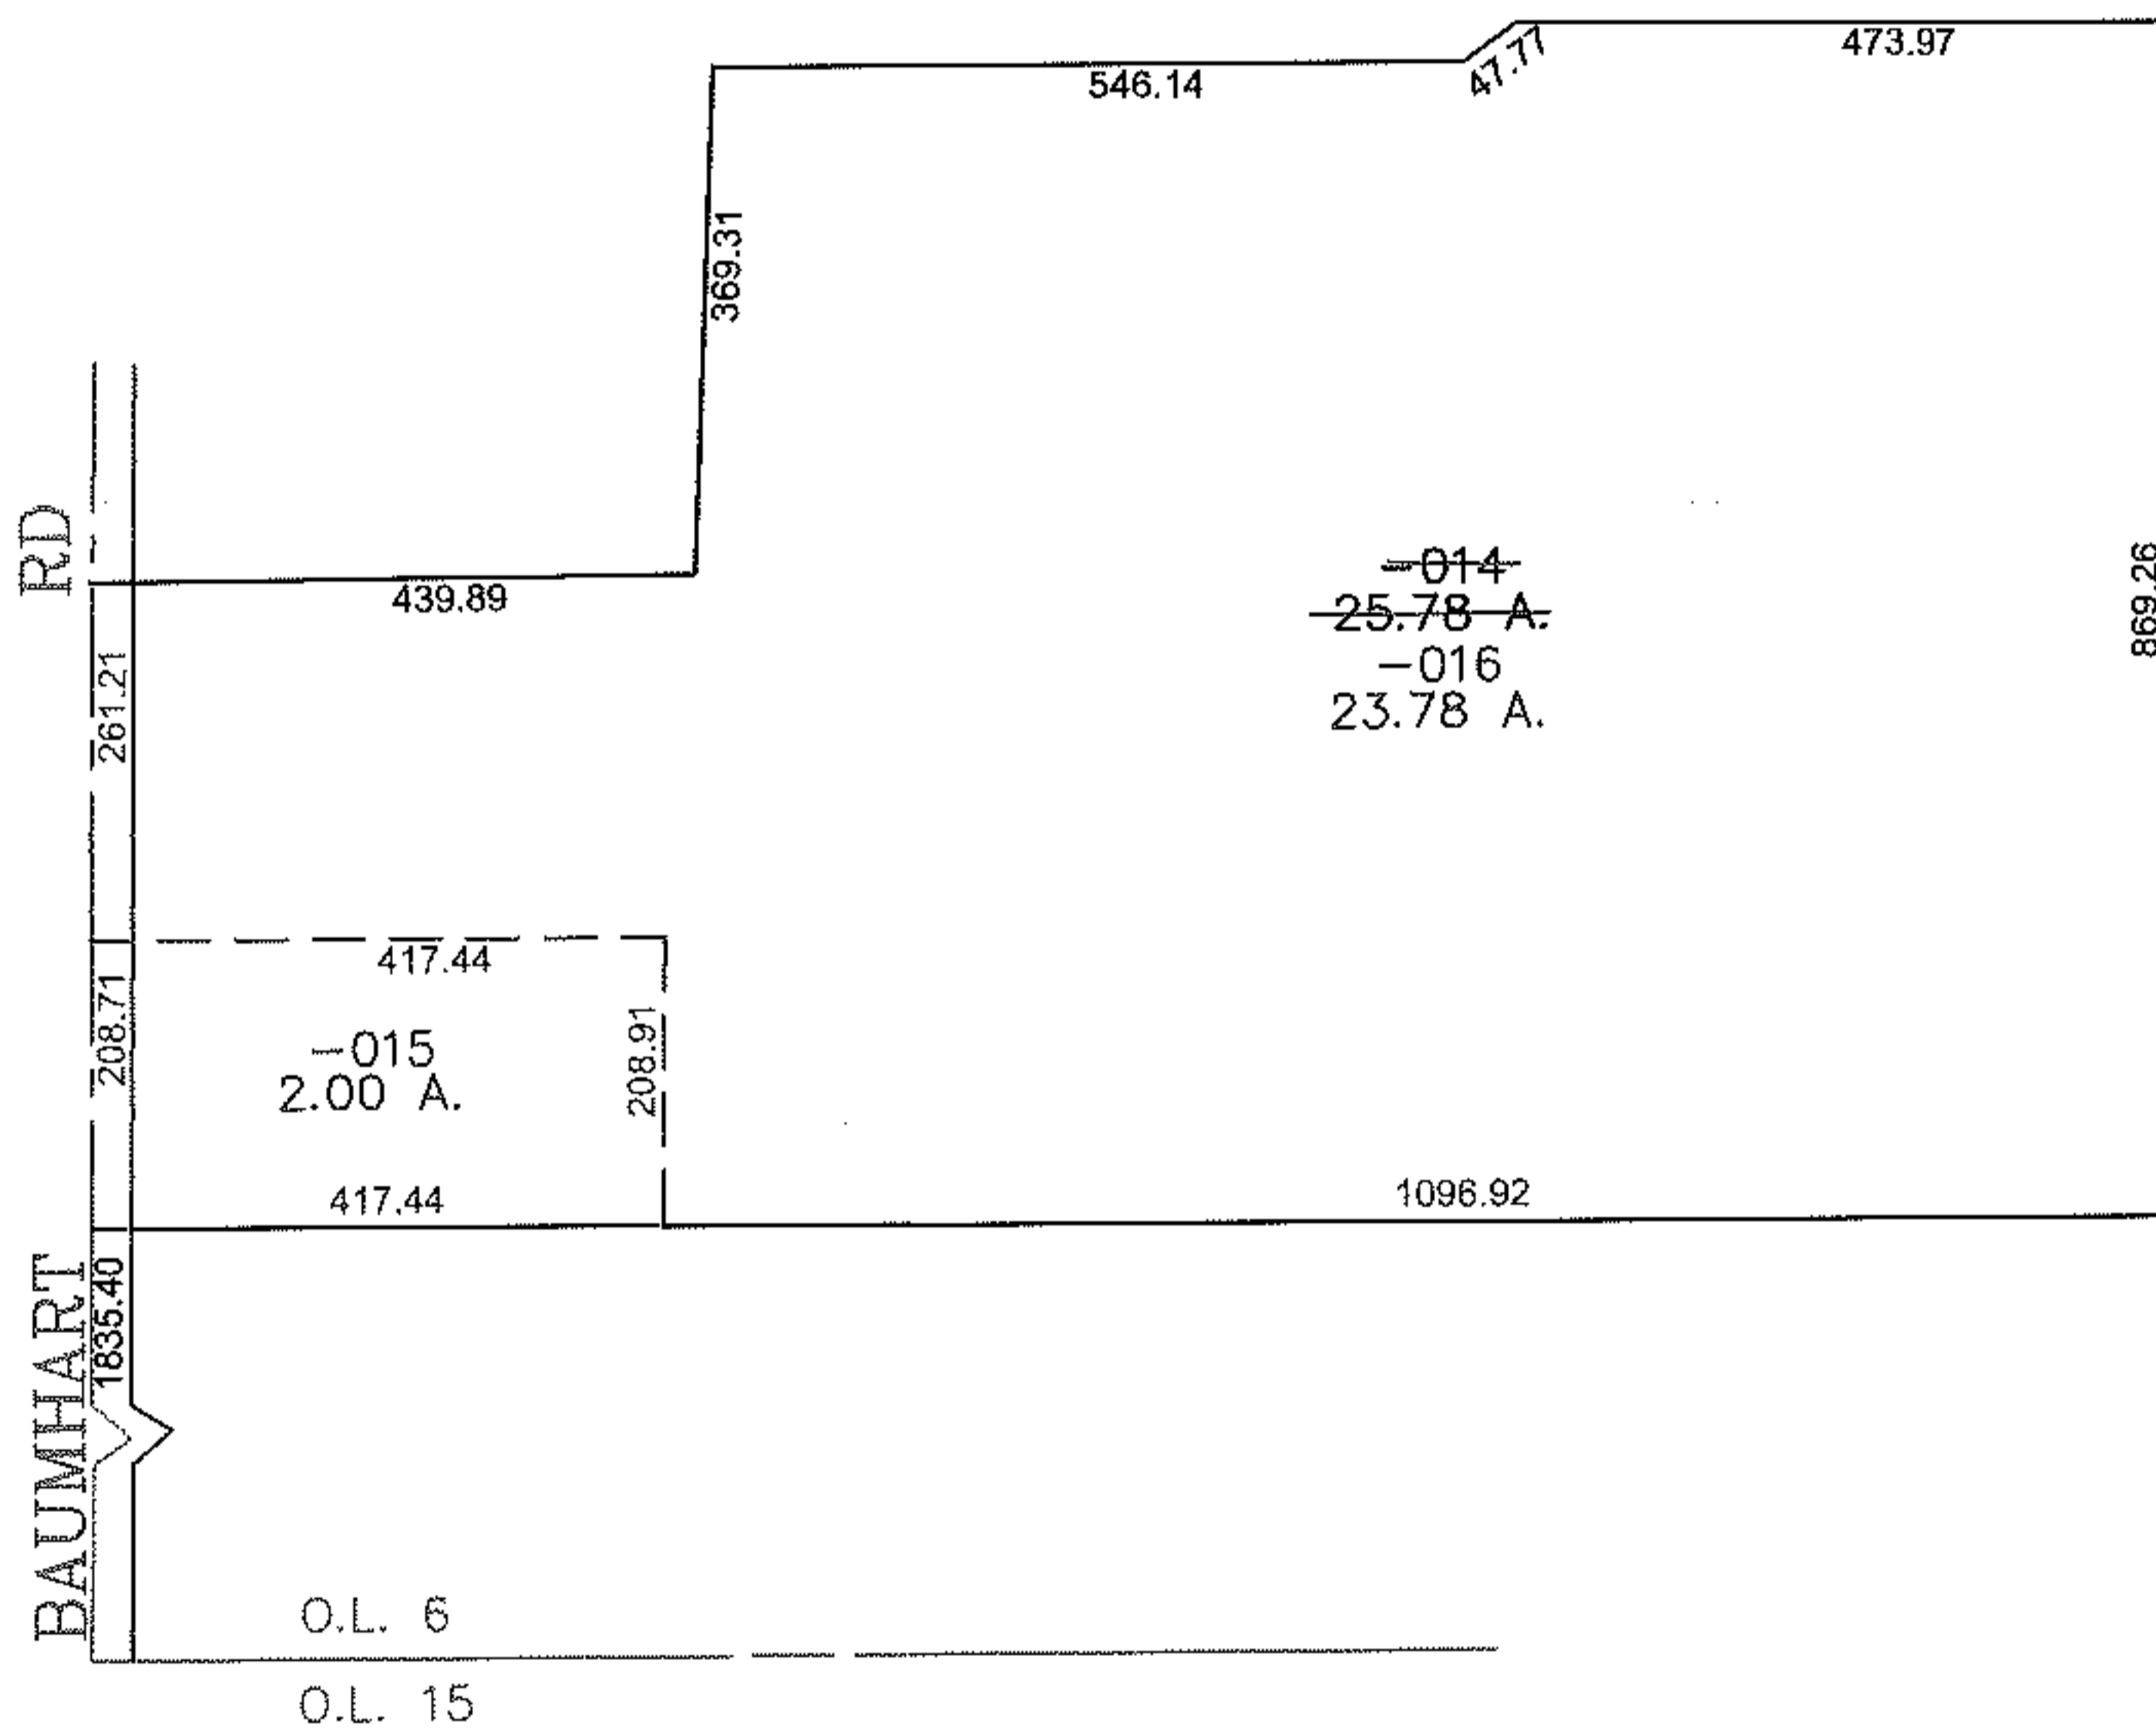


PARENT PARCEL: 08-15-005-000-014

CHILD PARCEL: 08-15-005-000-015, -016

STARTING POINT: CENTERLINE OF BAUMHART RD & O.L. 6

12-03098

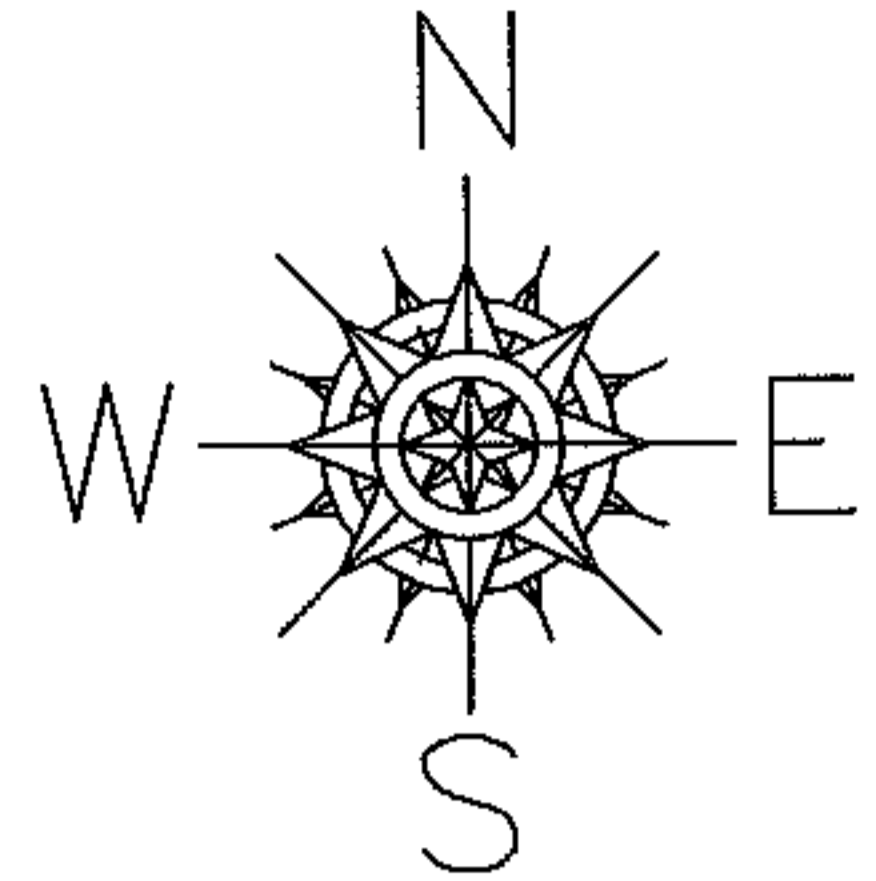

SPLITS/DEEDS PROCESSED

LORAIN COUNTY TAX MAP DEPARTMENT
226 MIDDLE AVE. ELYRIA, OHIO

SURVEYED BY: DALE HAYWOOD

CLOSURE: 0.00 : 10.000

MAP PAGE(S): 8-B

APPROVED BY: JAH DATE: 11/30/2012

SCALE: 1" = 300' PRIOR INSTRUMENT: 20120413717