
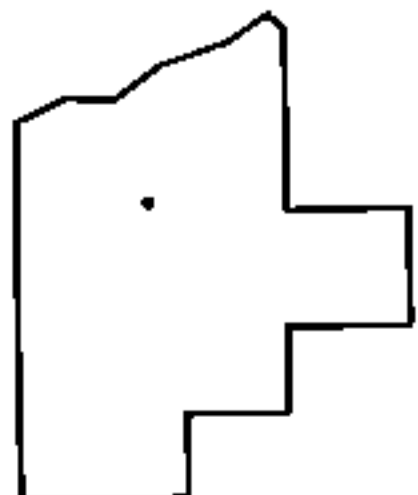
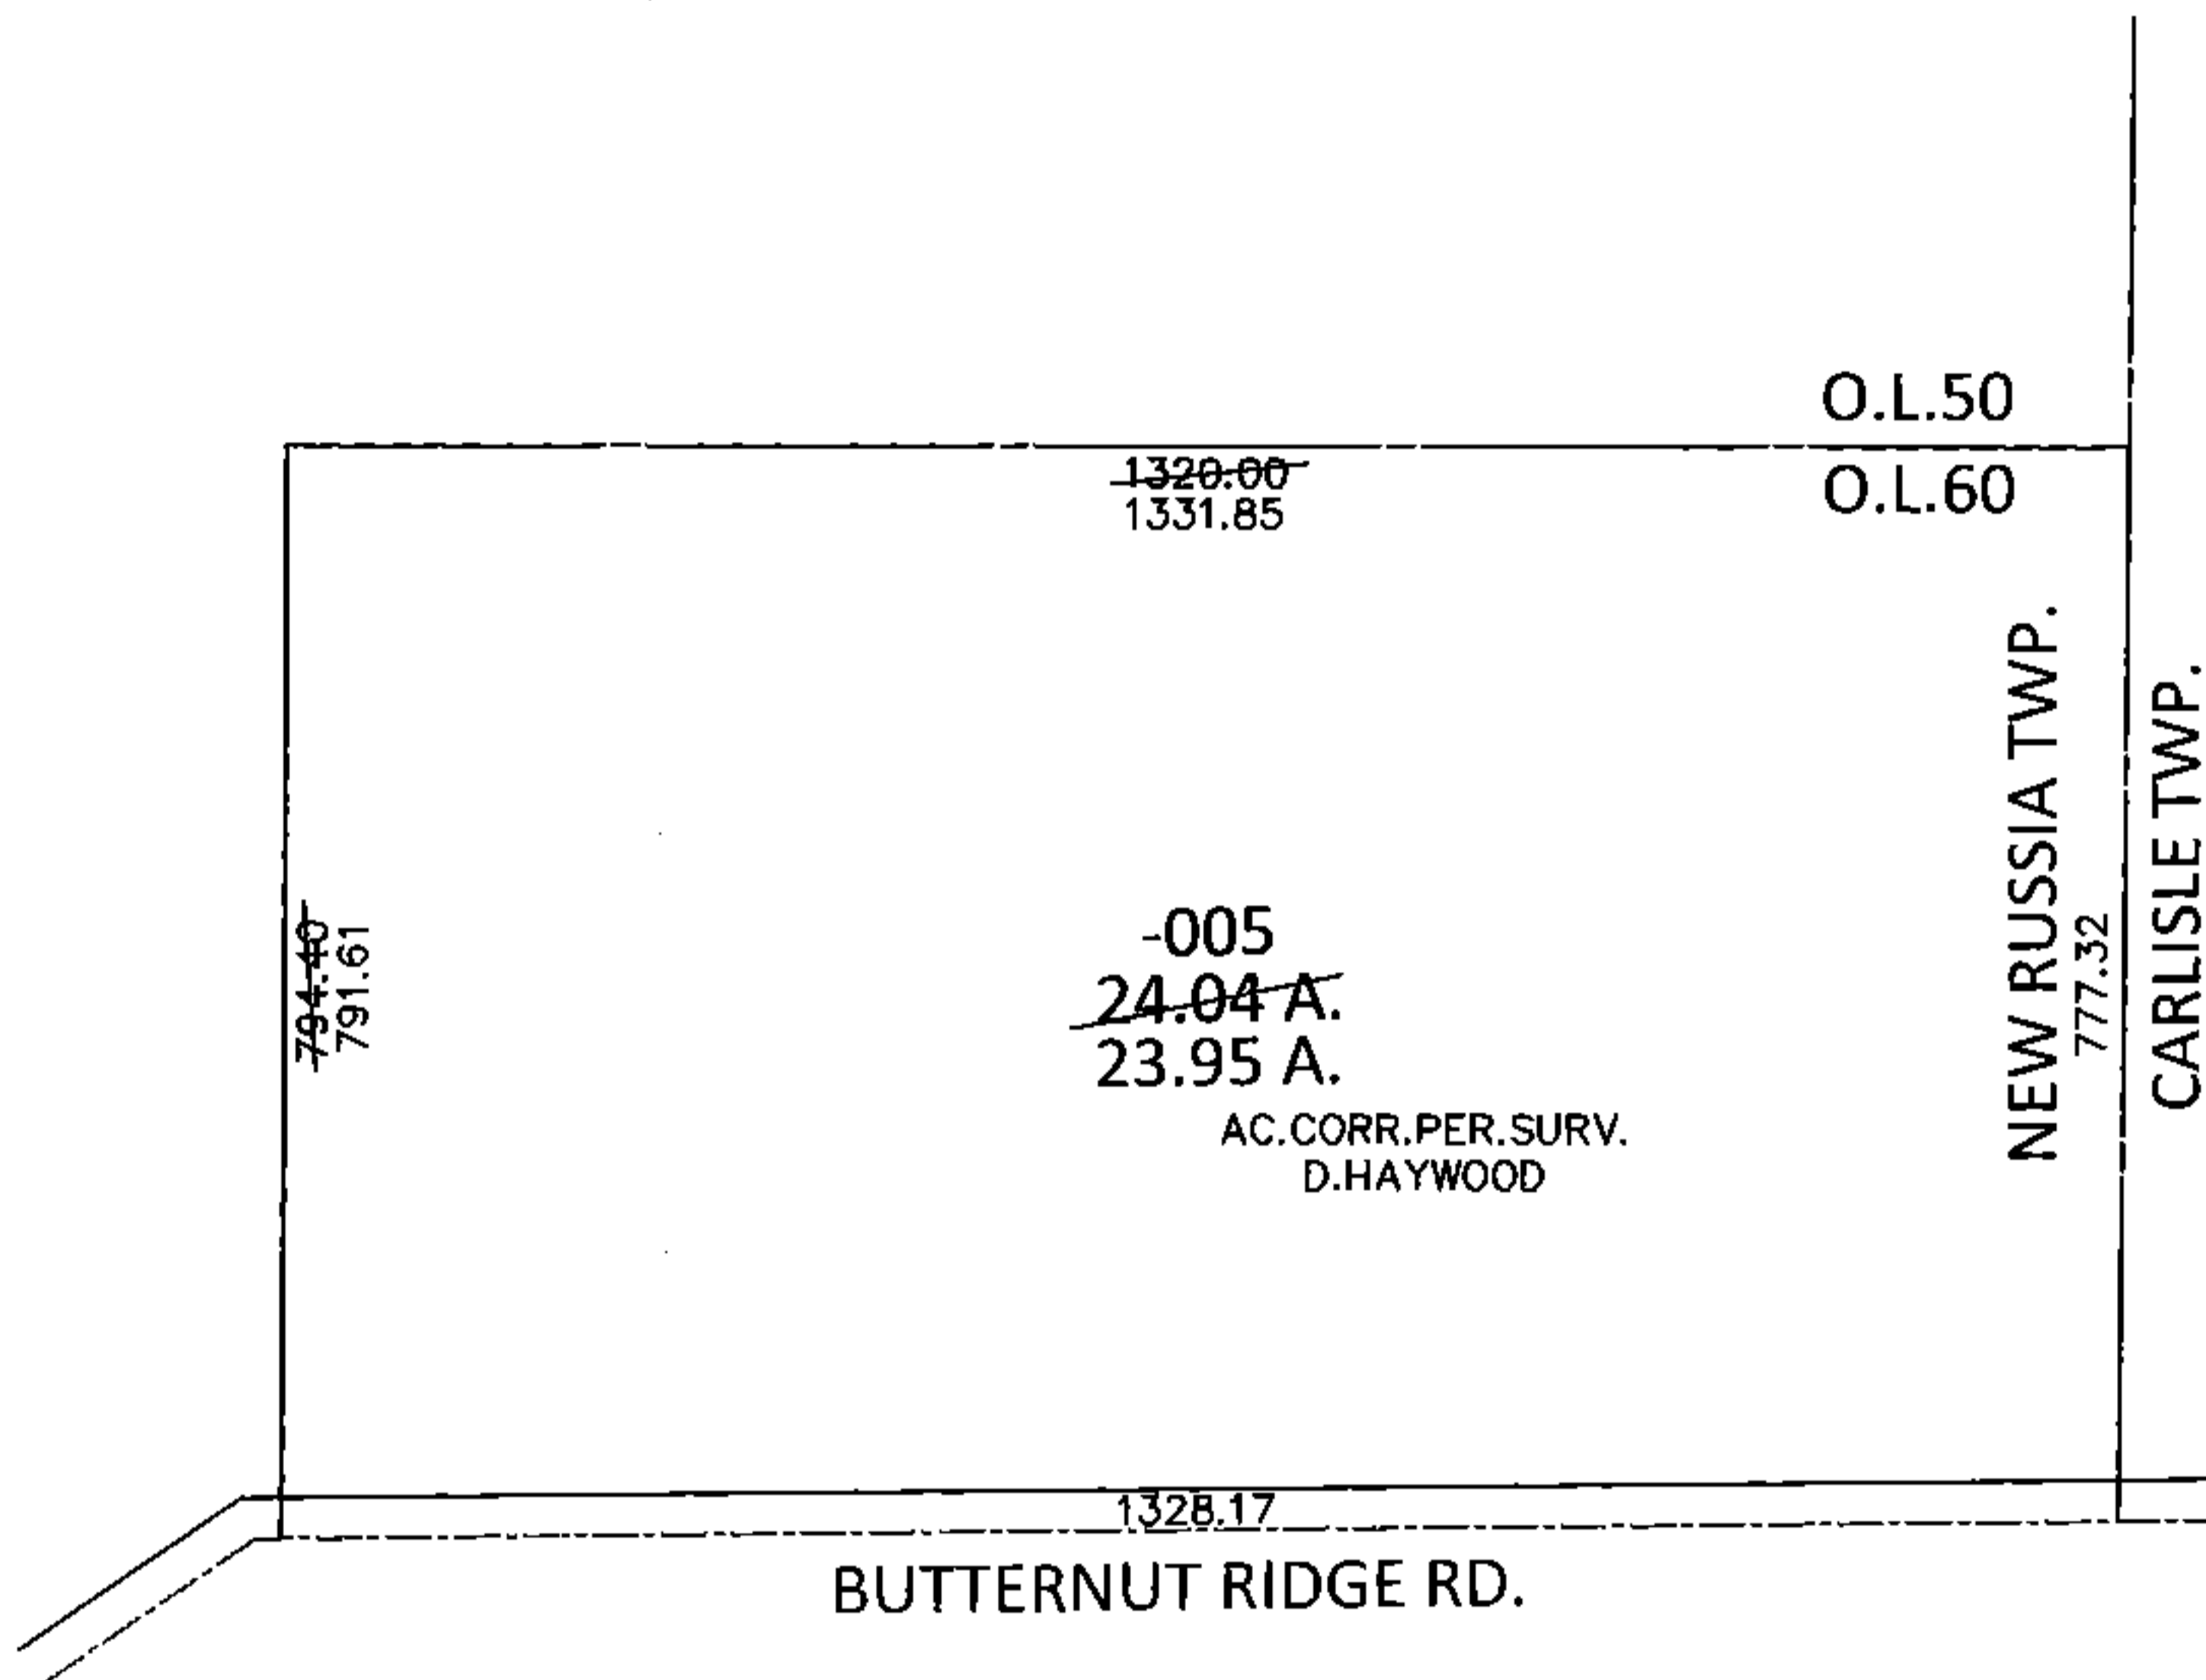


PARENT PARCEL: 09-00-060-000-005

CHILD PARCEL: \_\_\_\_\_

STARTING POINT: INTERSECTION OF C/L OF BUTTERNUT RIDGE RD. AND EAST LINE OF O.L.60

15-03100-A

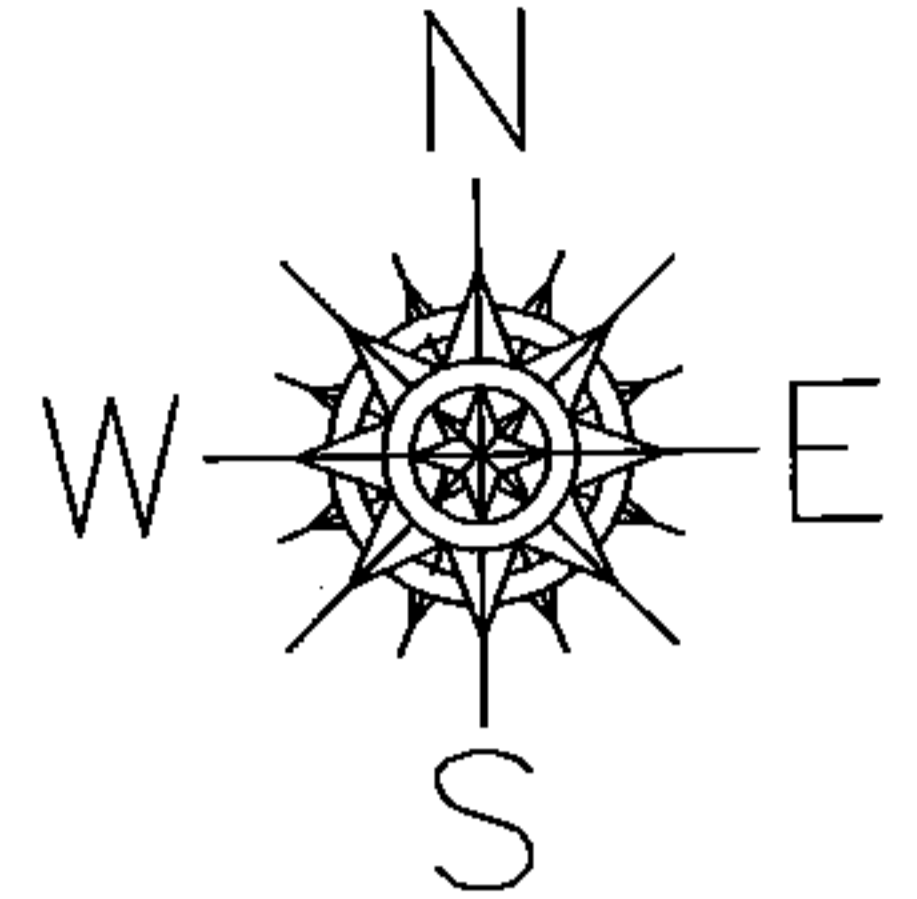

SPLITS/DEEDS PROCESSED

LORAIN COUNTY TAX MAP DEPARTMENT  
226 MIDDLE AVE. ELYRIA, OHIO

SURVEYED BY: DALE R. HAYWOOD

CLOSURE: .01:10,000

MAP PAGE(S): 9-H

APPROVED BY: RRM DATE: 1-26-15

SCALE: 1"=300 PRIOR INST.: 20050060696