




PARENT PARCEL: 03-00-075-113-004

CHILD PARCEL: 03-00-075-113-012, -013

12-03100

STARTING POINT: **SEE BELOW

**CENTERLINE OF WEST RIVER RD & O.L. 75 SHEFFIELD TWP & O.L. 12 BURRELL & DAY TRACT ELYRIA

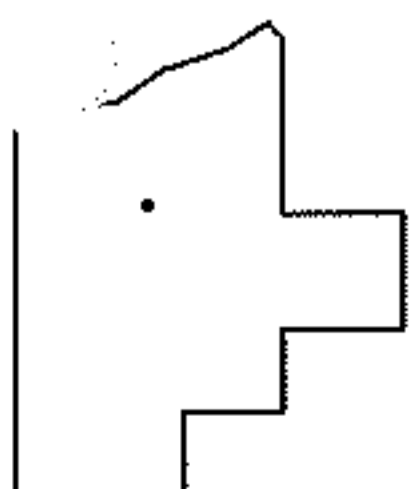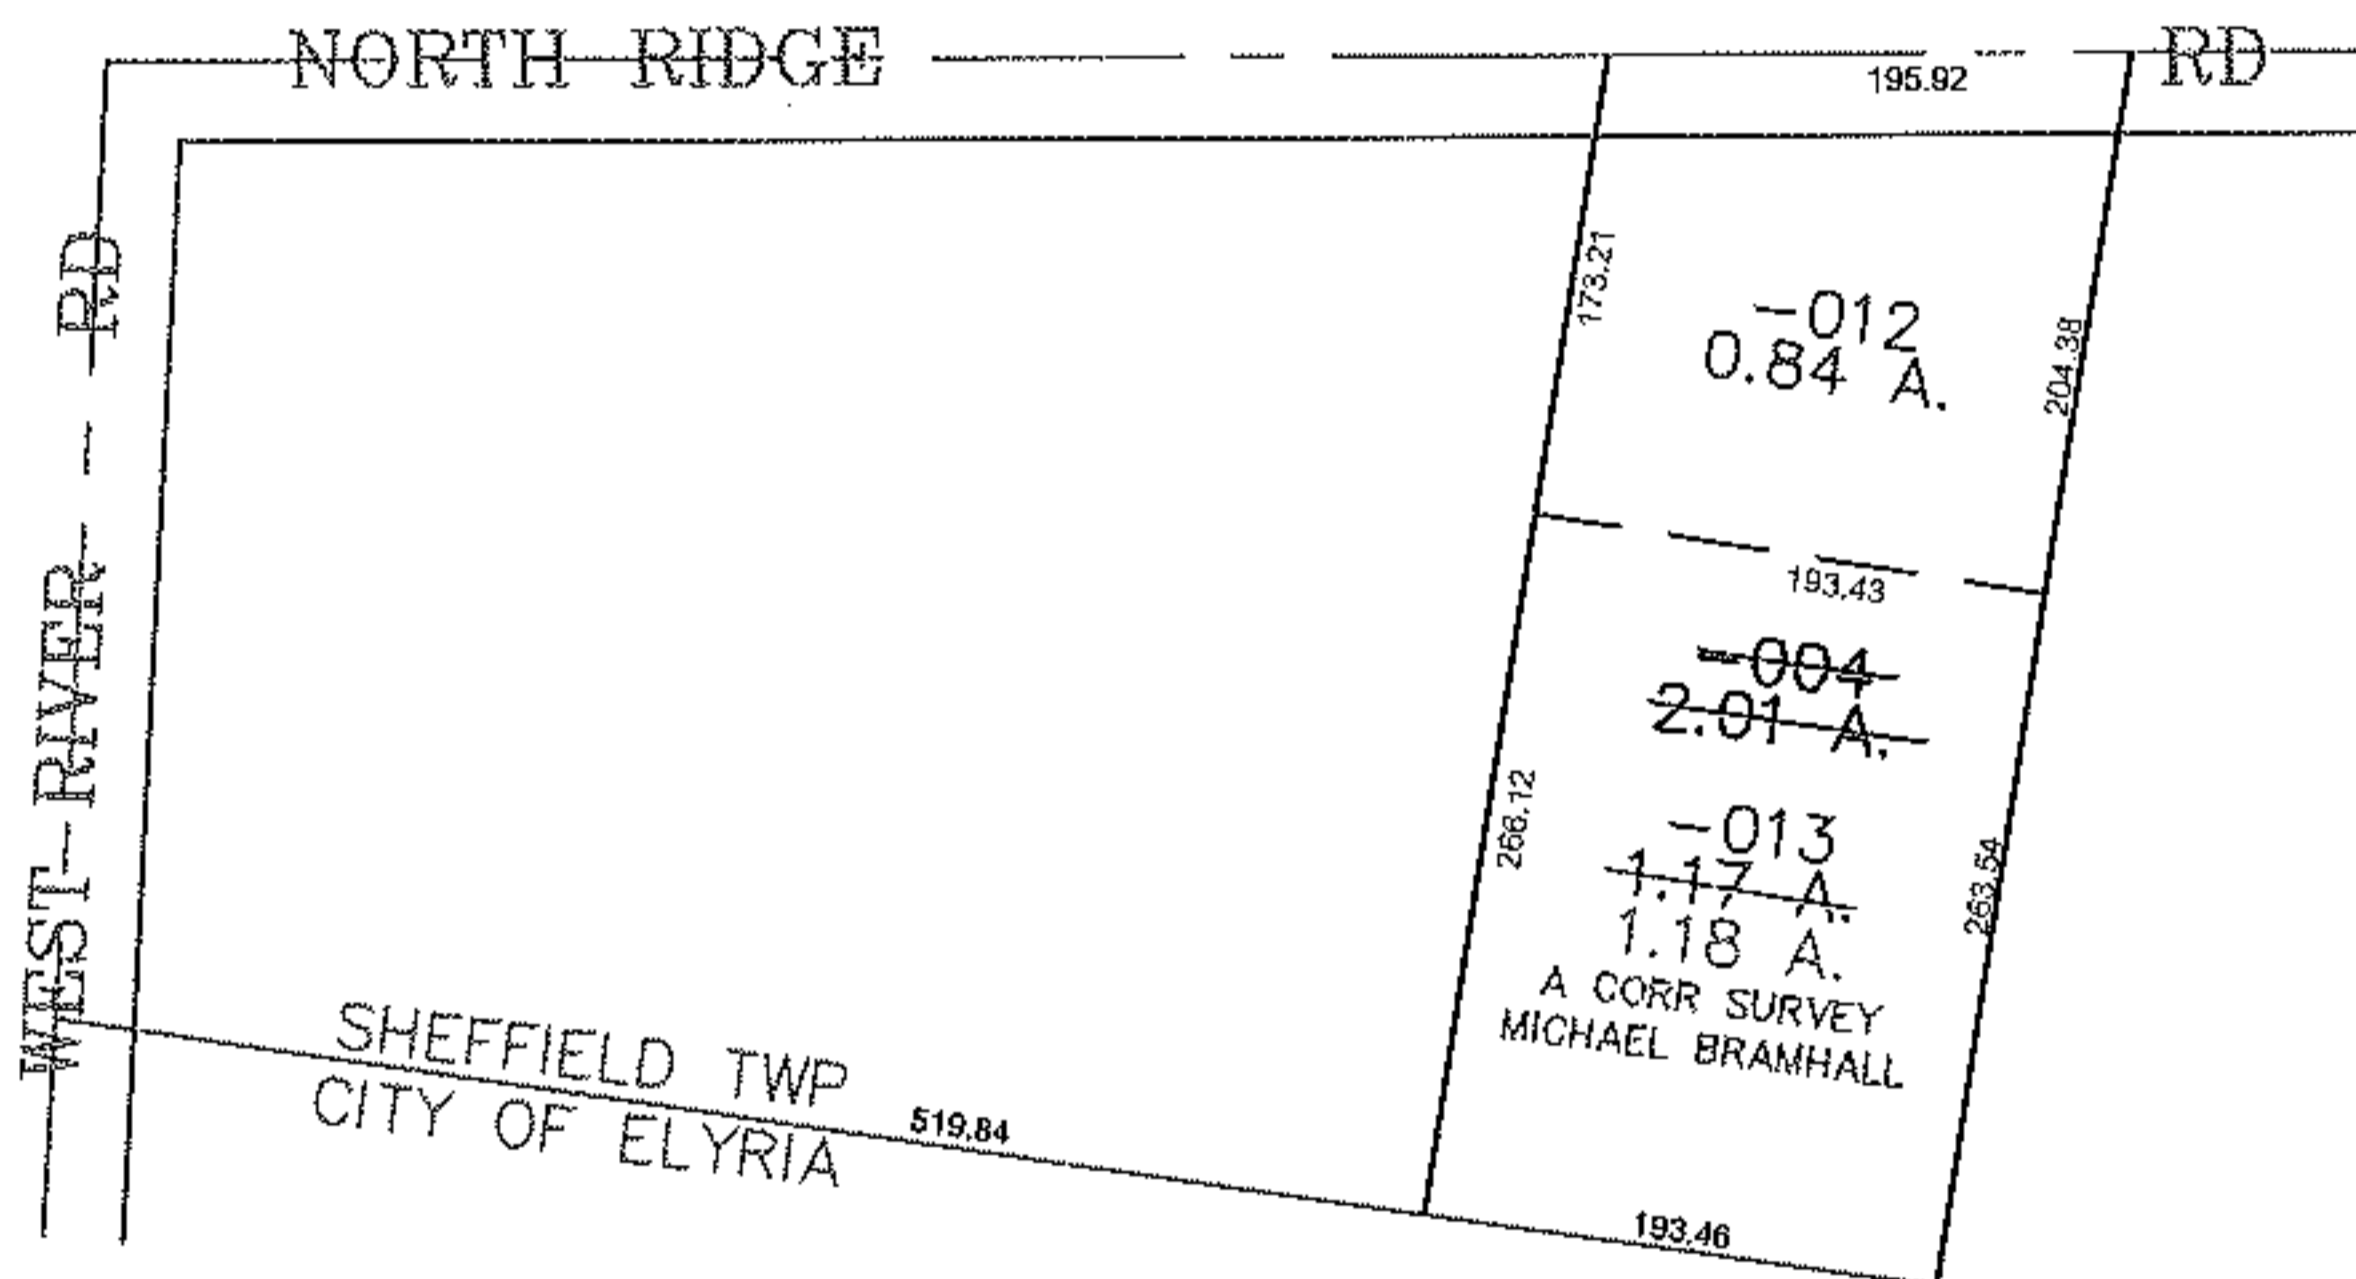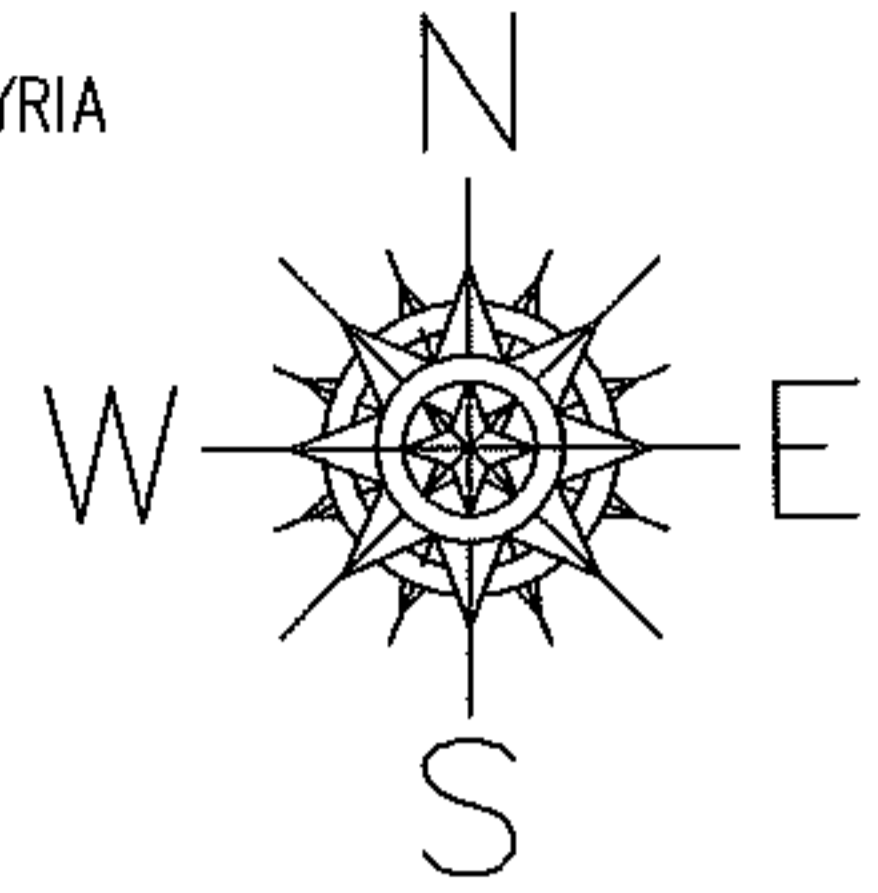

SPLITS/DEEDS PROCESSED
LORAIN COUNTY TAX MAP DEPARTMENT
226 MIDDLE AVE. ELYRIA, OHIO

SURVEYED BY: MICHAEL BRAMHALL
 CLOSURE: 0.00 : 10,000
 MAP PAGE(S): 03-00-075-A
 APPROVED BY: JAH DATE: 12/4/2012
 SCALE: 1" = 200 PRIOR INSTRUMENT: 20070202030