

PARENT PARCEL: 07-00-004-106-003

CHILD PARCEL: 07-00-004-900-002

STARTING POINT: PLAT VOL. 21 PG. 6




15-03102-C

DROP FROM DUPLICATE

07-00-004-106-003
0.68 A.

ADD TO DUPLICATE

07-00-004-900-002
0.68 A.
PER PV. 21 PG. 6

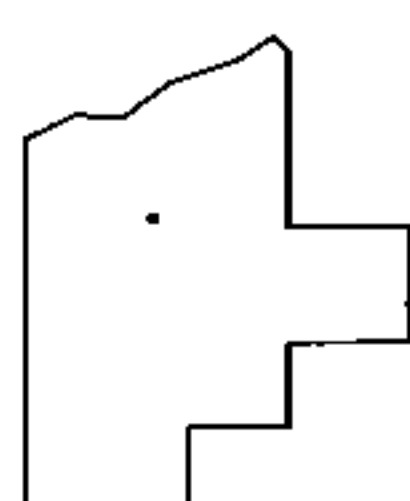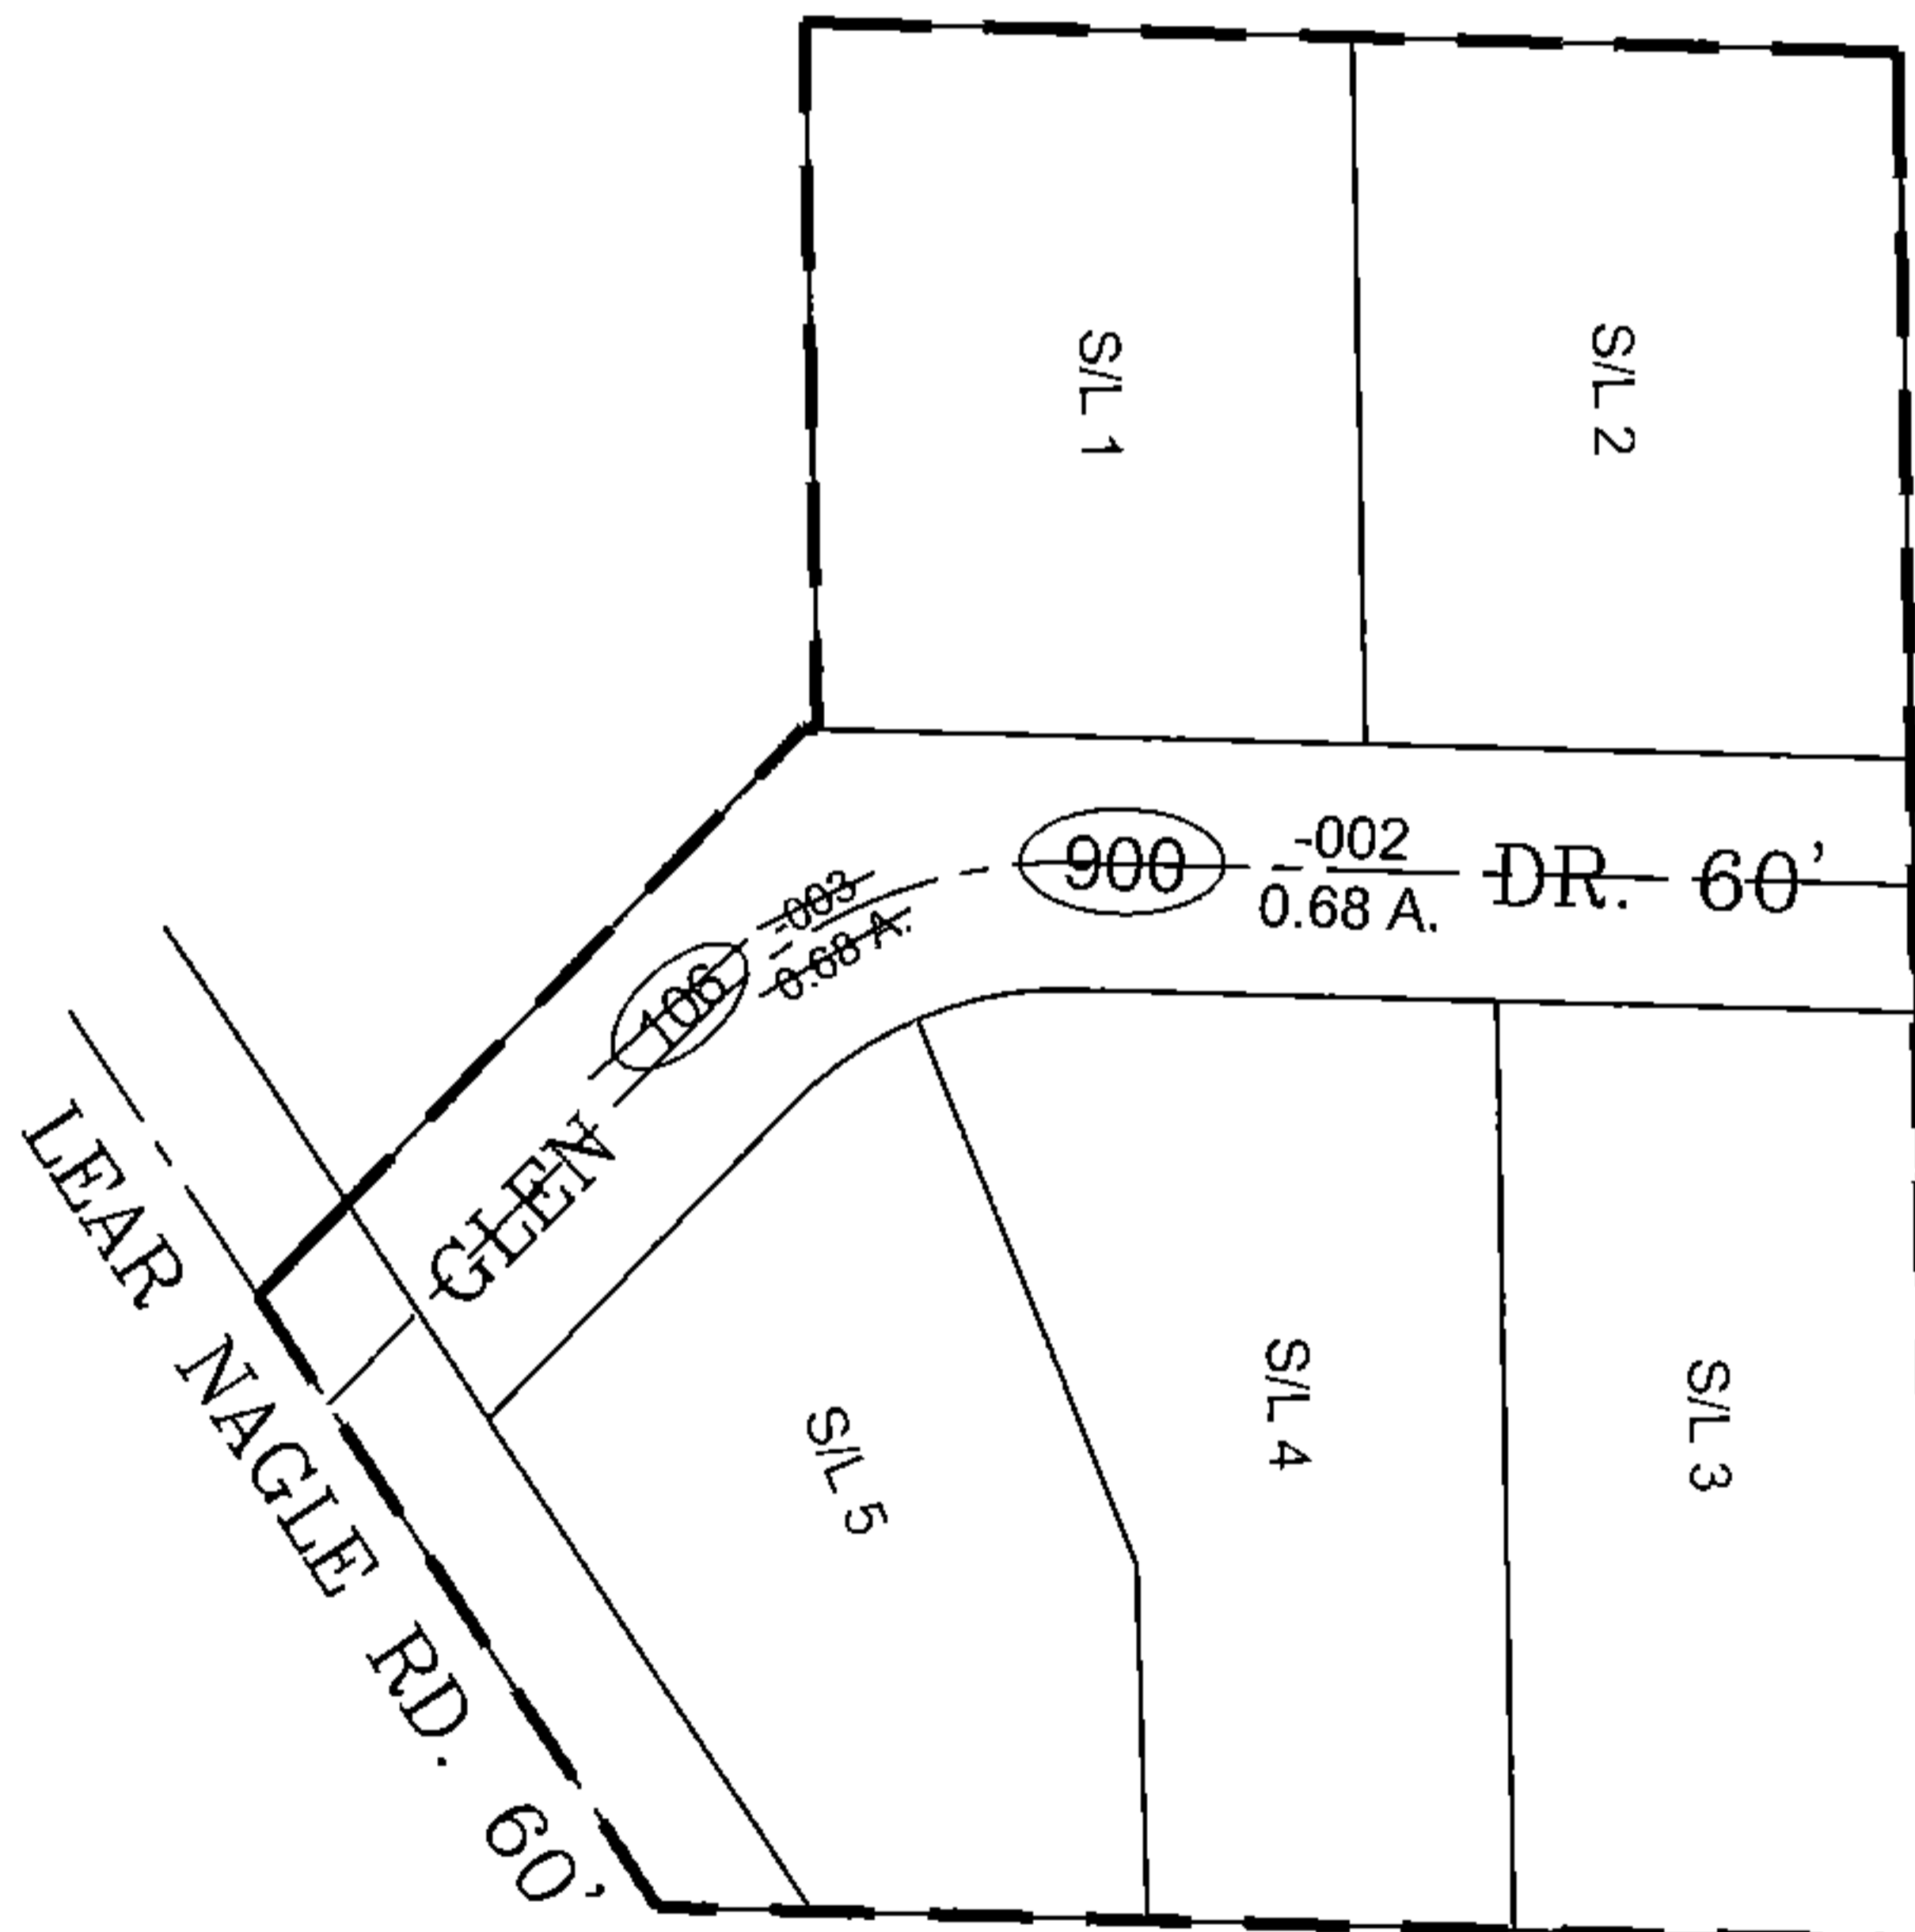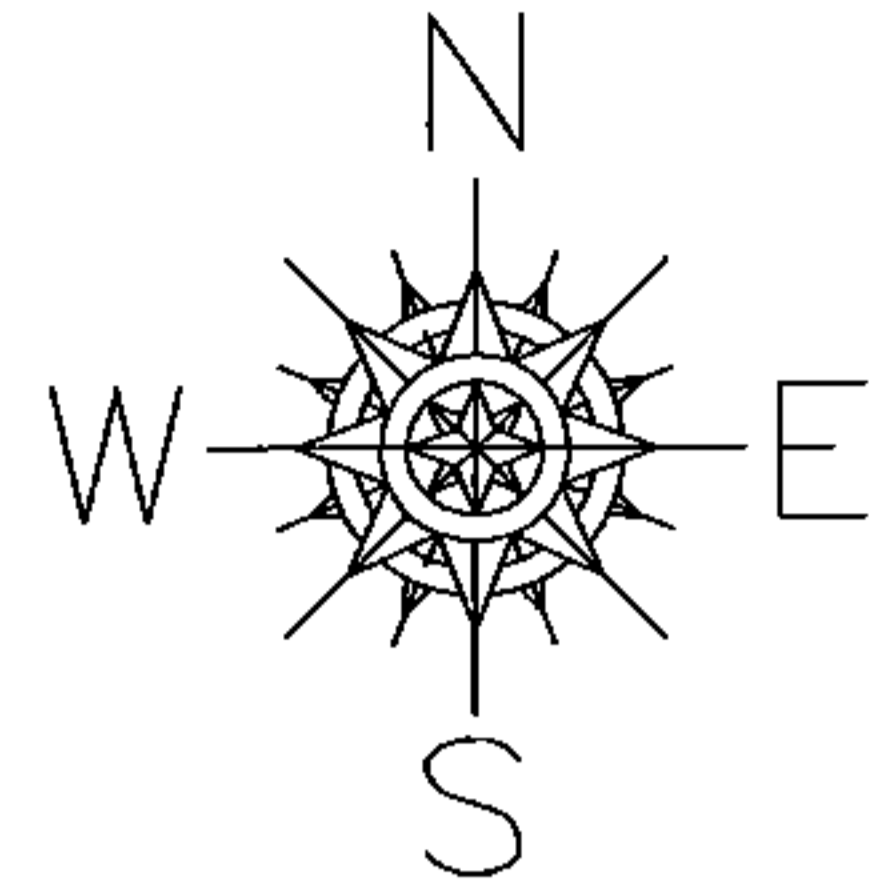

SPLITS/DEEDS PROCESSED

LORAIN COUNTY TAX MAP DEPARTMENT
226 MIDDLE AVE. ELYRIA, OHIO

SURVEYED BY: J.H. GETZ
CLOSURE: NA
MAP PAGE(S): 07-00-004
APPROVED BY: TJS DATE: 1/27/15
SCALE: 1" = 100' PRIOR INSTRUMENT: DV XXXX/XXX