
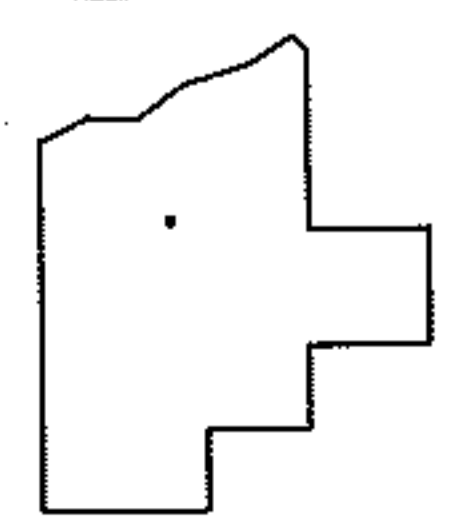
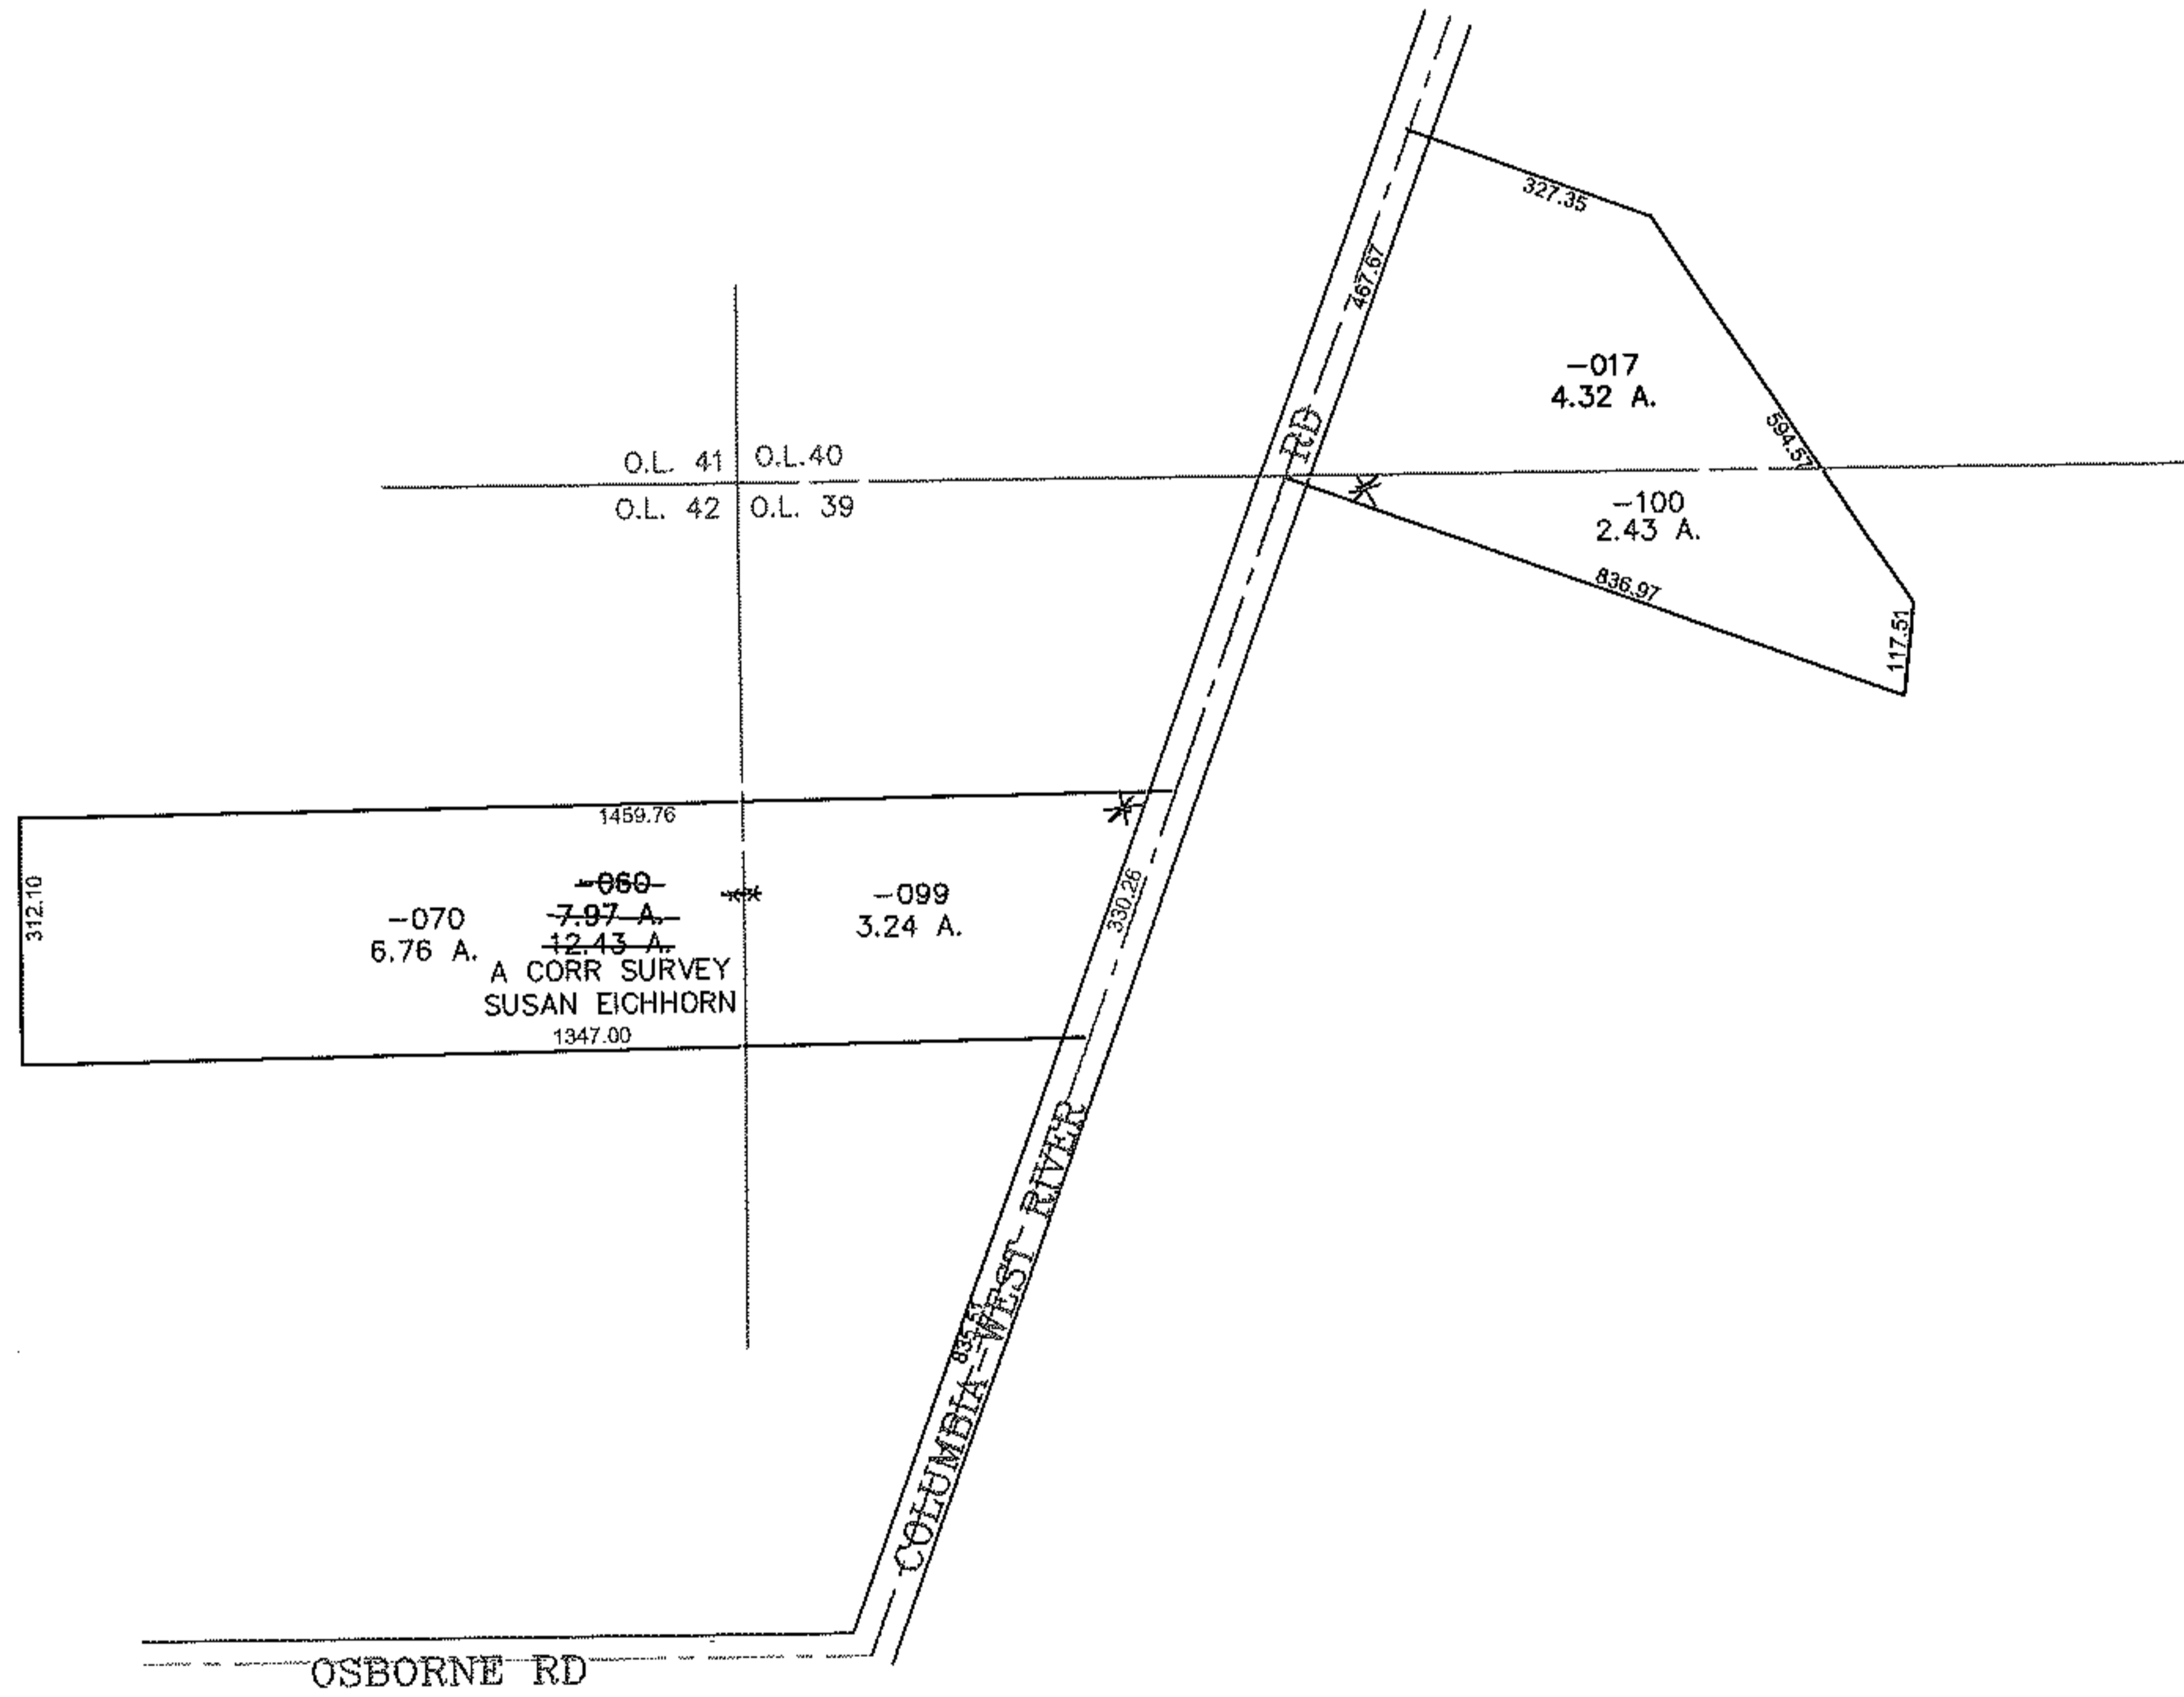


PARENT PARCEL: 12-00-042-000-060, 12-00-040-102-017 (ST)
 CHILD PARCEL: 12-00-042-000-070, 12-00-039-000-099, -100
 STARTING POINT: CENTERLINE OF OSBORNE RD & COLUMBIA-WEST RIVER RD

12-03102

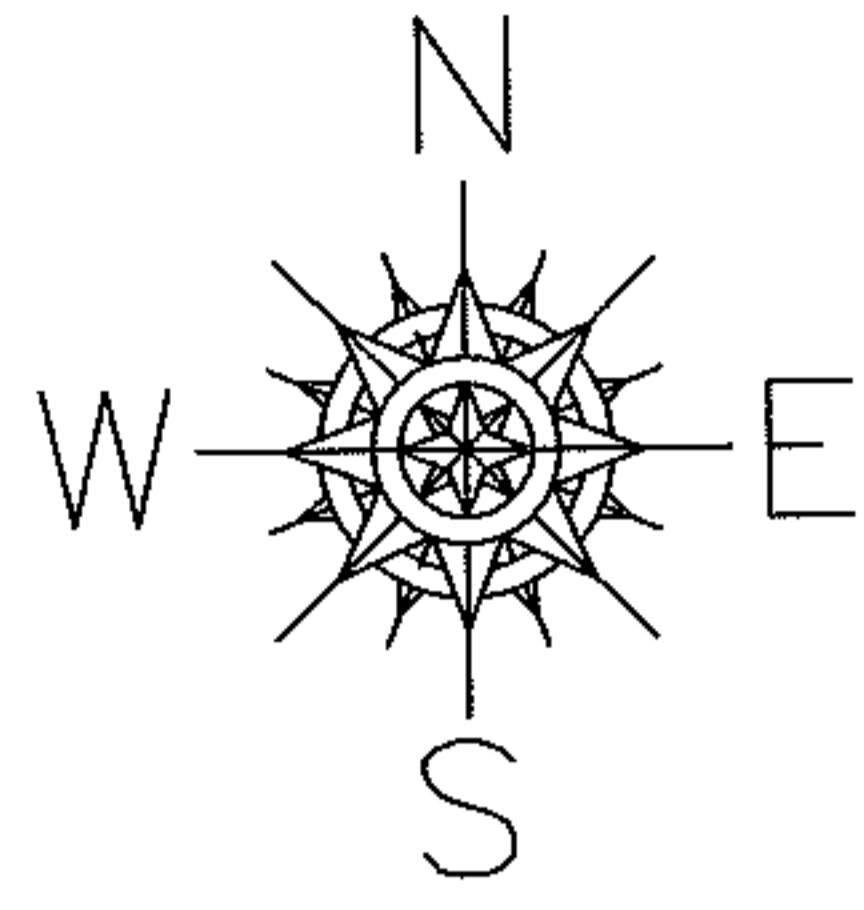

SPLITS/DEEDS PROCESSED
 LORAIN COUNTY TAX MAP DEPARTMENT
 226 MIDDLE AVE. ELYRIA, OHIO

SURVEYED BY: SUSAN EICHHORN
 CLOSURE: 0.00 : 10,000
 MAP PAGE(S): 12-00-040-A
 APPROVED BY: JAH DATE: 12/5/2012
 SCALE: 1" = 400 PRIOR INST.: 20070207889