
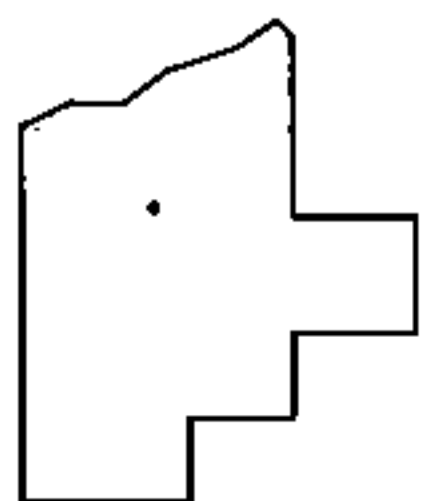
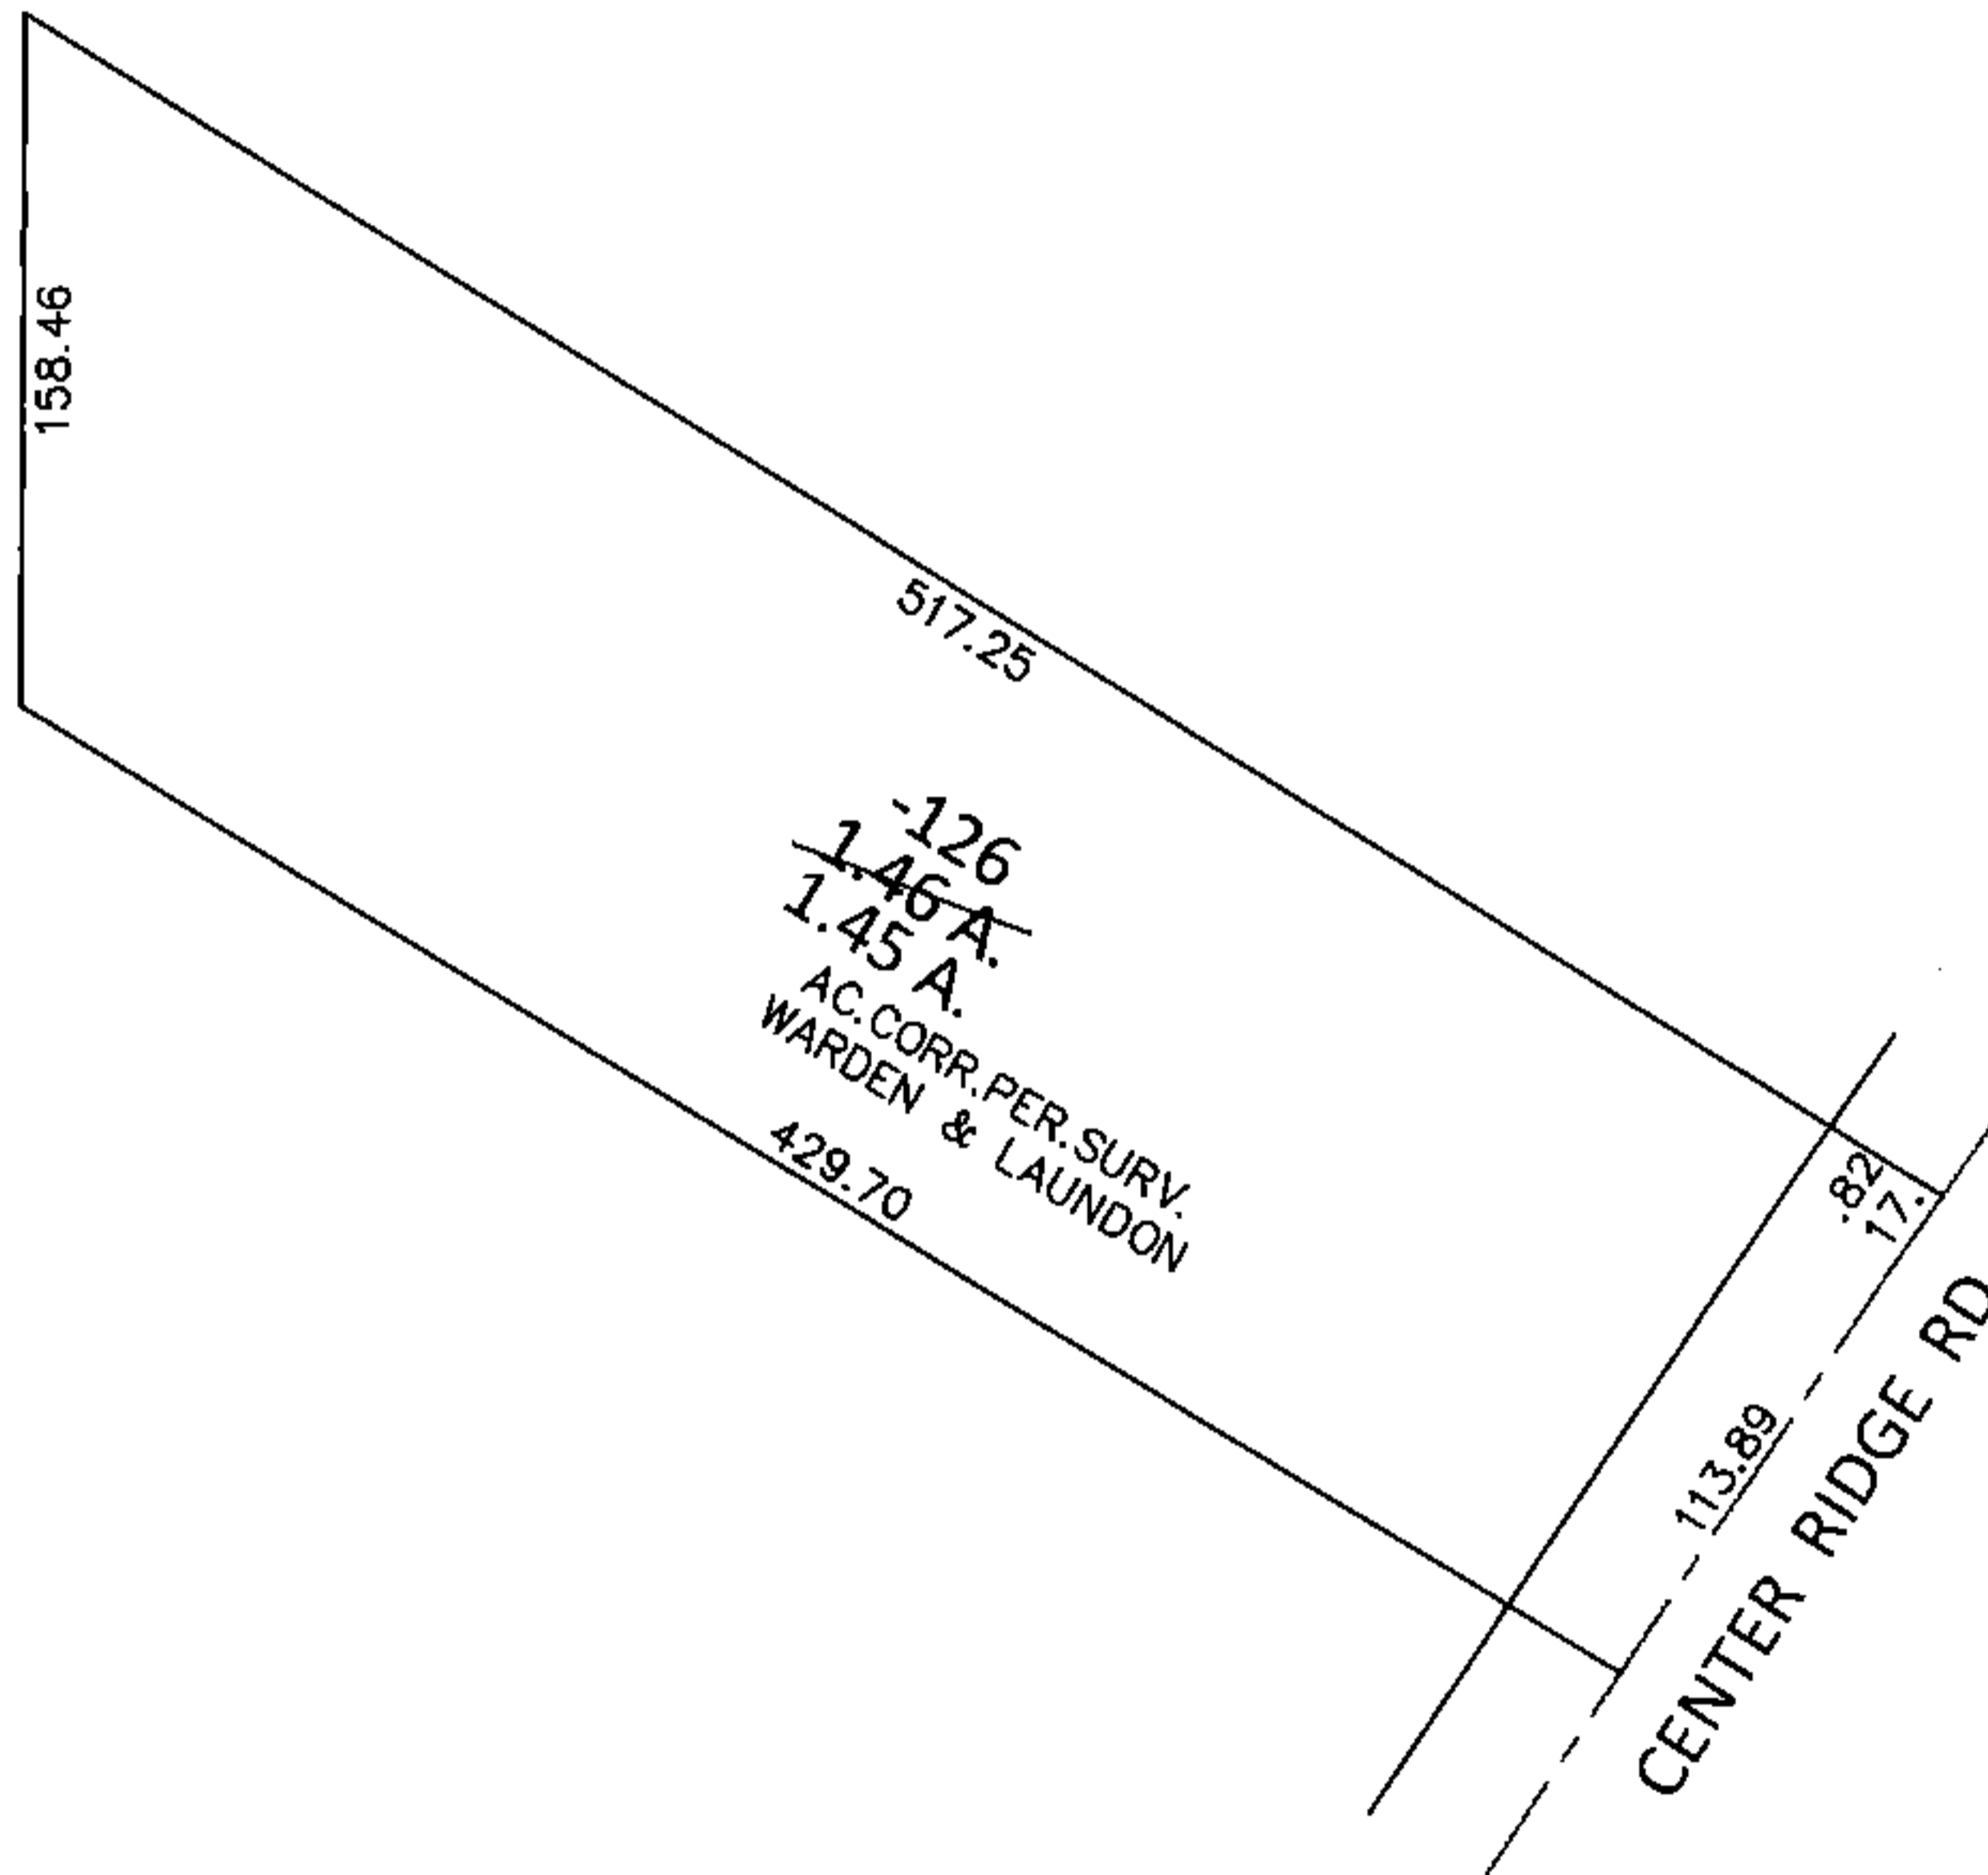


PARENT PARCEL: 07-00-006-102-126

CHILD PARCEL: _____

STARTING POINT: MOST EASTERLY CORNER OF LAND CONVEYED TO ADRIAN BEEBE (COURT RECORD VOL. 26 PG.446)

15-03104-A

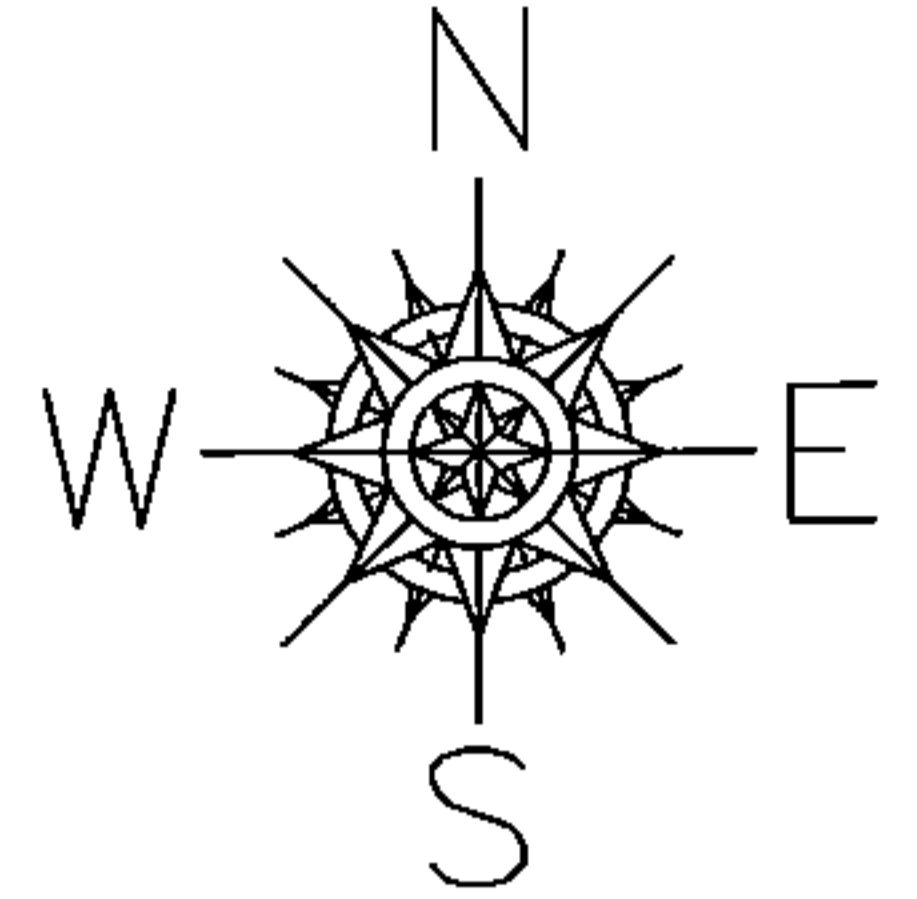

SPLITS/DEEDS PROCESSED

LORAIN COUNTY TAX MAP DEPARTMENT

226 MIDDLE AVE. ELYRIA, OHIO

SURVEYED BY: WARDEN & LAUNDON

CLOSURE: _____

MAP PAGE(S): 7-00-006-A

APPROVED BY: RRM DATE: 2-3-15

SCALE: 1"= 100 PRIOR INST.: 20100346113