
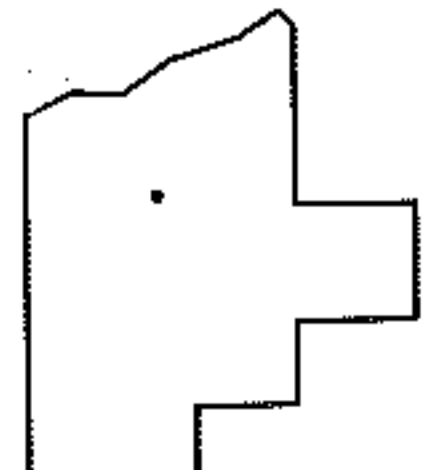
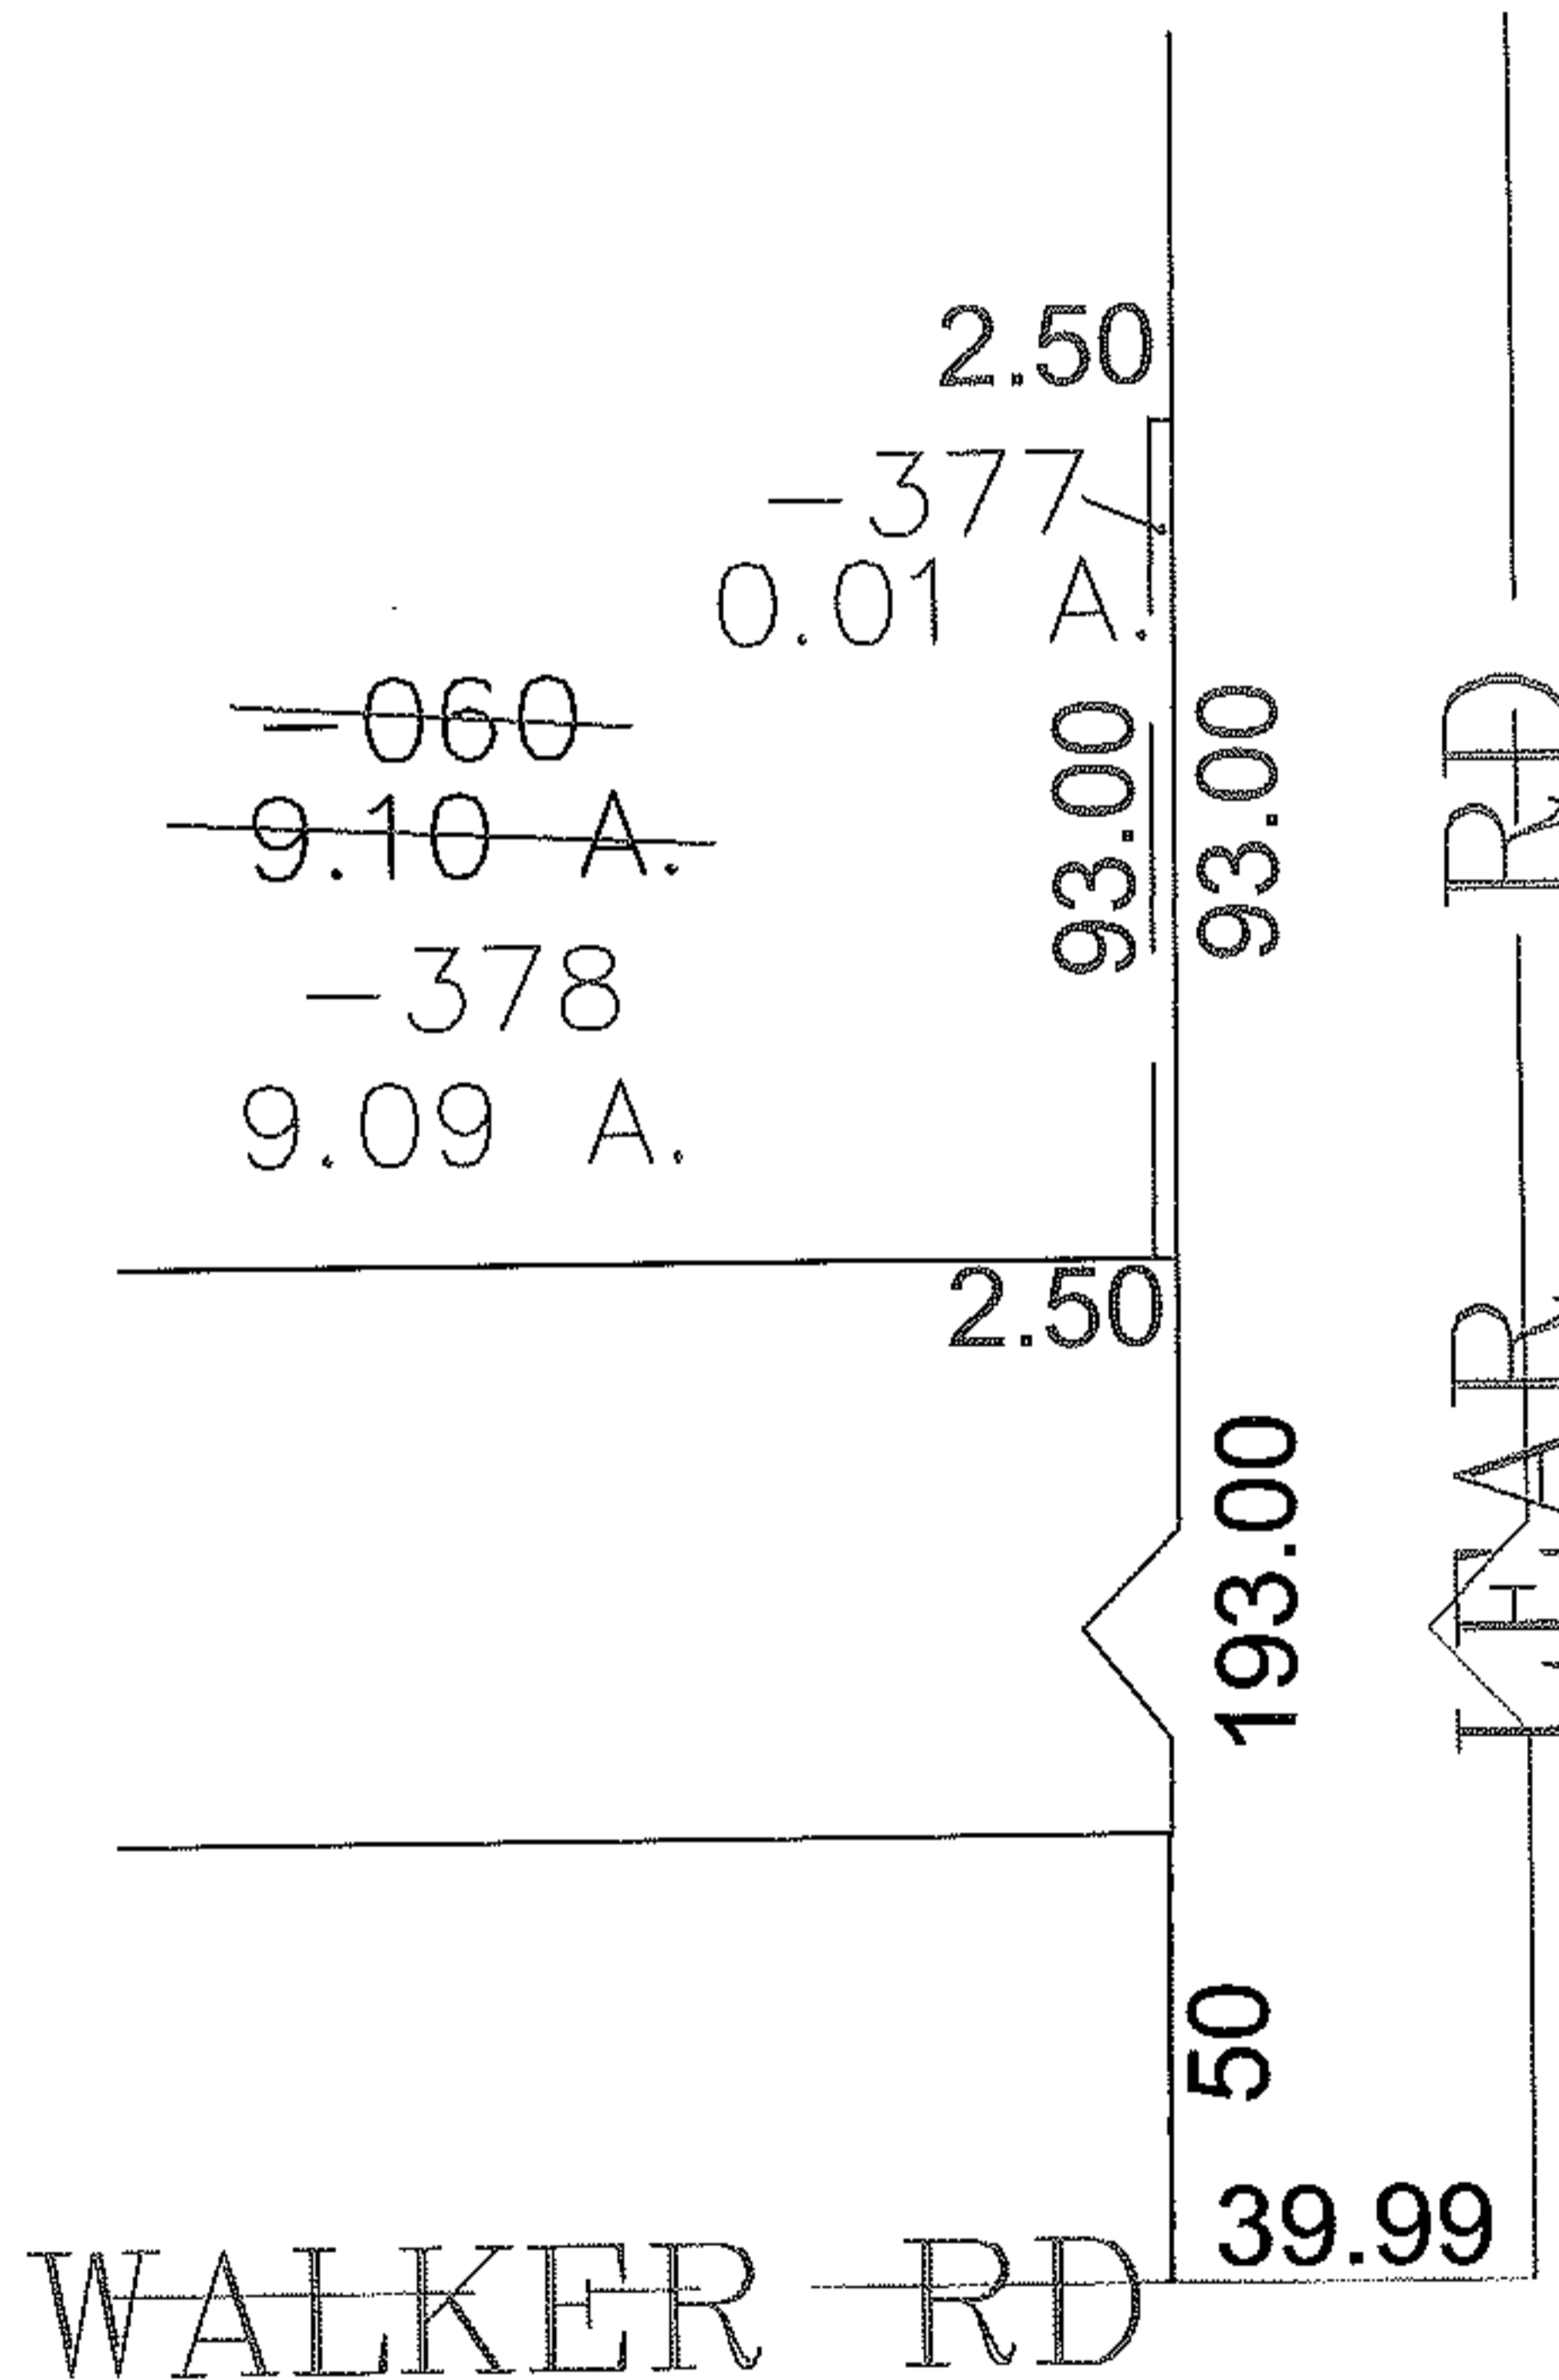


PARENT PARCEL: 04-00-019-144-060

CHILD PARCEL: 04-00-019-144-377, -378

STARTING POINT: CENTERLINE OF WALKER RD & LEAR RD

12-03105

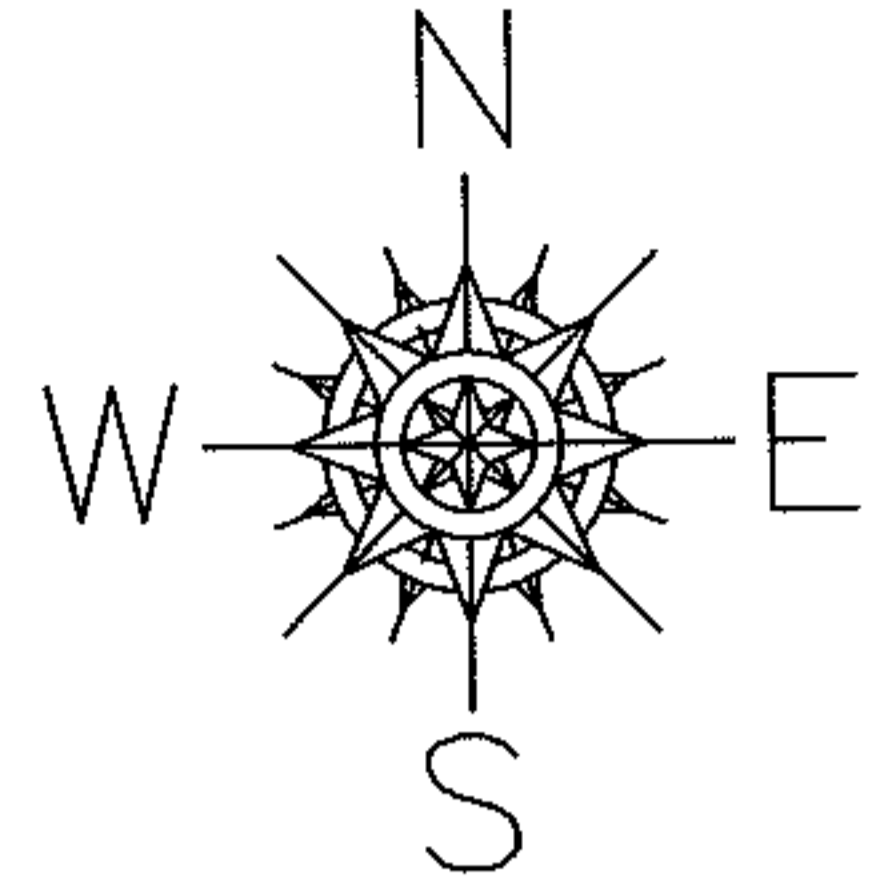

SPLITS/DEEDS PROCESSED

LORAIN COUNTY TAX MAP DEPARTMENT
226 MIDDLE AVE. ELYRIA, OHIO

SURVEYED BY: MICHAEL BRAMHALL

CLOSURE: 0.00 : 10.0000

MAP PAGE(S): 04-00-019-L

APPROVED BY: JAH DATE: 12-13-2012

SCALE: 1"= 50' PRIOR INST.: DV 874/183