
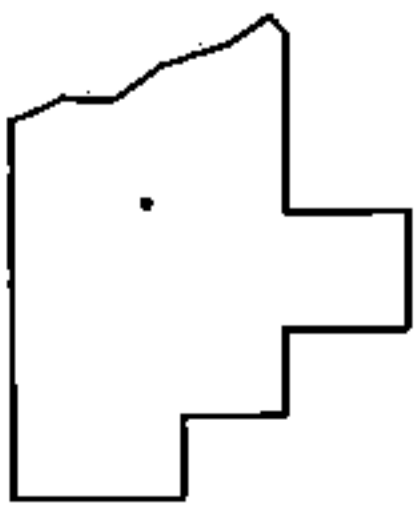
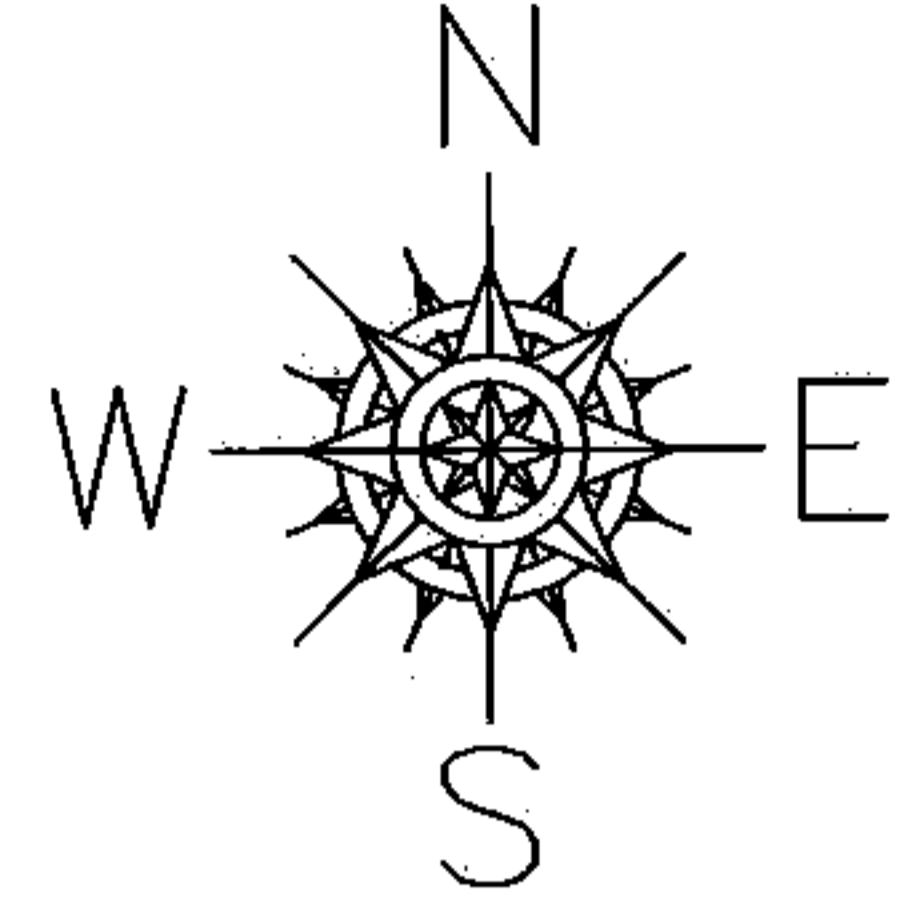


PARENT PARCEL: 04-00-003-101-405, -533

CHILD PARCEL:

15-03106-C

STARTING POINT: AT A MON BOX AT THE INTERSECTION OF C/L OF FAIRFIELD DR. AND C/L OF SHEFFIELD FRENCH CREEK RD.

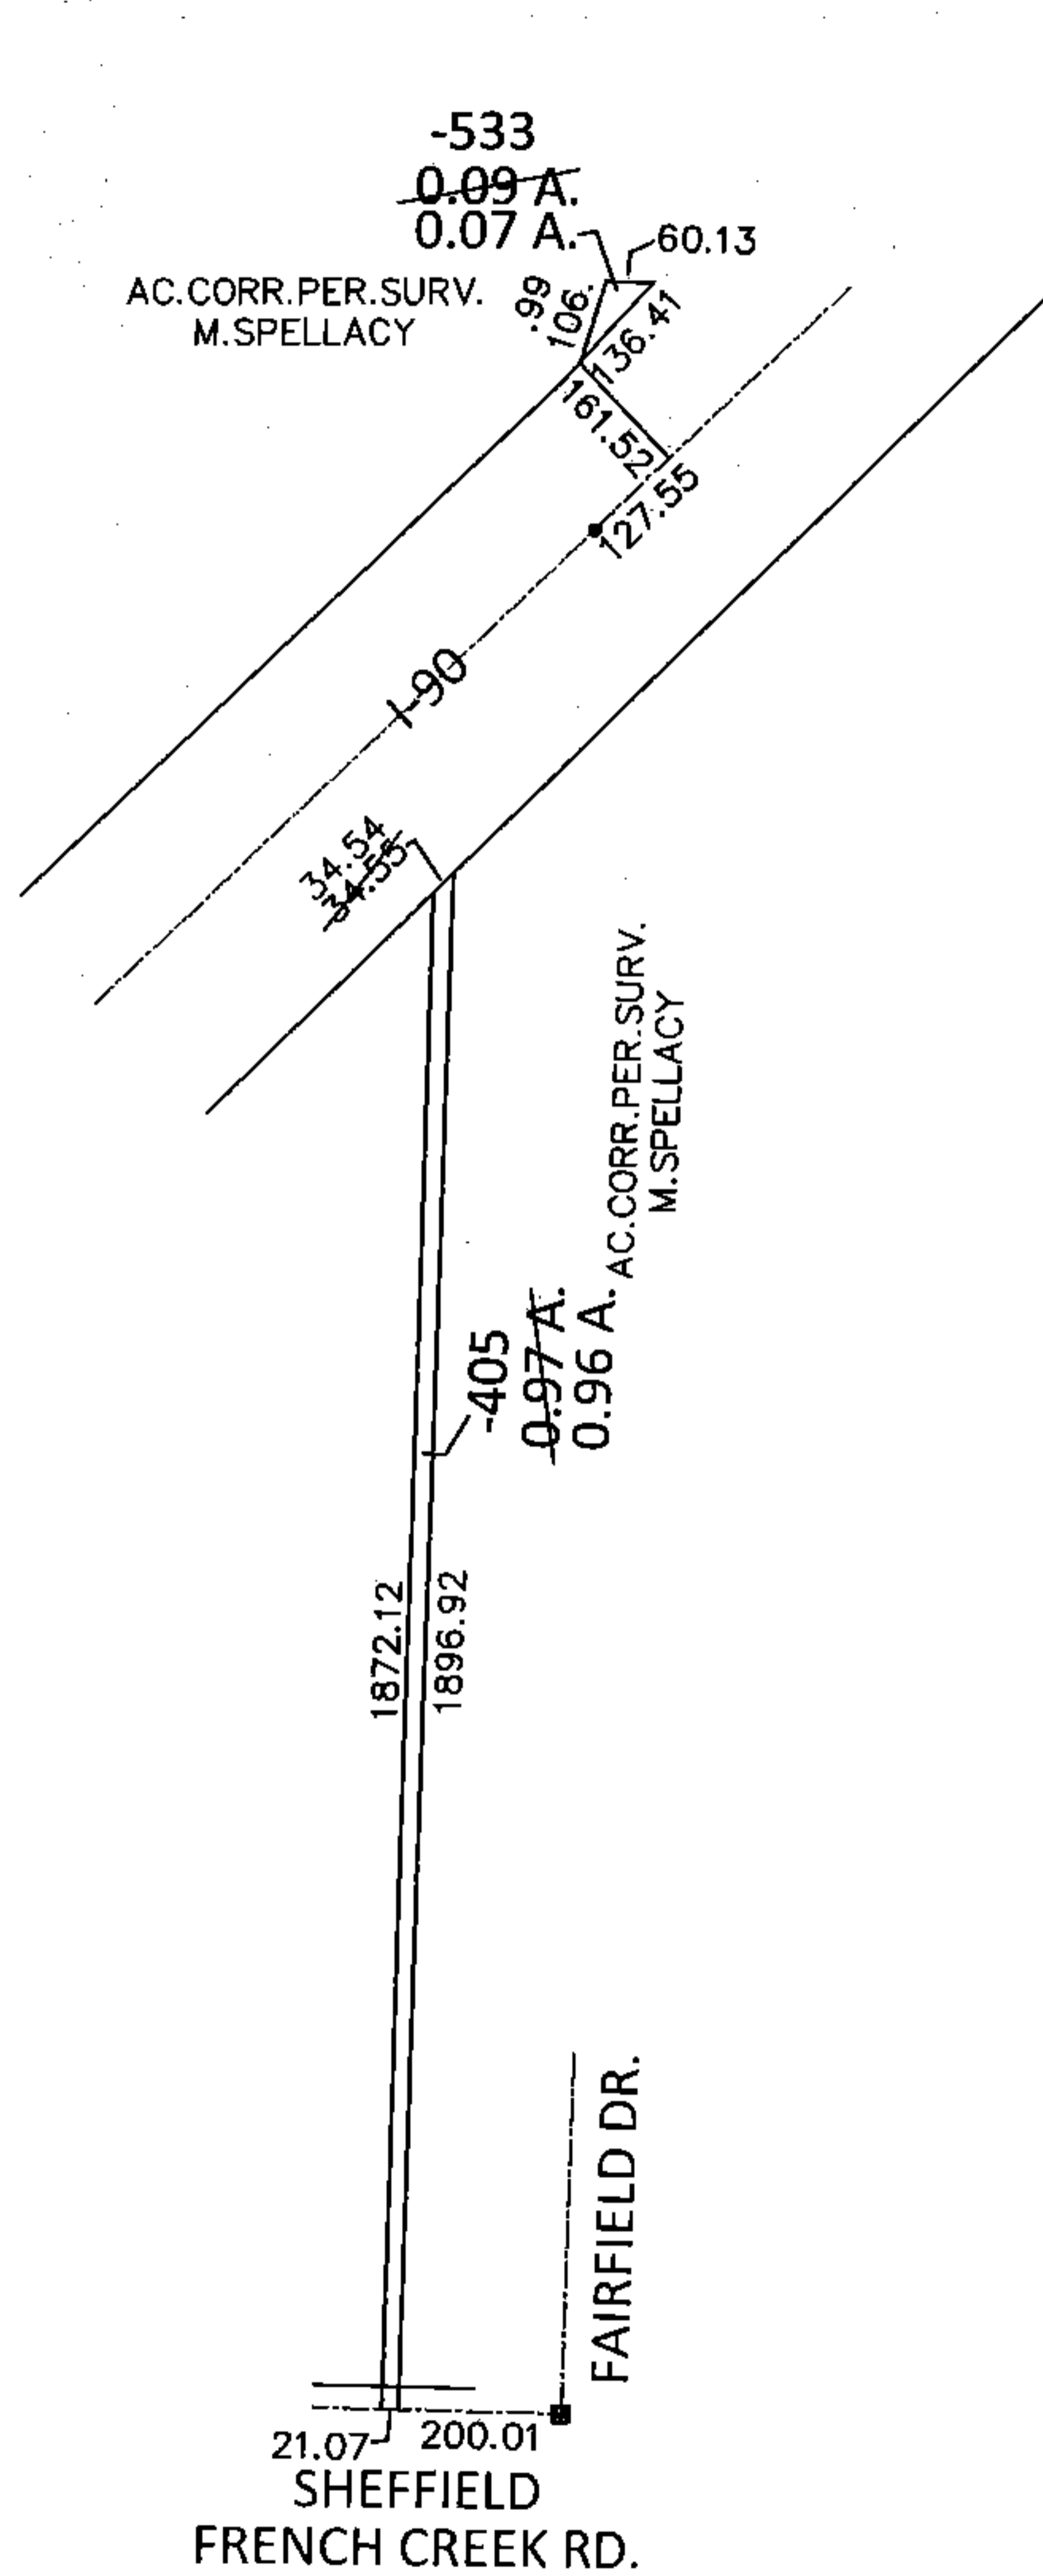

SPLITS/DEEDS PROCESSED

LORAIN COUNTY TAX MAP DEPARTMENT
226 MIDDLE AVE. ELYRIA, OHIO

SURVEYED BY:	MICHAEL P. SPELLACY
CLOSURE:	.01:10,000
MAP PAGE(S):	4-00-003-E
APPROVED BY:	RRM DATE: 2-3-15
SCALE:	1" = 400 PRIOR INST.: 20030915852