
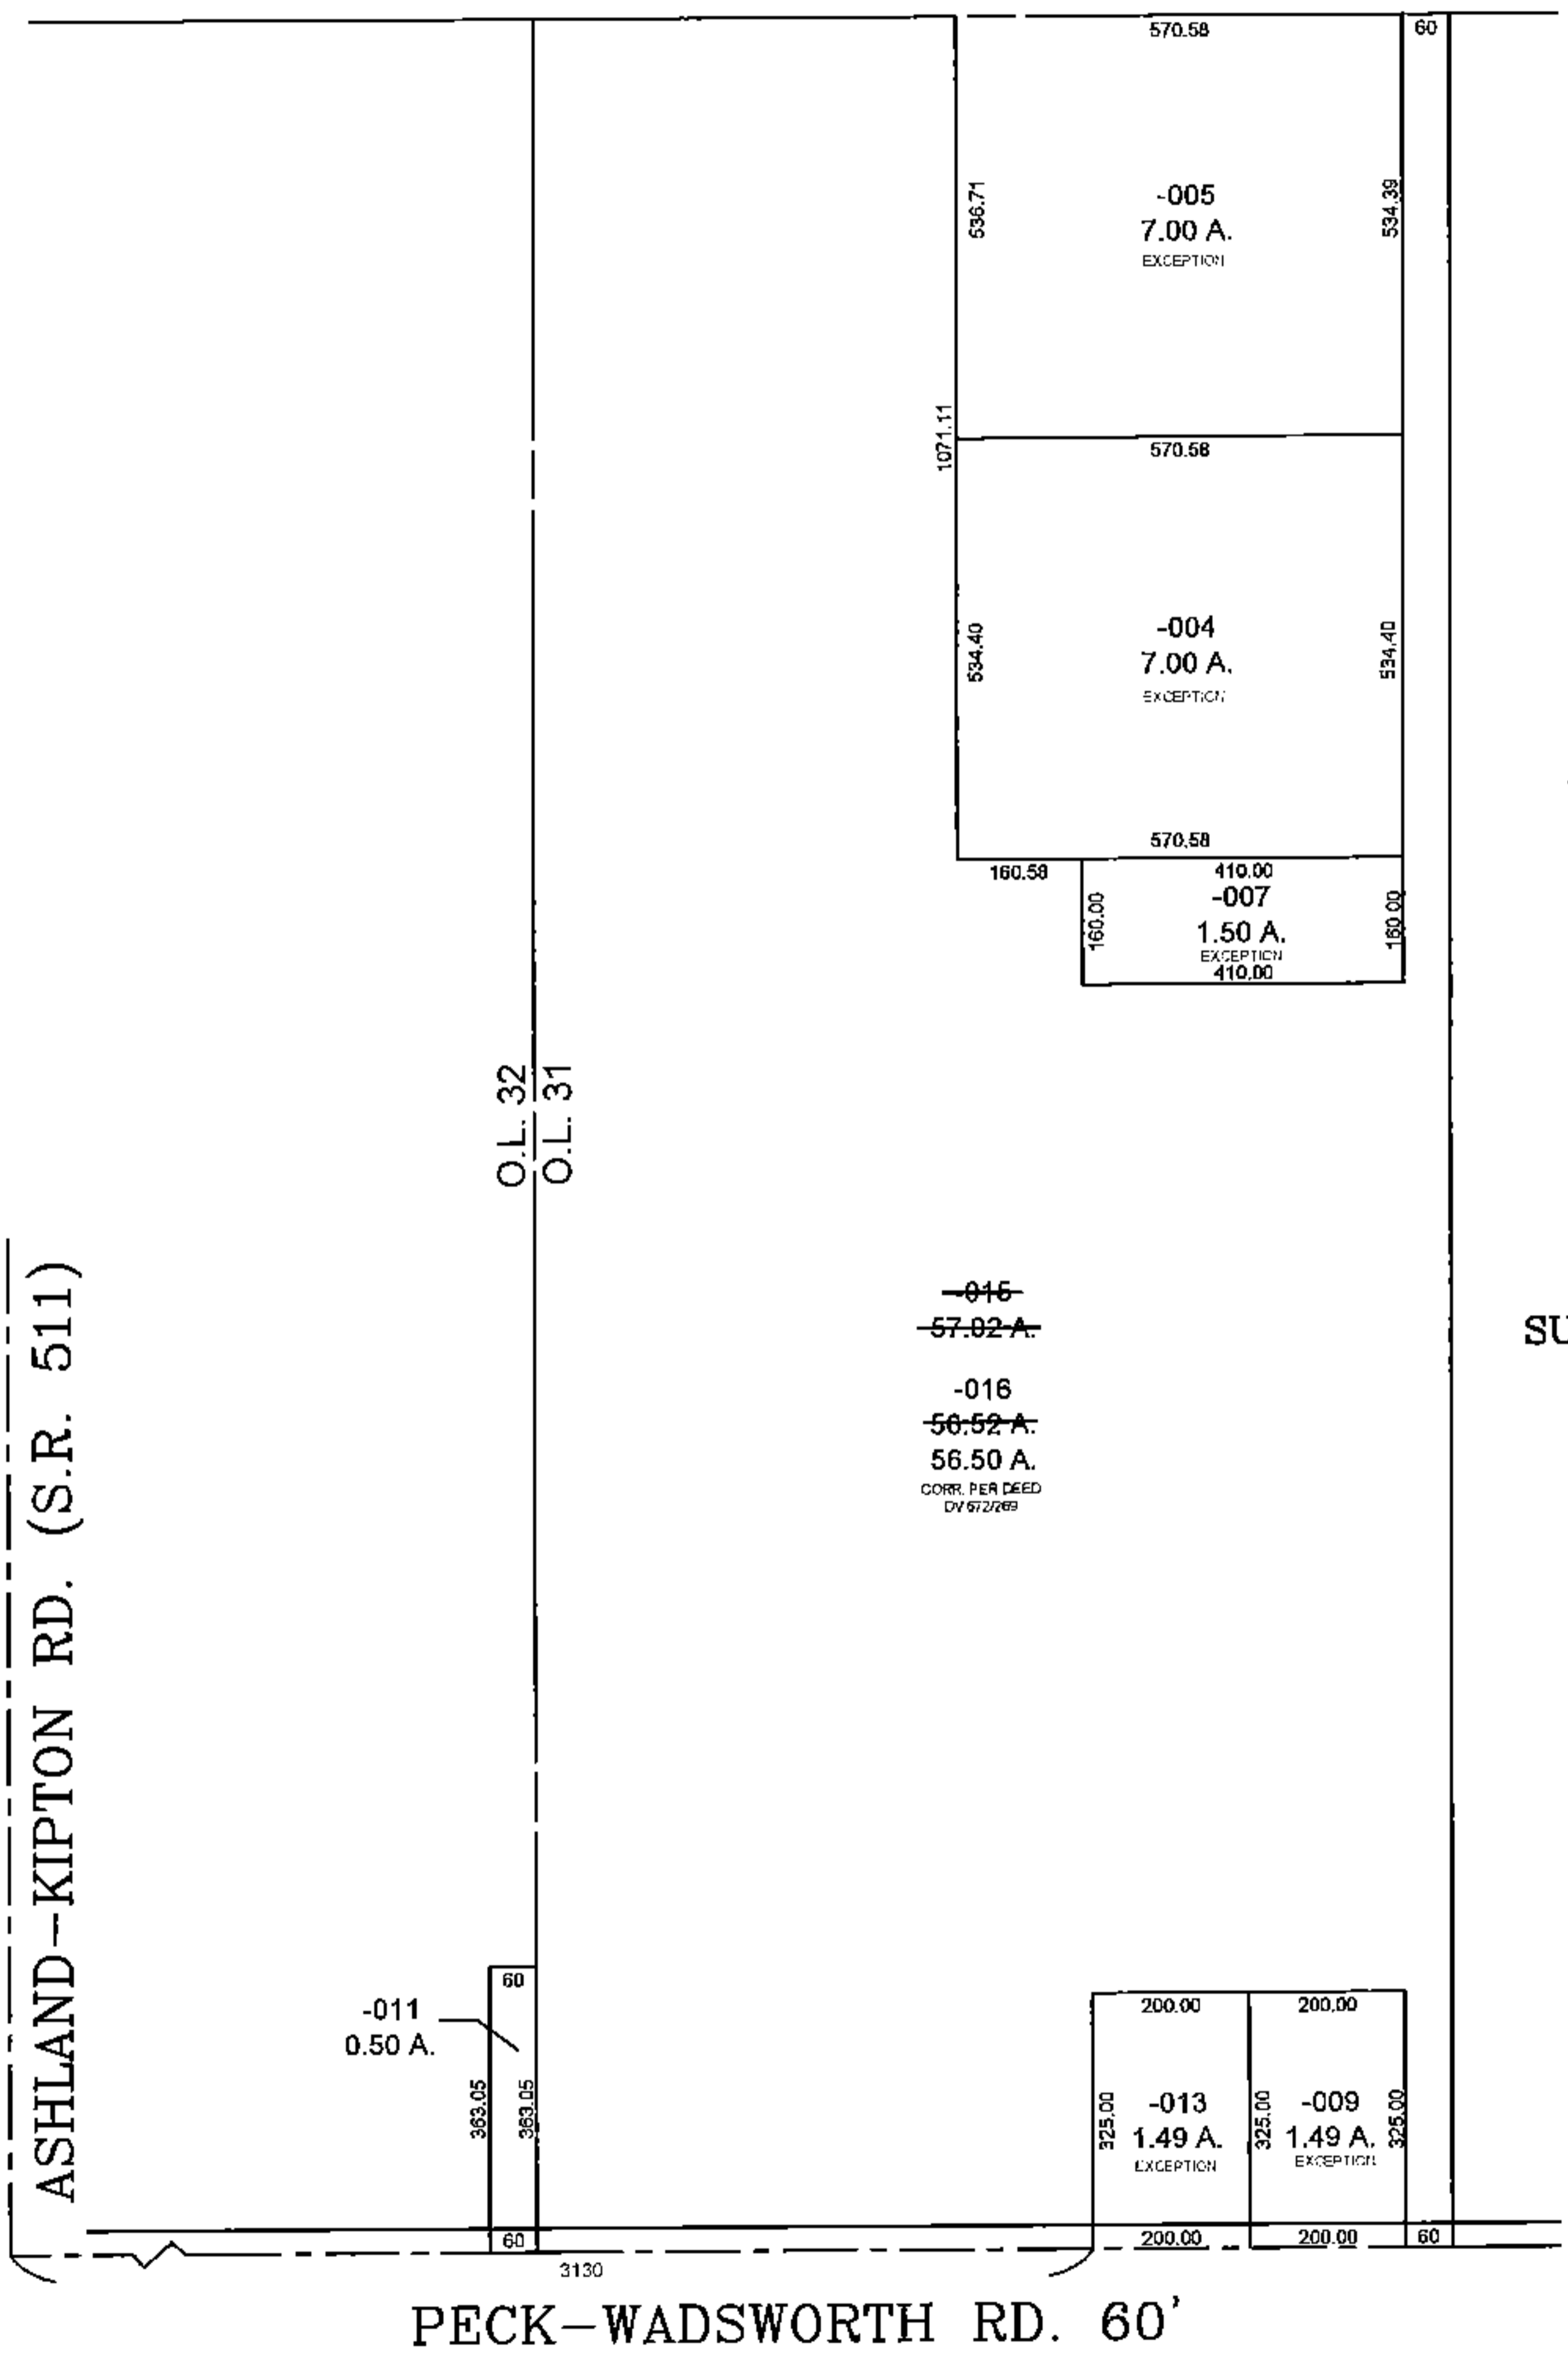


PARENT PARCEL: 17-08-031-000-015  
 CHILD PARCEL: 17-08-031-000-016 & 17-08-032-000-011  
 STARTING POINT: CL OF S.R.511 & CL OF PECK-WADSWORTH RD.

15-03107-U

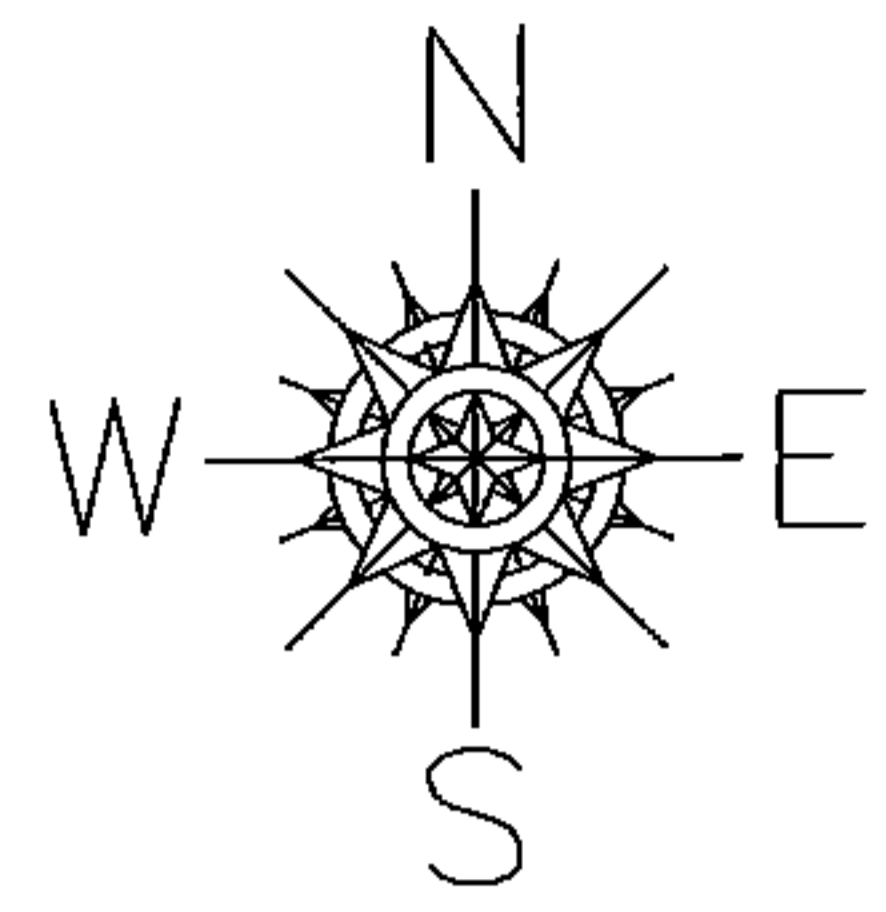

**UNCOMBINATION**


~~17-08-031-000-015~~  
~~57.02 A.~~

17-08-032-000-011  
 0.50 A.

17-08-031-000-016  
~~56.52 A.~~  
 56.50 A.  
CORR. PER DEED  
 DV 672/269

**SURVEY BEFORE NEXT TRANSFER  
 TOO MANY EXCEPTIONS**

PRIOR INSTRUMENT: OR 665/377  
 PRIOR INSTRUMENT: OR 1121/853

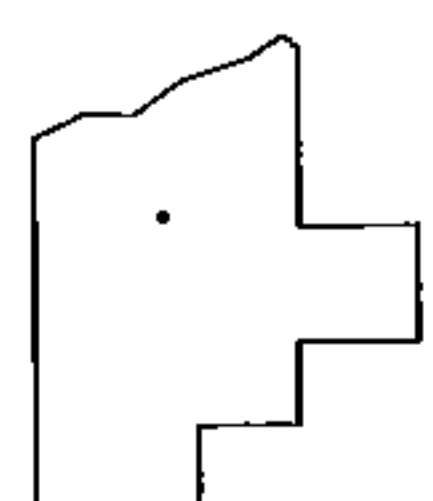

**SPLITS/DEEDS PROCESSED**  
**LORAIN COUNTY TAX MAP DEPARTMENT**  
 226 MIDDLE AVE. ELYRIA, OHIO

SURVEYED BY: NA  
 CLOSURE: NA  
 MAP PAGE(S): 17-08-031 & -032  
 APPROVED BY: TJS DATE: 2/3/15  
 SCALE: 1" = 400'