
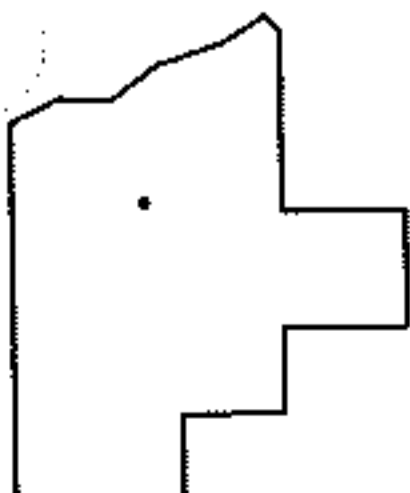
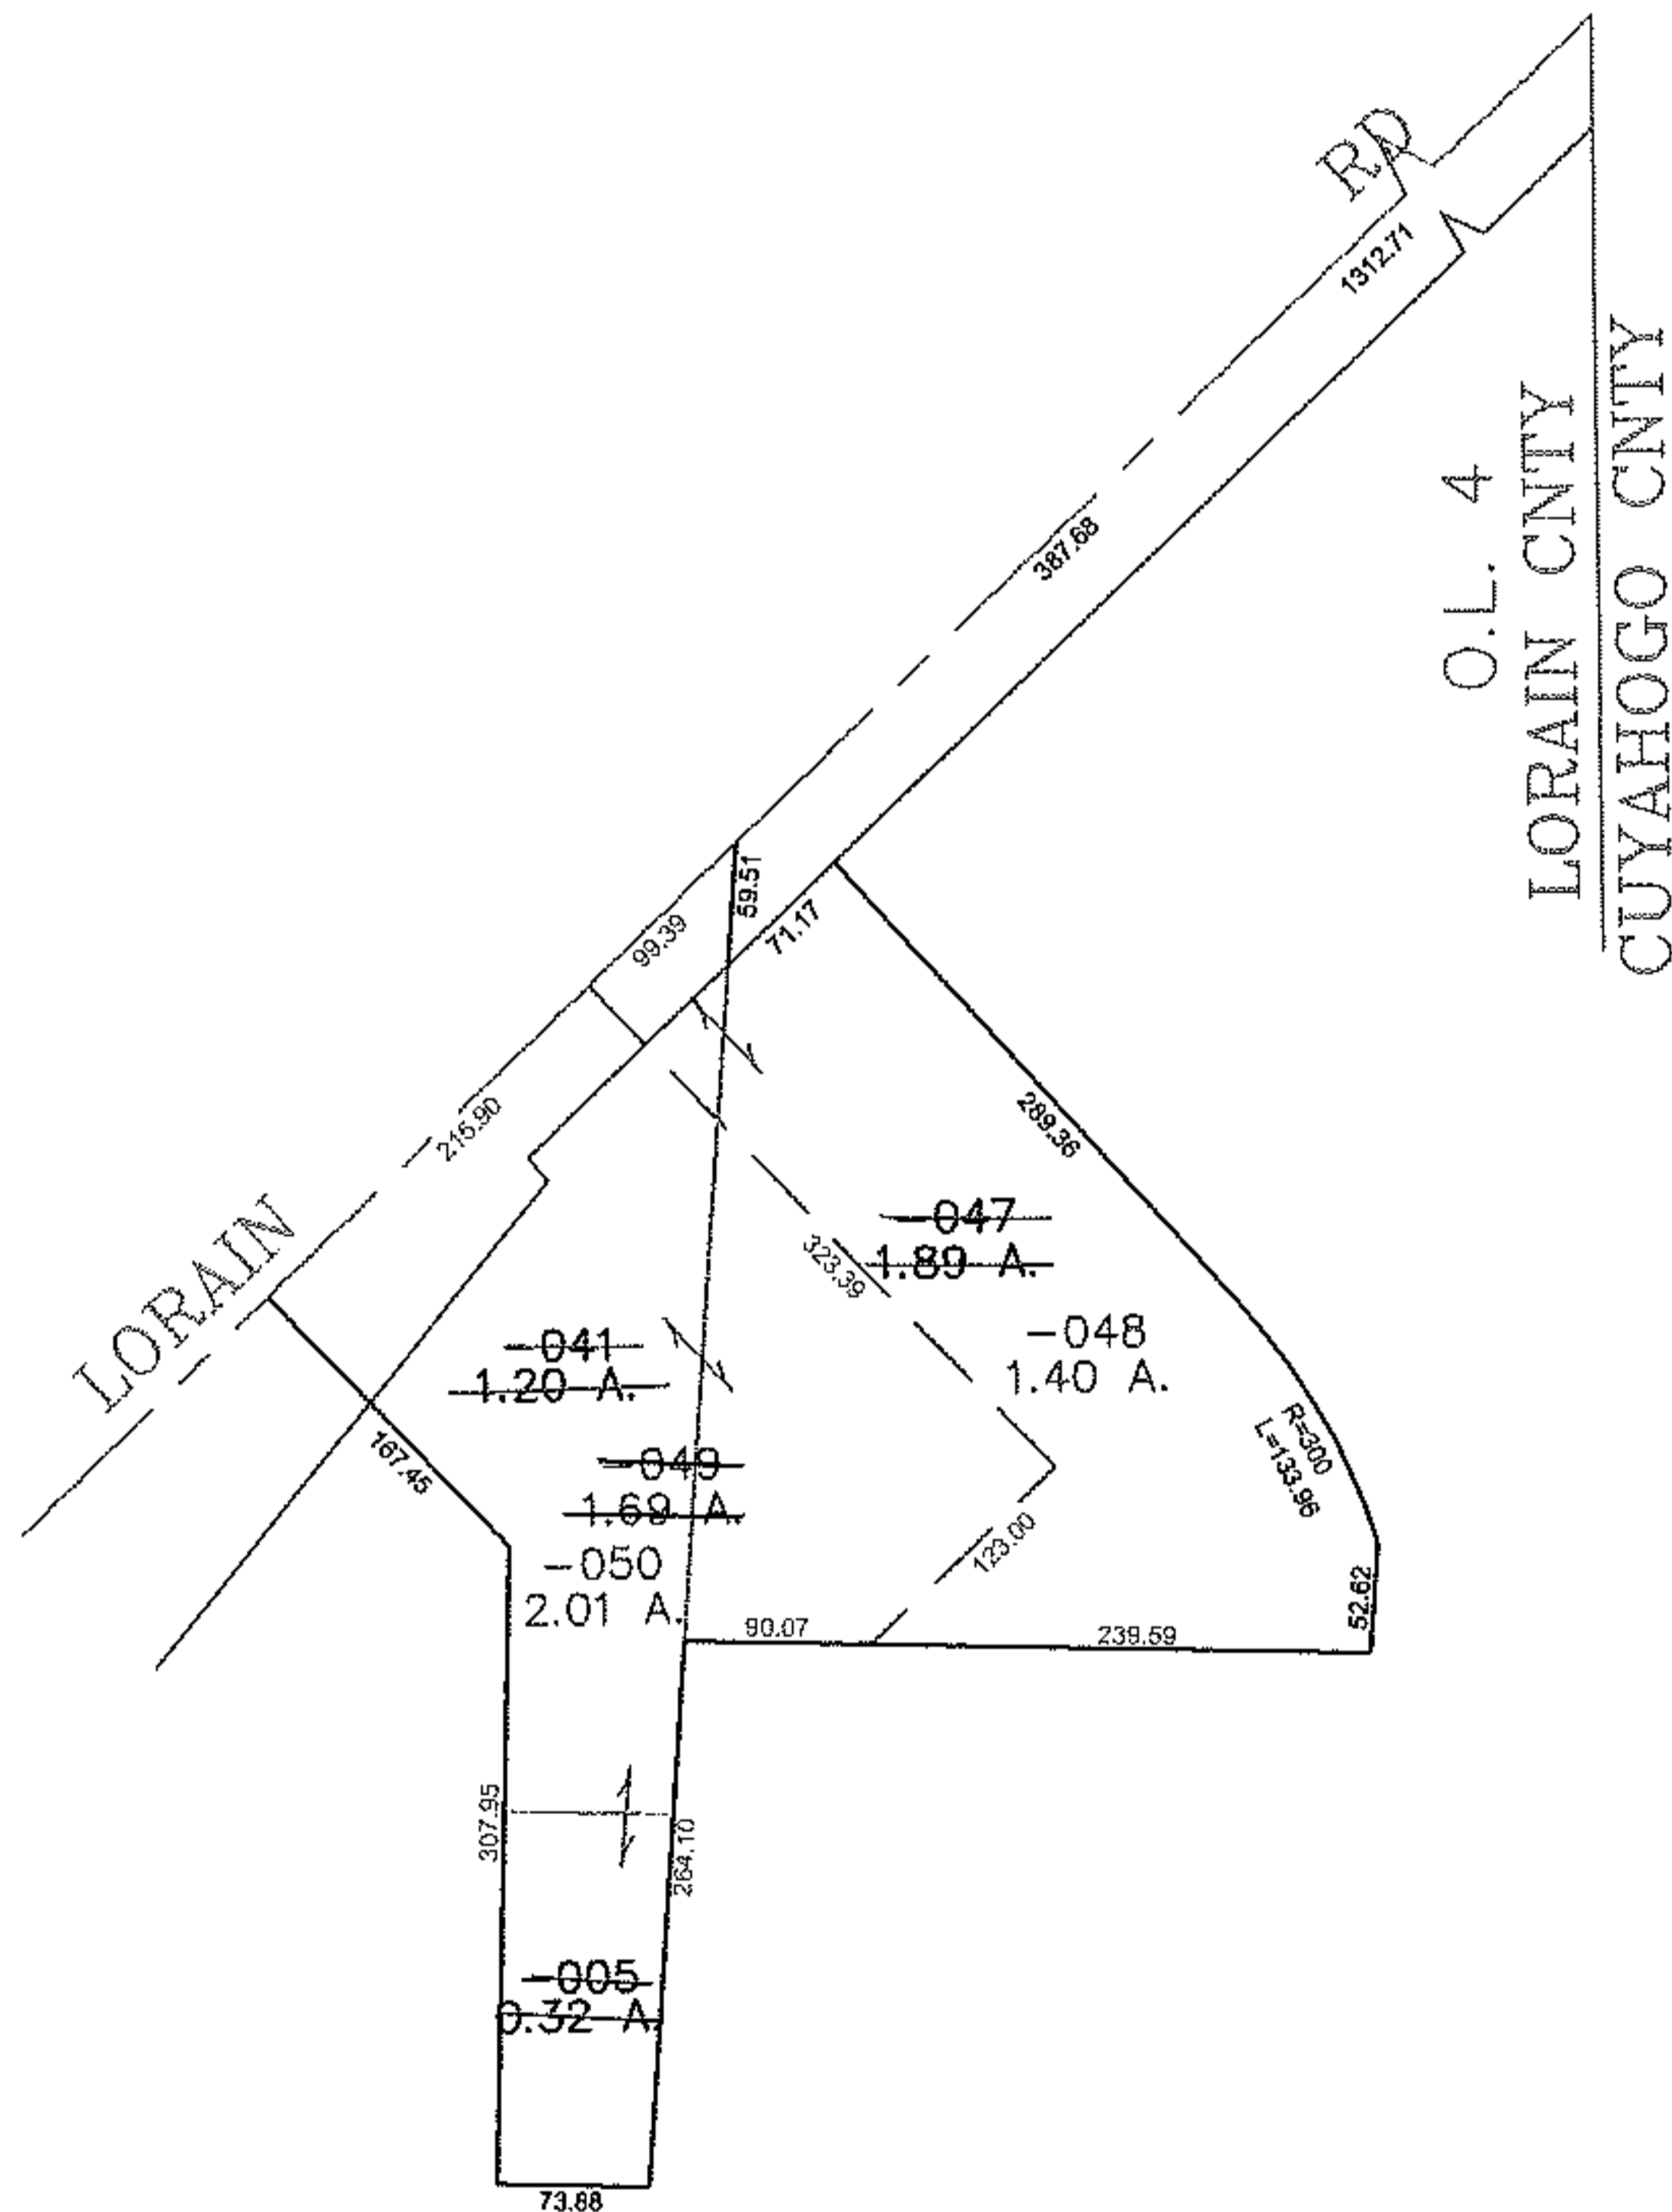


PARENT PARCEL: 07-00-004-110-041, -047, -005

CHILD PARCEL: 07-00-004-110-048, -049, -050

STARTING POINT: CENTERLINE OF LORAIN RD & O.L. 4

12-03107

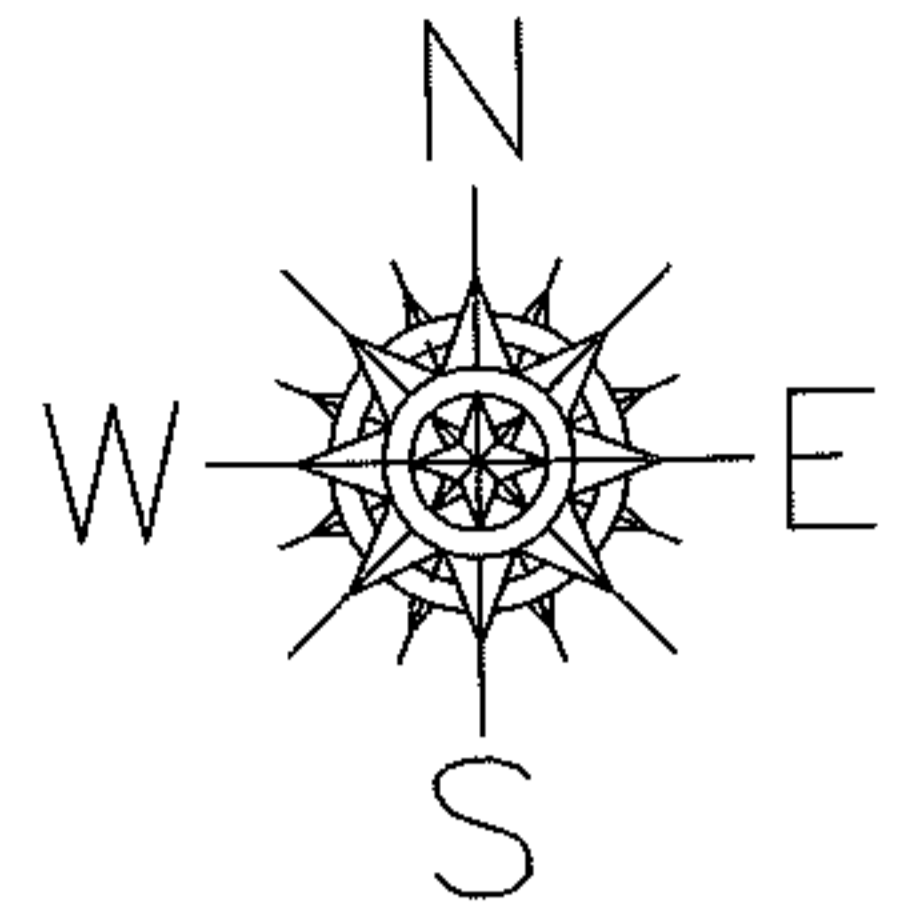

**SPLITS/DEEDS PROCESSED**  
**LORAIN COUNTY TAX MAP DEPARTMENT**  
 226 MIDDLE AVE. ELYRIA, OHIO

SURVEYED BY: TREVOR BIXLER  
 CLOSURE: 0.00 : 10.000  
 MAP PAGE(S): 07-00-004-D  
 APPROVED BY: JAH DATE: 12/18/2012  
 SCALE: 1" = 200 PRIOR INSTRUMENT: 20060161100