
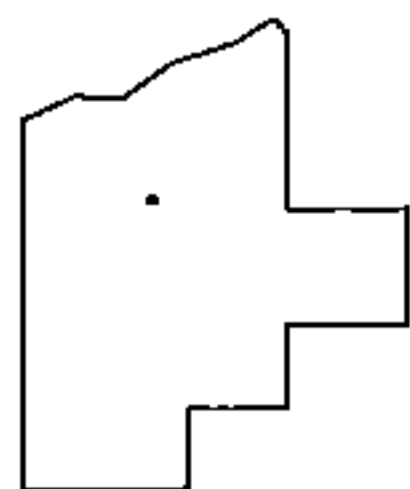


PARENT PARCEL: 02-02-002-000-070 & 02-02-003-101-043

CHILD PARCEL: XX-XX-XXX-XXX-XXX

STARTING POINT: I.P. MON. BOX, CL OF COOPER FOSTER PARK RD. & CL OF LEAVITT RD. (S.R. 58)

15-03111-C

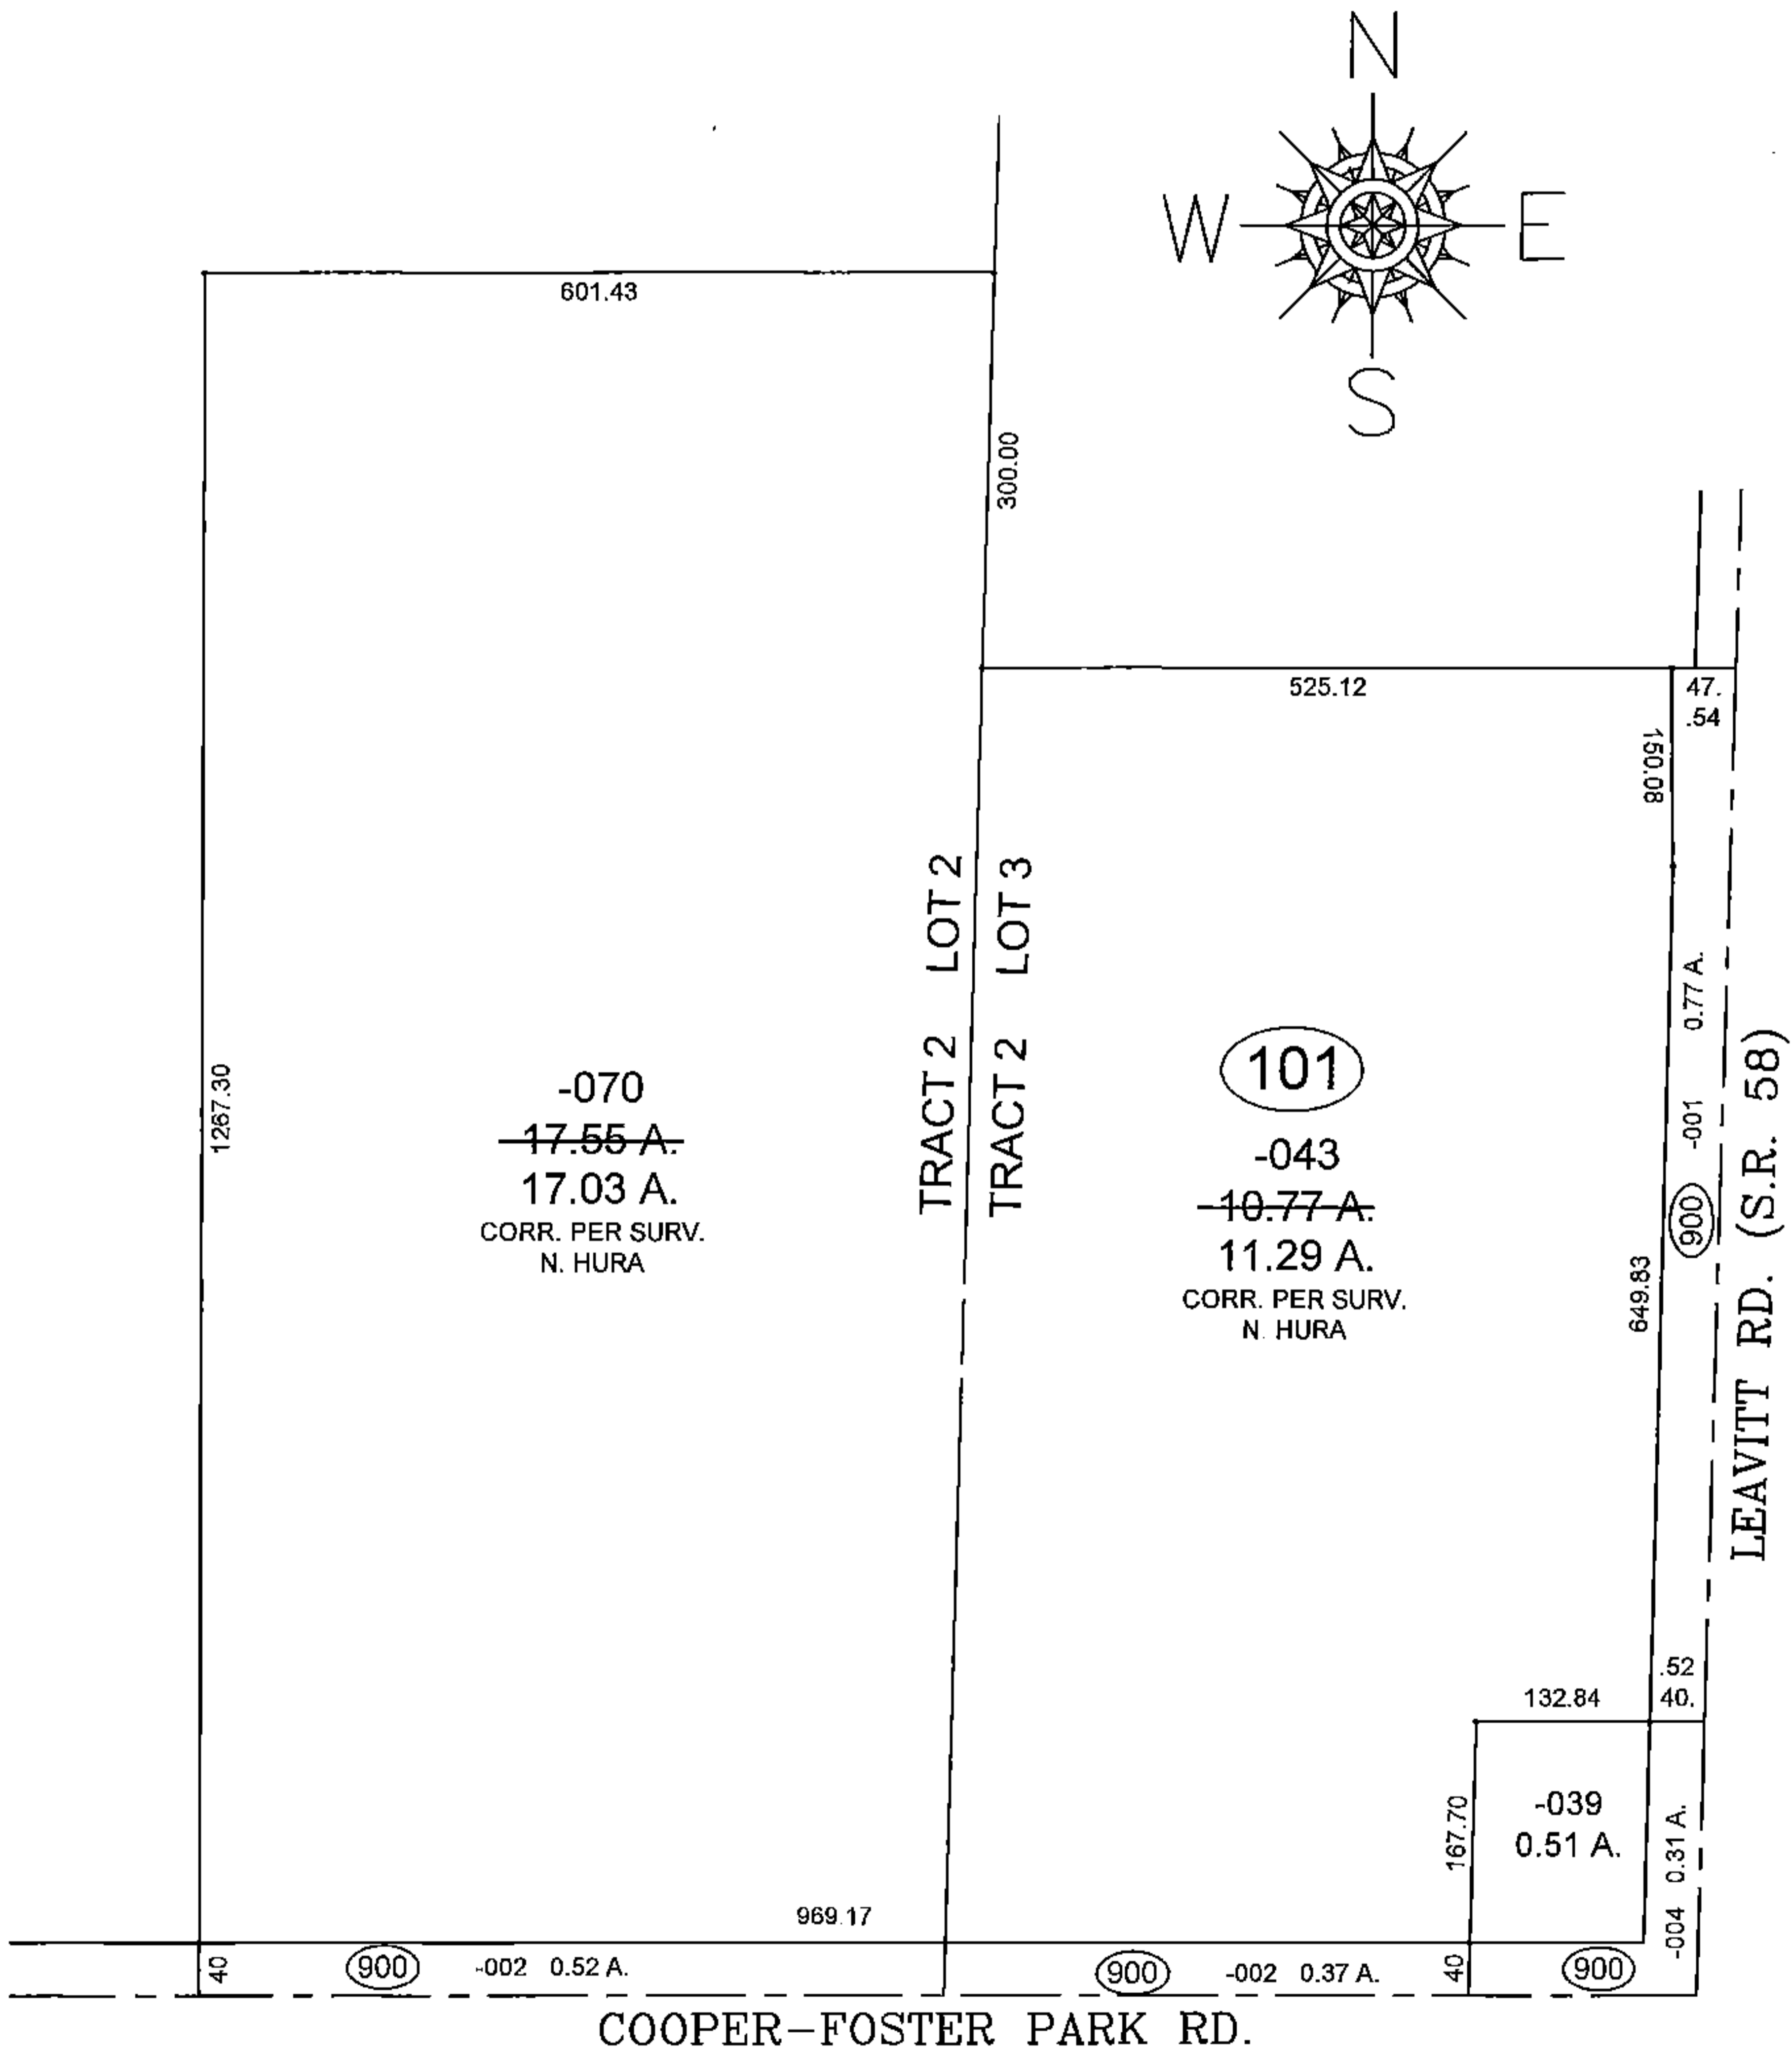

SPLITS/DEEDS PROCESSED

LORAIN COUNTY TAX MAP DEPARTMENT
226 MIDDLE AVE. ELYRIA, OHIO

SURVEYED BY: NORMAN R. HURA

CLOSURE: 0.01 : 10,000

MAP PAGE(S): 02-02-002 & 02-02-003

APPROVED BY: TJS DATE: 2/10/15

SCALE: 1"= 200 PRIOR INST.: DV XXXX/XXX