
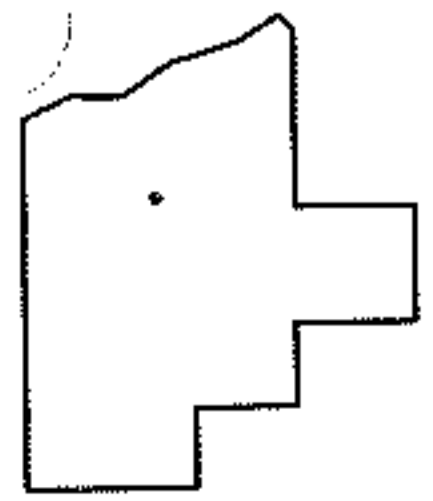
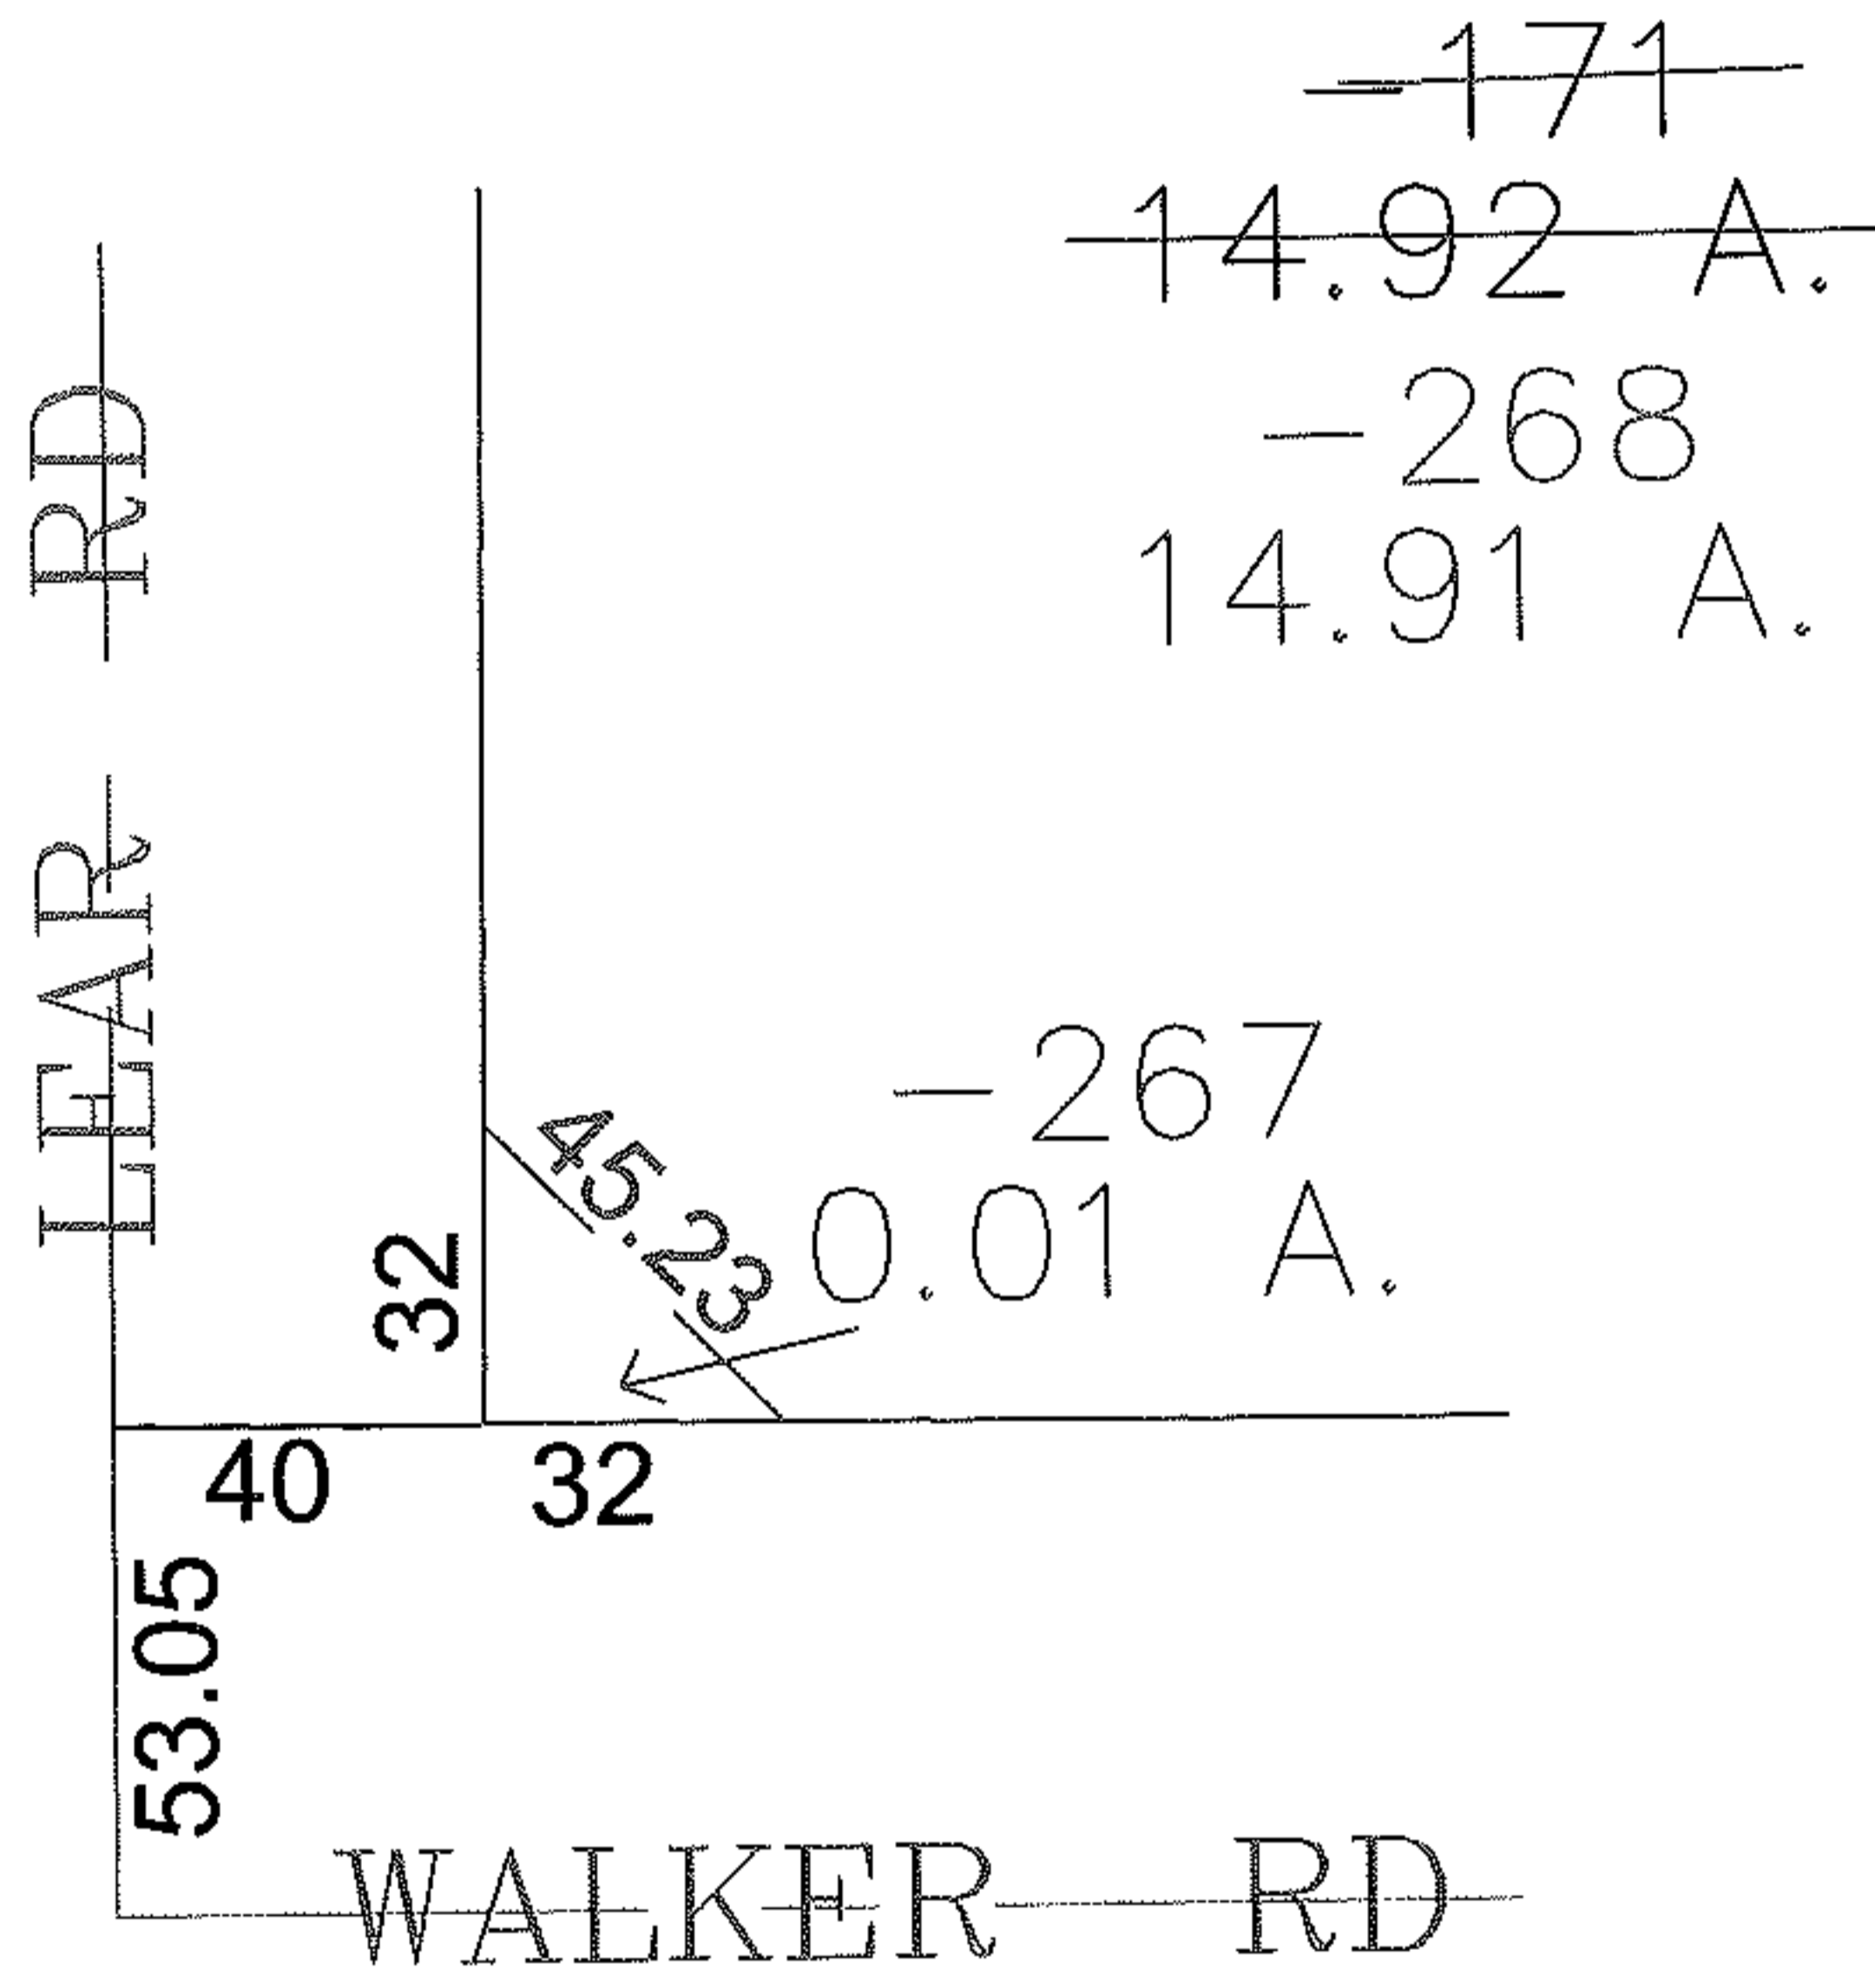


PARENT PARCEL: 04-00-030-141-171
CHILD PARCEL: 04-00-030-141-267, -268
STARTING POINT: CENTERLINE OF WALKER RD & LEAR RD

13-03112

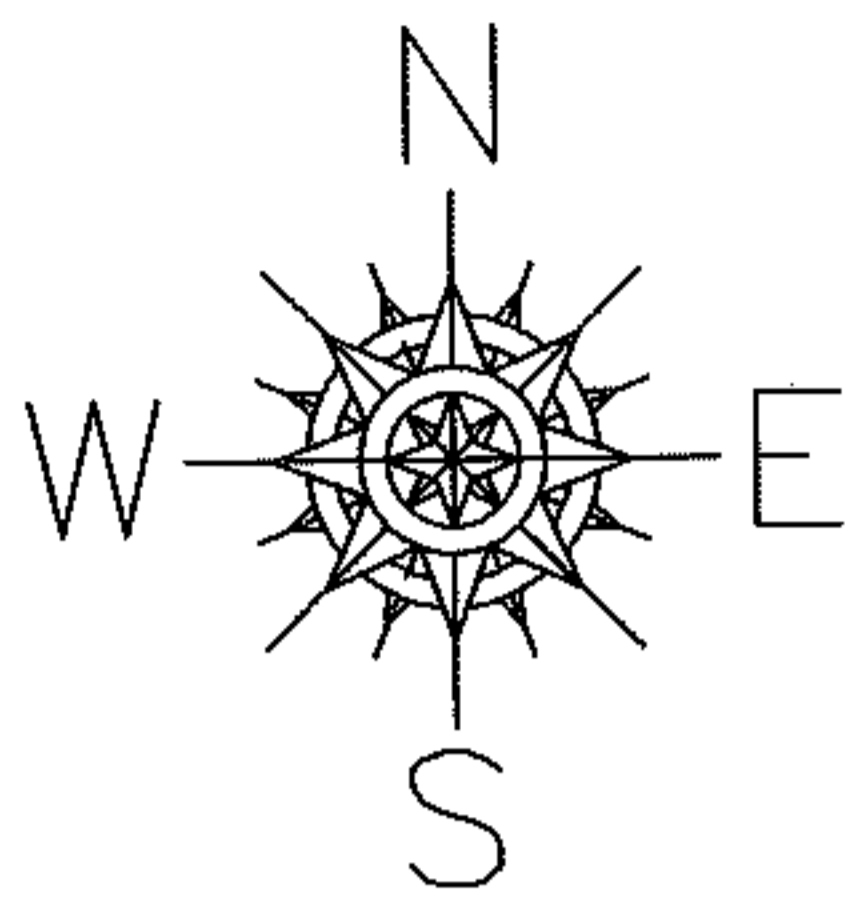

SPLITS/DEEDS PROCESSED
LORAIN COUNTY TAX MAP DEPARTMENT
226 MIDDLE AVE. ELYRIA, OHIO

SURVEYED BY: MICHAEL BRAMHALL
CLOSURE: 0.00 : 10,000
MAP PAGE(S): 04-00-030-E
APPROVED BY: JAH DATE: 1/7/2013
SCALE: 1"= 50' PRIOR INST.: 19970447003