

PARENT PARCEL: 18-00-029-000-114, -115, -117, & -133  
CHILD PARCEL: XX-XX-XXX-XXX-XXX  
STARTING POINT: XXXXXX

<sup>5</sup>  
~~18~~-03113-C

### CERTIFICATE OF CORRECTION


THIS IS TO CERTIFY that certain corrections need to be made to the plat of Windemere at Wellington Commons Subdivision as recorded in Volume 100, Pages 75 through 77, inclusive, of the Lorain County Plat Records.

The corrections required are as follows:

1. The rear (South) line of subplot 6 should be 160.97 feet.
2. The East line of Sublot 7 should be 157.23 feet.
3. The East line of Sublot 9 should be 19.24 feet.
4. The North line of Block "A" should be 604.53 feet.



*Amy M. Kelly* 2/16/2015  
Amy M. Kelly, P.S.  
Registered Surveyor Number 8469

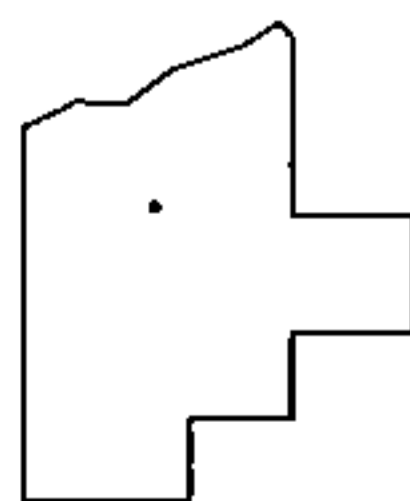

**SPLITS/DEEDS PROCESSED**  
LORAIN COUNTY TAX MAP DEPARTMENT  
226 MIDDLE AVE. ELYRIA, OHIO

SURVEYED BY: AMY KELLY  
CLOSURE: XXXXXX  
MAP PAGE(S): 18-00-029  
APPROVED BY: TJS DATE: 2/17/15  
SCALE: 1"= 100 PRIOR INST.: DV XXXX/XXX