


PARENT PARCEL: 01-00-062-000-054

CHILD PARCEL: 01-00-062-000-056 THRU -058

STARTING POINT: CENTERLINE OF BANK RD & O.L. 62

13-03113

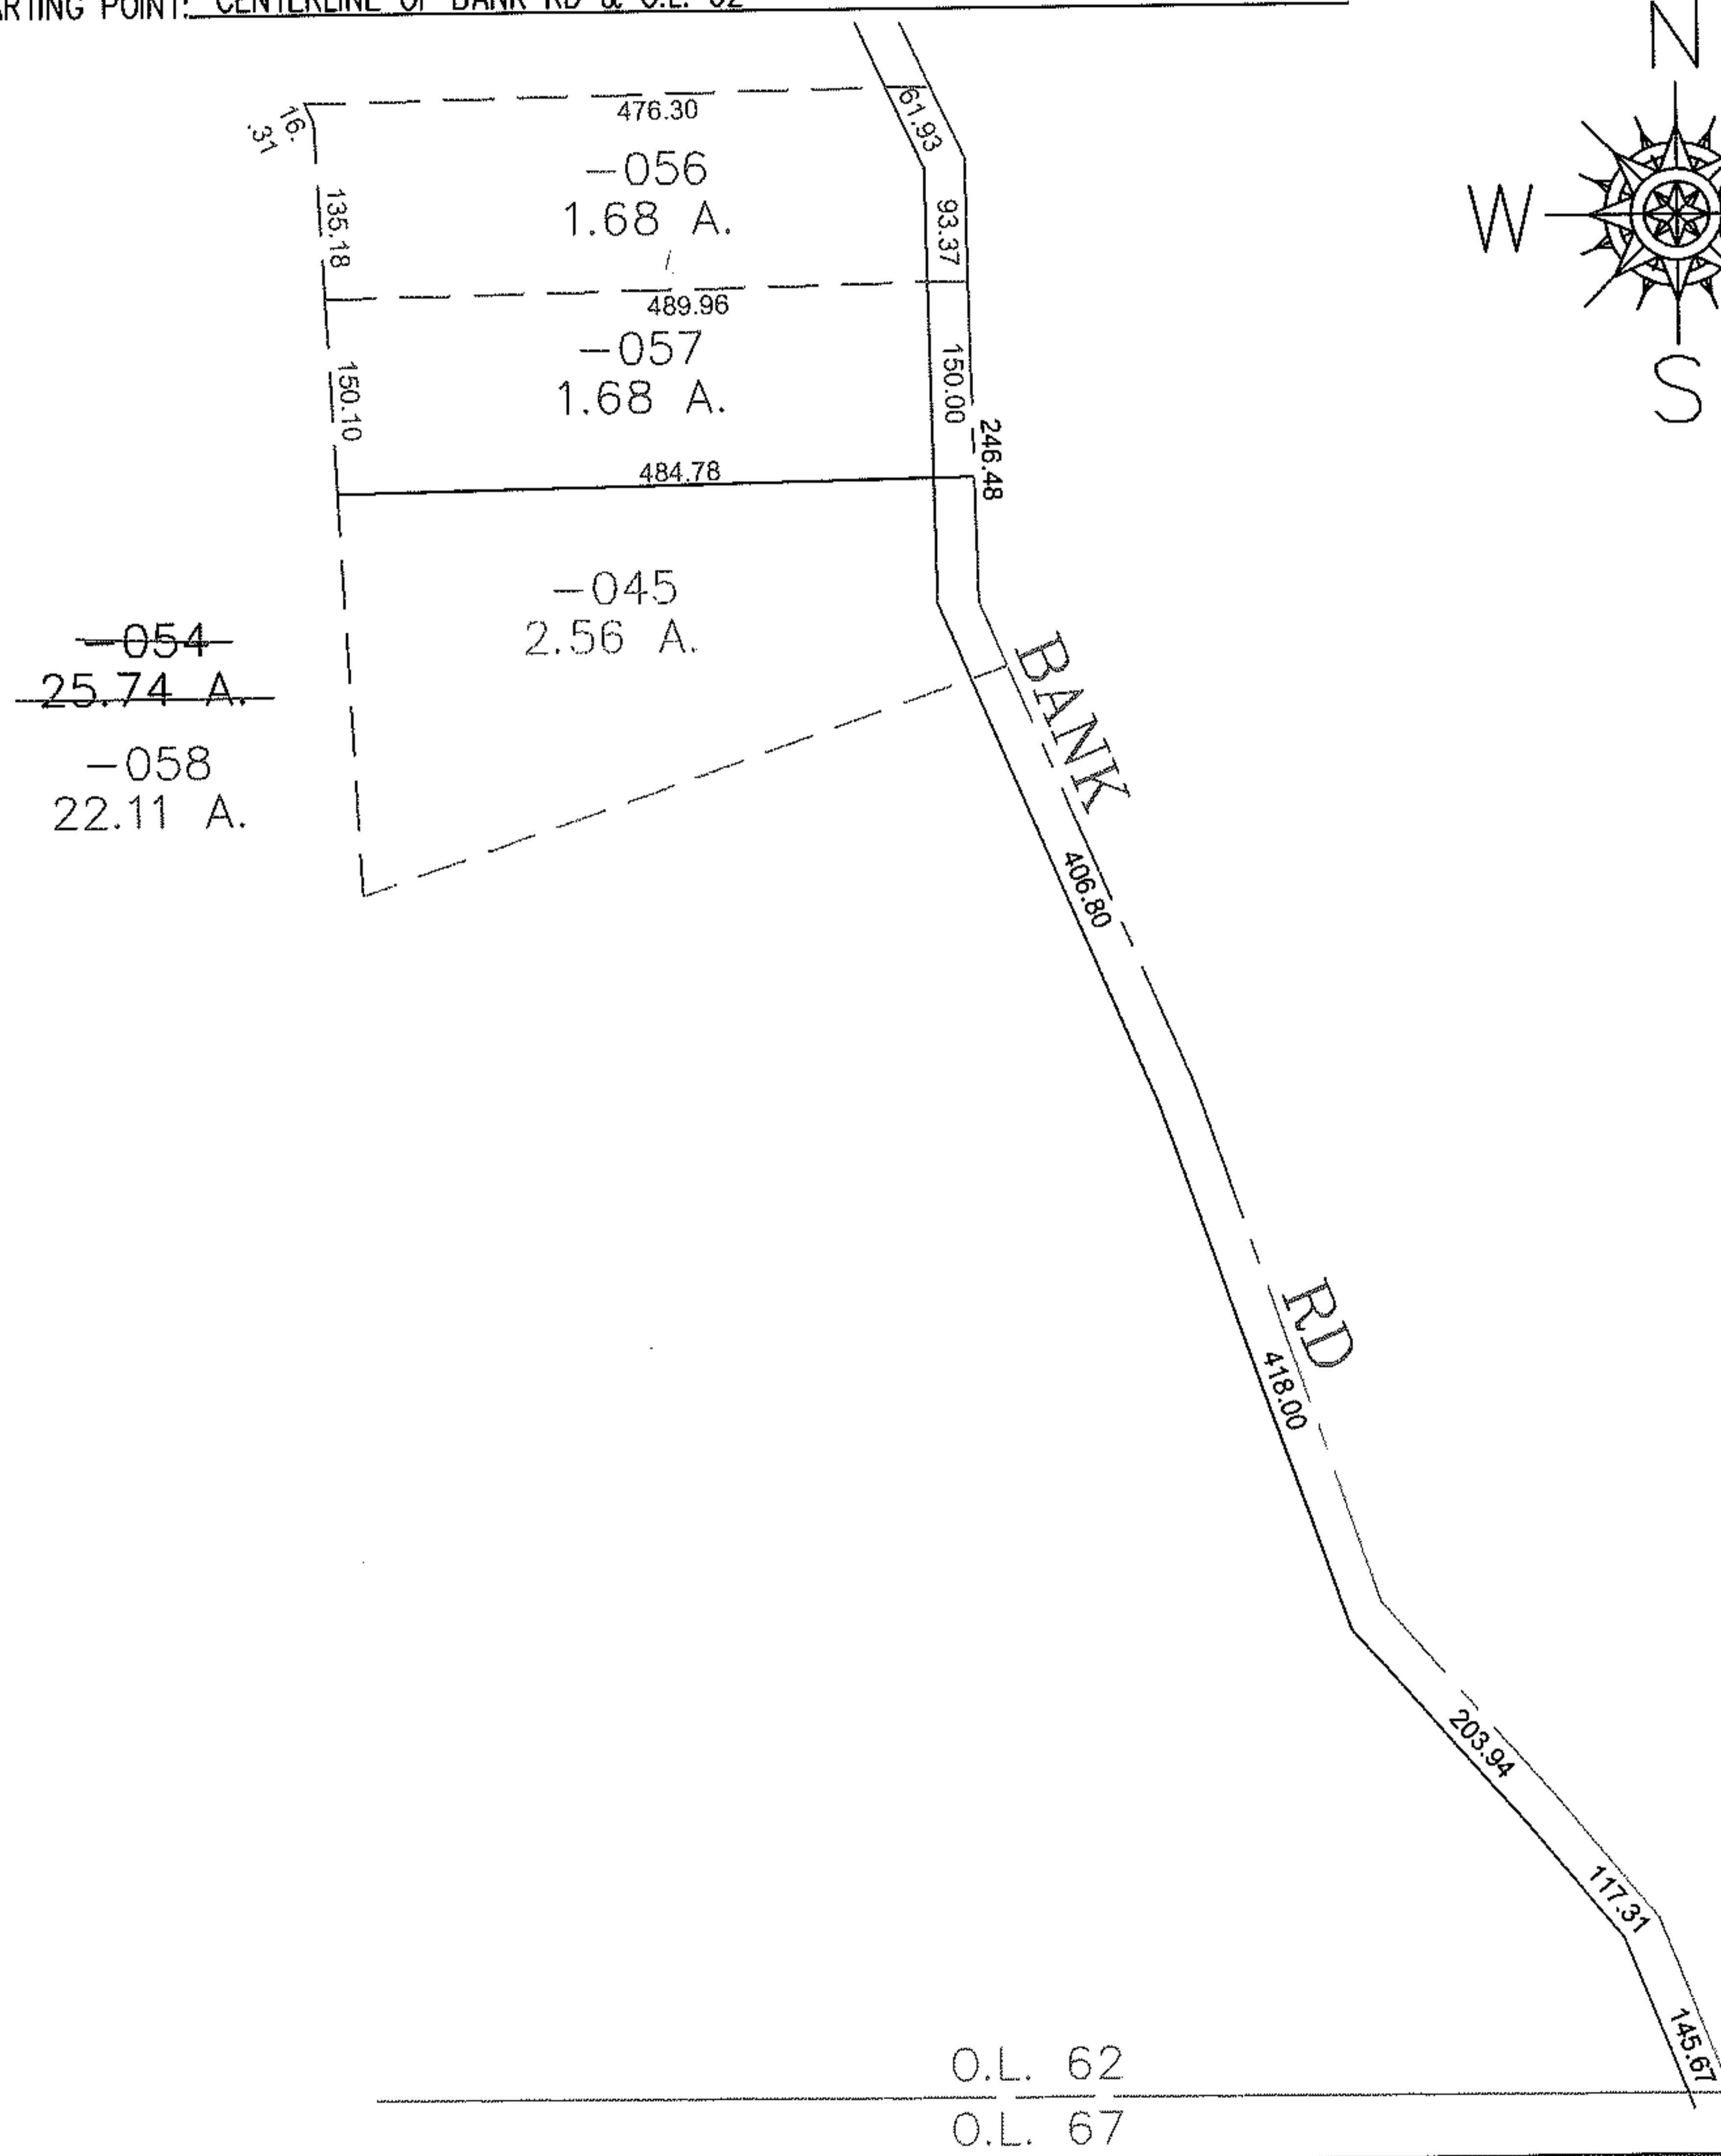

**SPLITS/DEEDS PROCESSED**

LORAIN COUNTY TAX MAP DEPARTMENT  
226 MIDDLE AVE. ELYRIA, OHIO

SURVEYED BY: RICHARD FREDRICKSON

CLOSURE: 0.00 : 10.000

MAP PAGE(S): 1-J

APPROVED BY: JAH DATE: 1/7/2013

SCALE: 1" = 200 PRIOR INSTRUMENT: 20060171394