

PARENT PARCEL: 06-25-018-107-020 & -026

CHILD PARCEL: 06-25-018-107-028

STARTING POINT: S.W. CORNER OF S/L 105

15-03116-C




### COMBINATION

~~06-25-018-107-020~~  
~~43.73 X 138~~

~~06-25-018-107-026~~  
~~41 X 3~~

06-25-018-107-028  
43.73 X 141.05

CORR. PER  
INST. 2015-0534841

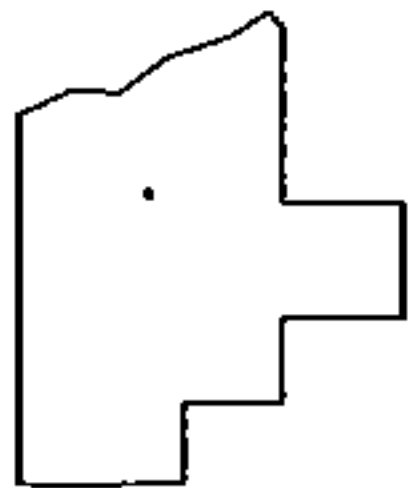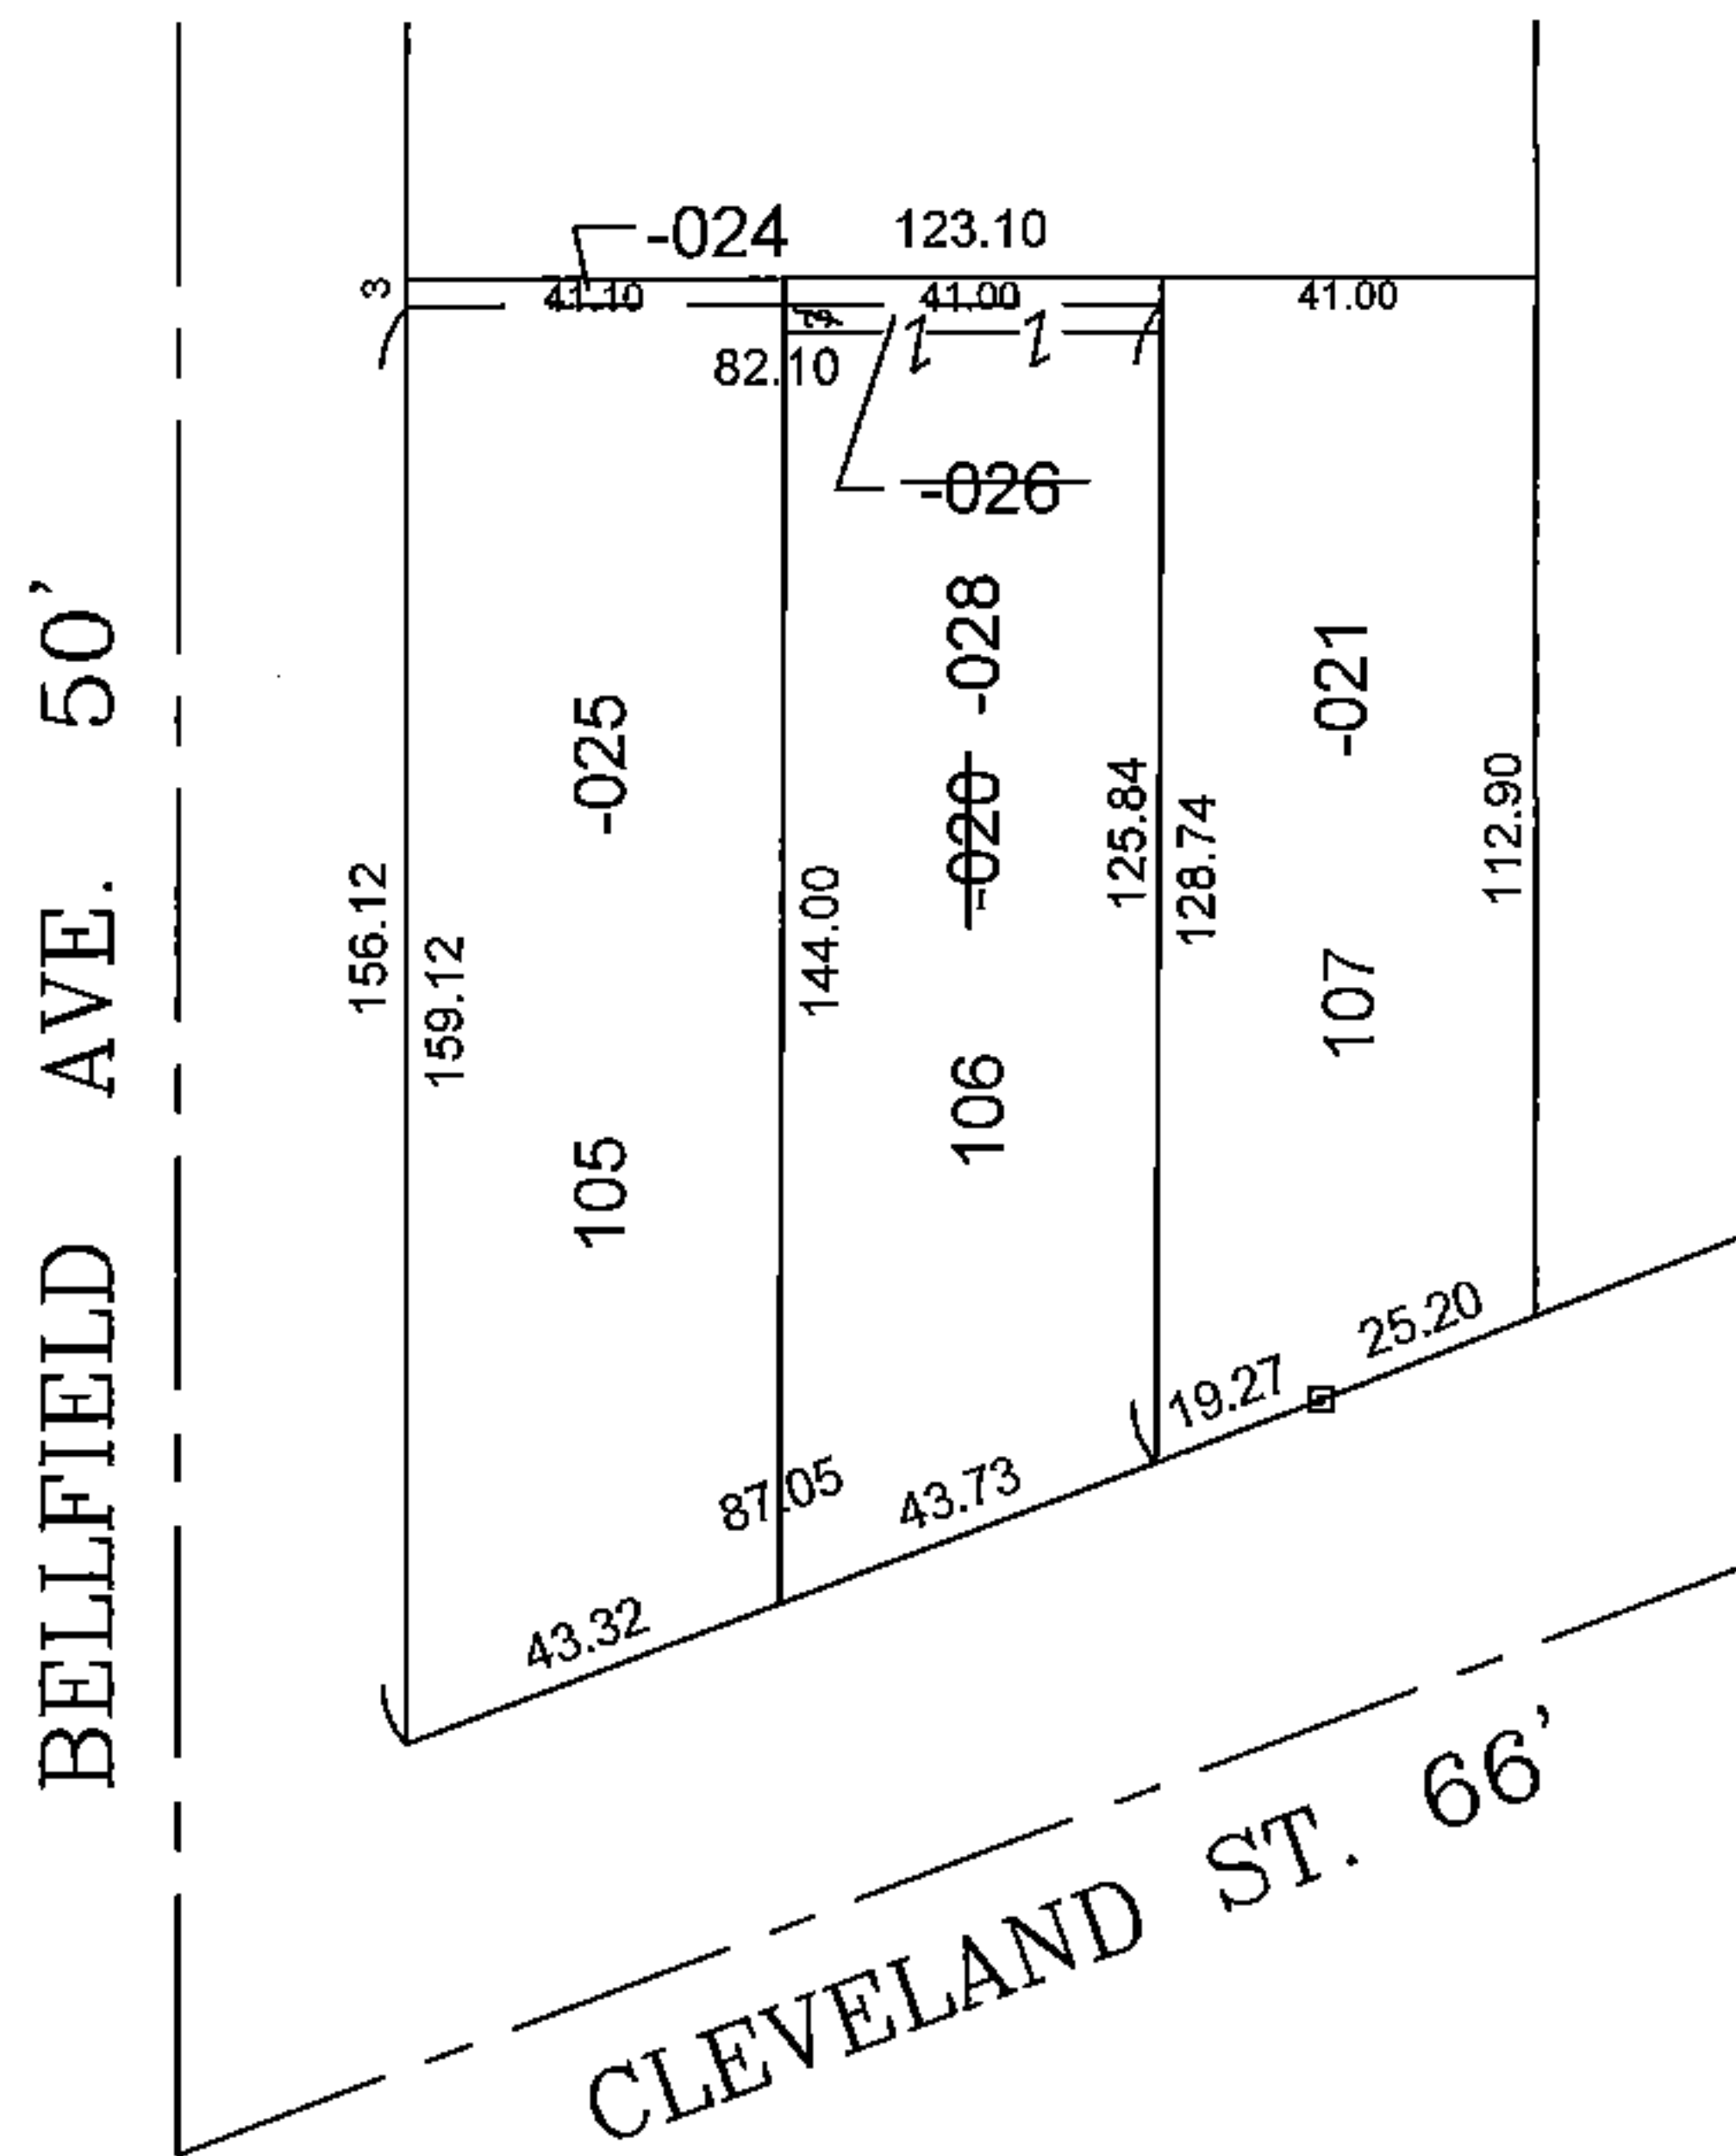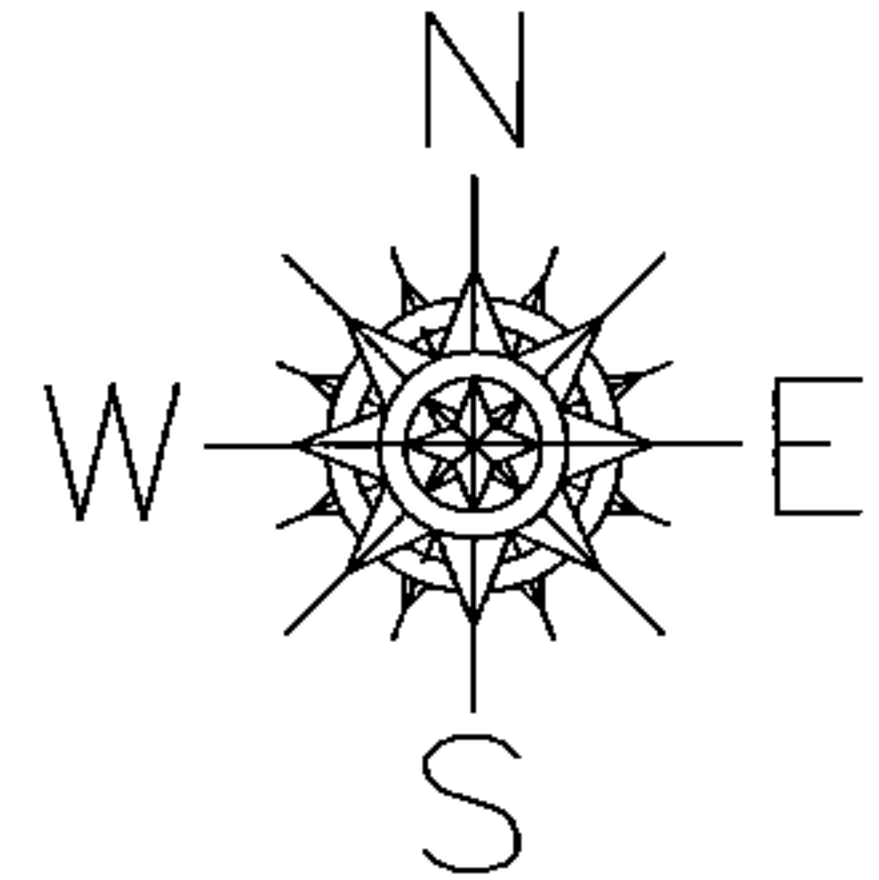

### SPLITS/DEEDS PROCESSED

LORAIN COUNTY TAX MAP DEPARTMENT  
226 MIDDLE AVE. ELYRIA, OHIO

SURVEYED BY: NA

CLOSURE: NA

MAP PAGE(S): 06-25-018

APPROVED BY: TJS DATE: 2/20/15

SCALE: 1"= 50' PRIOR INST.: 20150534841