
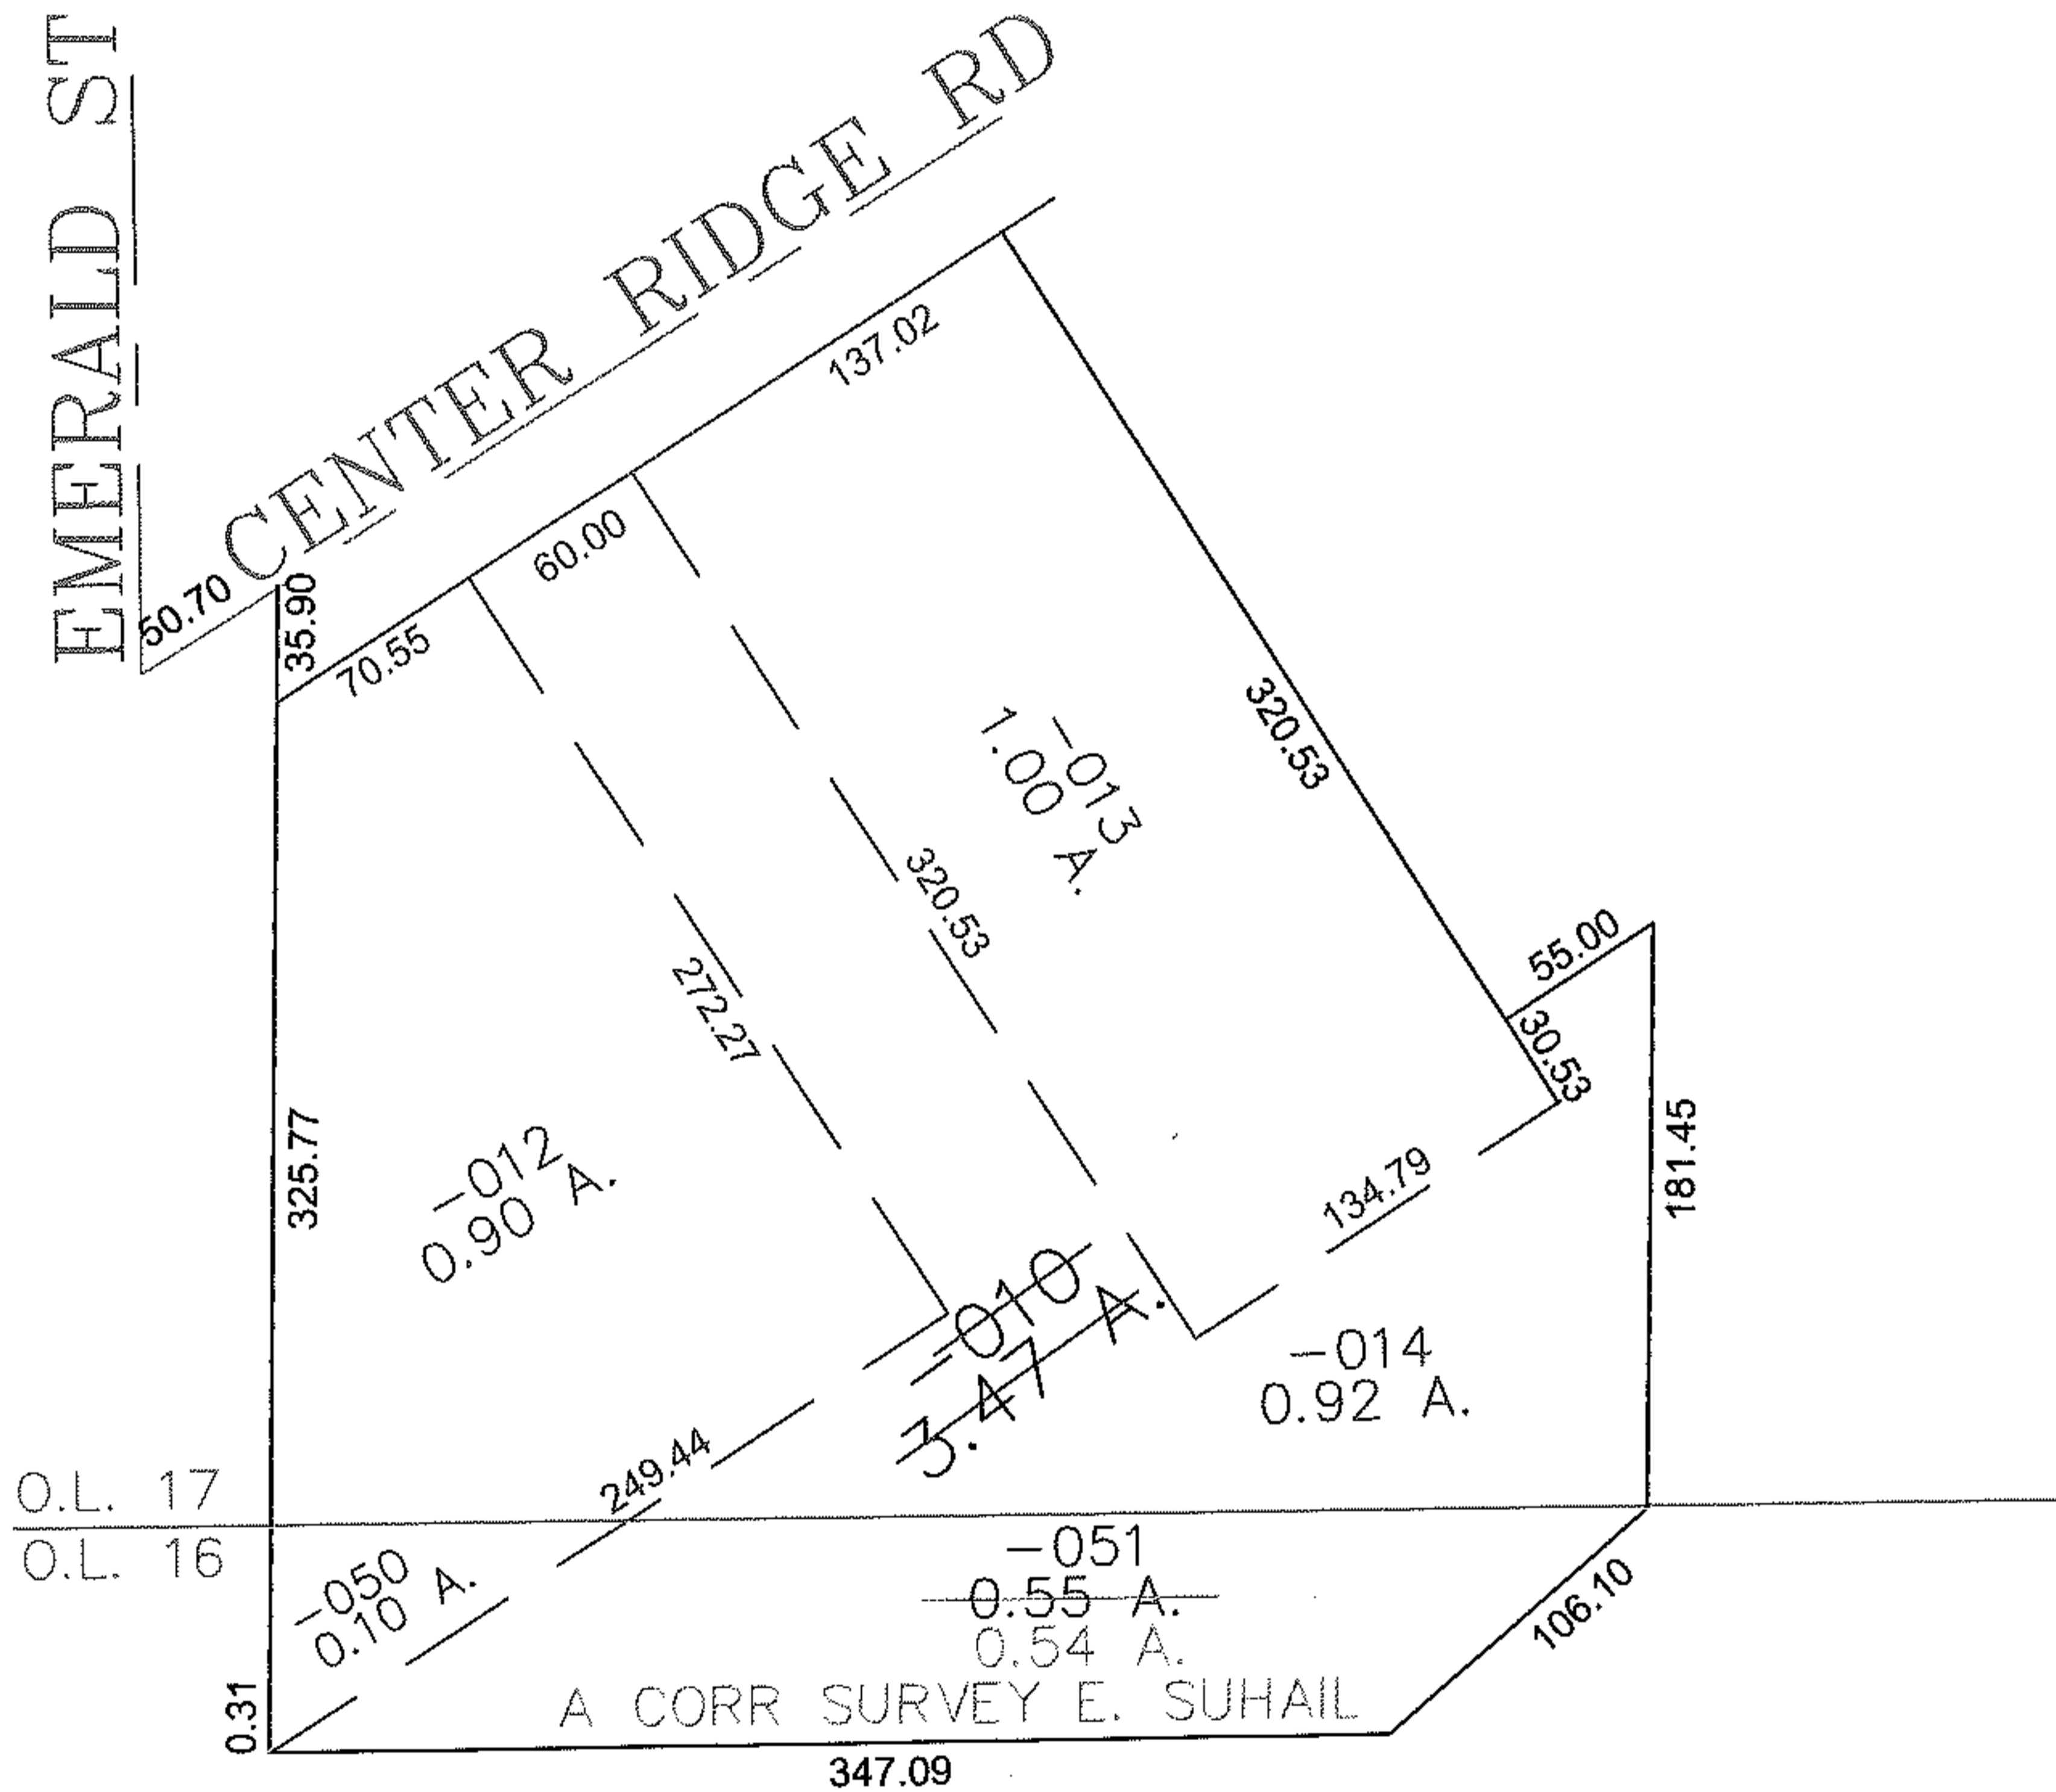


PARENT PARCEL: 07-00-017-130-010

CHILD PARCEL: 07-00-017-130-012, -013, -014 07-00-016-112-050, -051

STARTING POINT: CENTERLINE OF EMERALD ST & CENTER RIDGE RD

13-03119

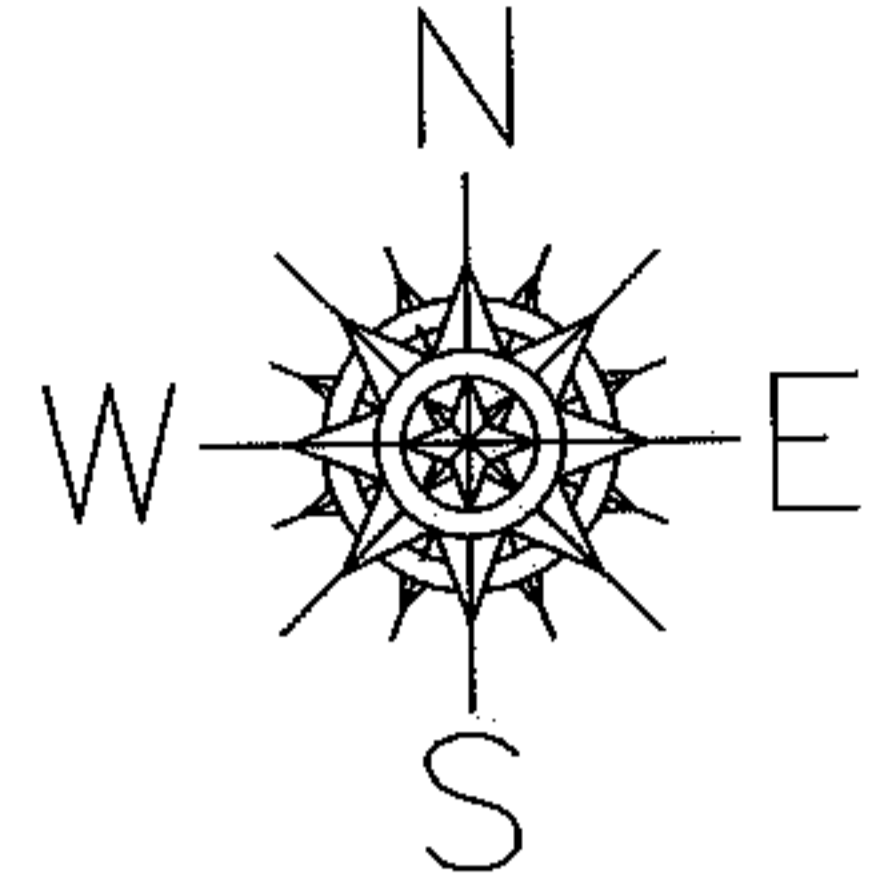

SPLITS/DEEDS PROCESSED

LORAIN COUNTY TAX MAP DEPARTMENT
226 MIDDLE AVE. ELYRIA, OHIO

SURVEYED BY: EHTESHAM SUHAIL

CLOSURE: 0.01 : 10.000

MAP PAGE(S): 07-00-017-D

APPROVED BY: JAH DATE: 2-4-2013

SCALE: 1" = 100 PRIOR INSTRUMENT: 99091092077