


PARENT PARCEL: 09-00-106-000-002, -051

CHILD PARCEL: 09-00-106-000-058

STARTING POINT: AT A MON BOX AT THE INTERSECTION OF C/L OF HAMILTON ST. AND C/L OF S.R.58

15-03120-C

HAMILTON ST.

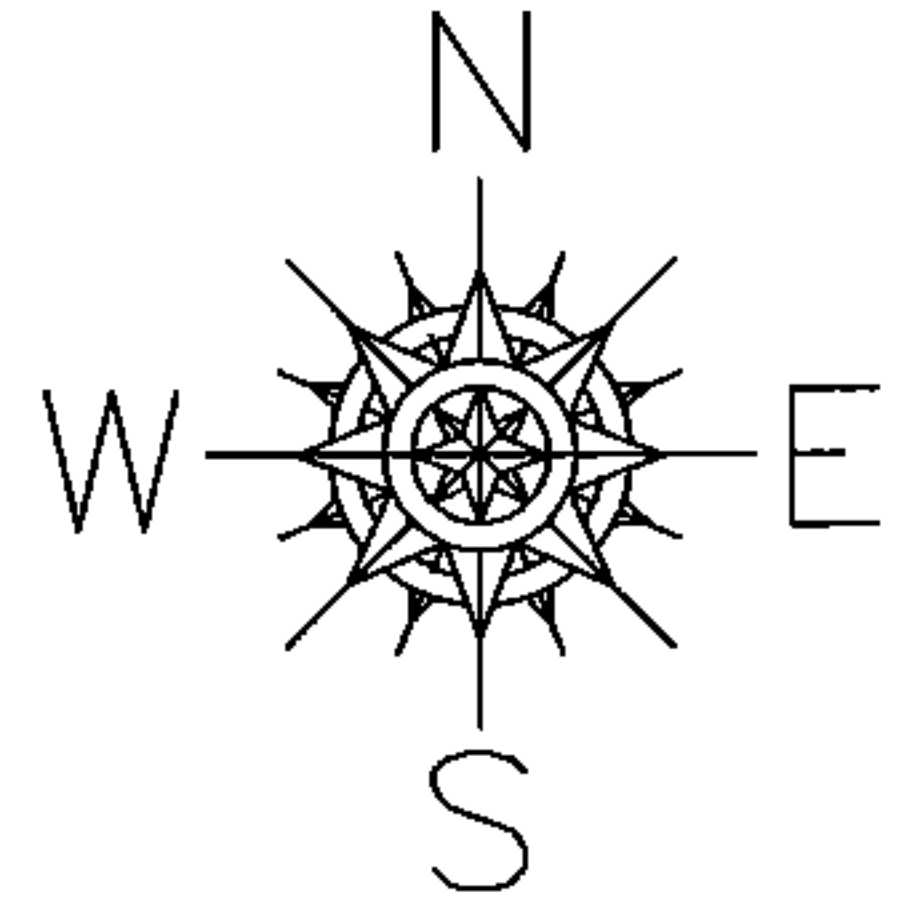

S. MAIN ST. (S.R. 58)

661.09

46.51

318.08

-058

~~-002~~
0.49 A.


~~0.71 A.~~
0.72 A.

~~-051~~
0.22 A.

AC. CORR. PER. SURV.
T. SIMON
318.22

99.00

99.00

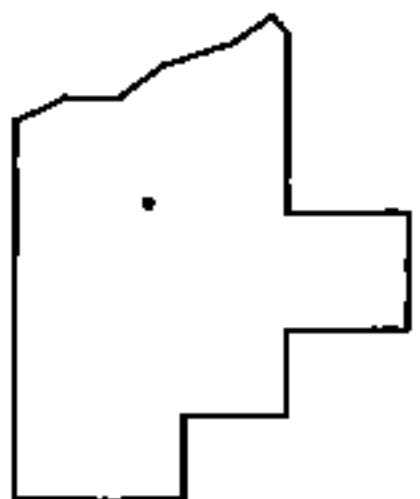

SPLITS/DEEDS PROCESSED

LORAIN COUNTY TAX MAP DEPARTMENT
226 MIDDLE AVE. ELYRIA, OHIO

SURVEYED BY: THOMAS A. SIMON

CLOSURE: .00:10,000

MAP PAGE(S): 9-00-106-A

APPROVED BY: RRM DATE: 3-10-15

SCALE: 1" = 100 PRIOR INST.: 20120407040