


PARENT PARCEL: 04-00-027-103-013

CHILD PARCEL: N/A


STARTING POINT: CENTERLINE OF LEAR NAGLE RD & CHERRY ST

13-03120

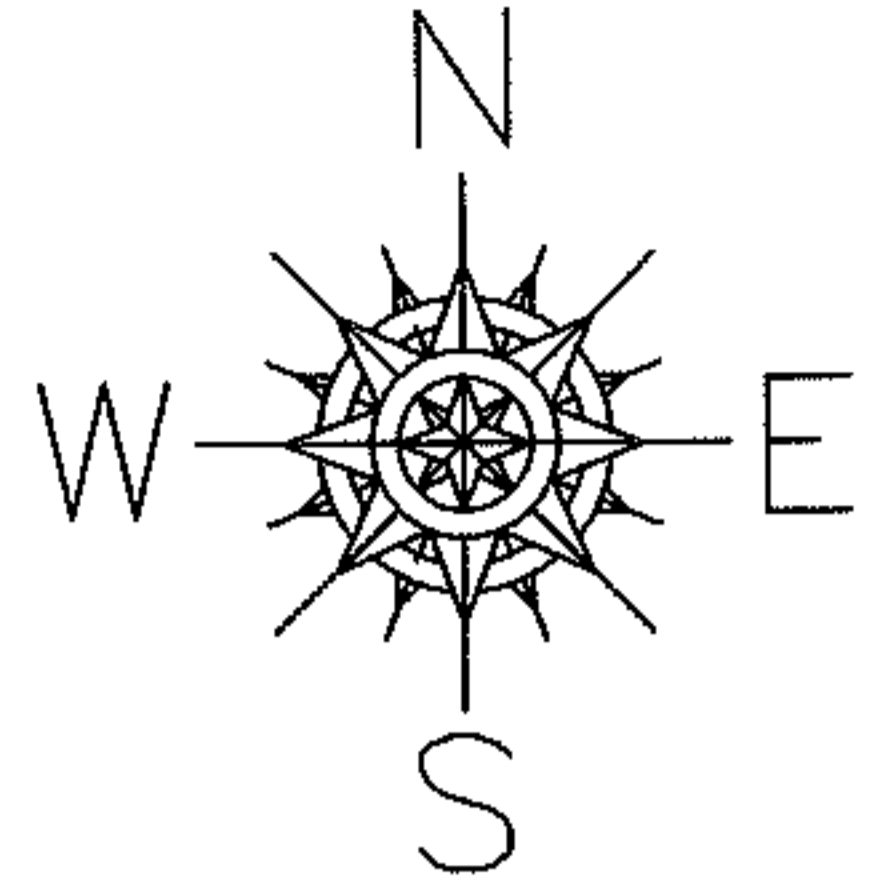

LEAR NAGLE RD

CHERRY

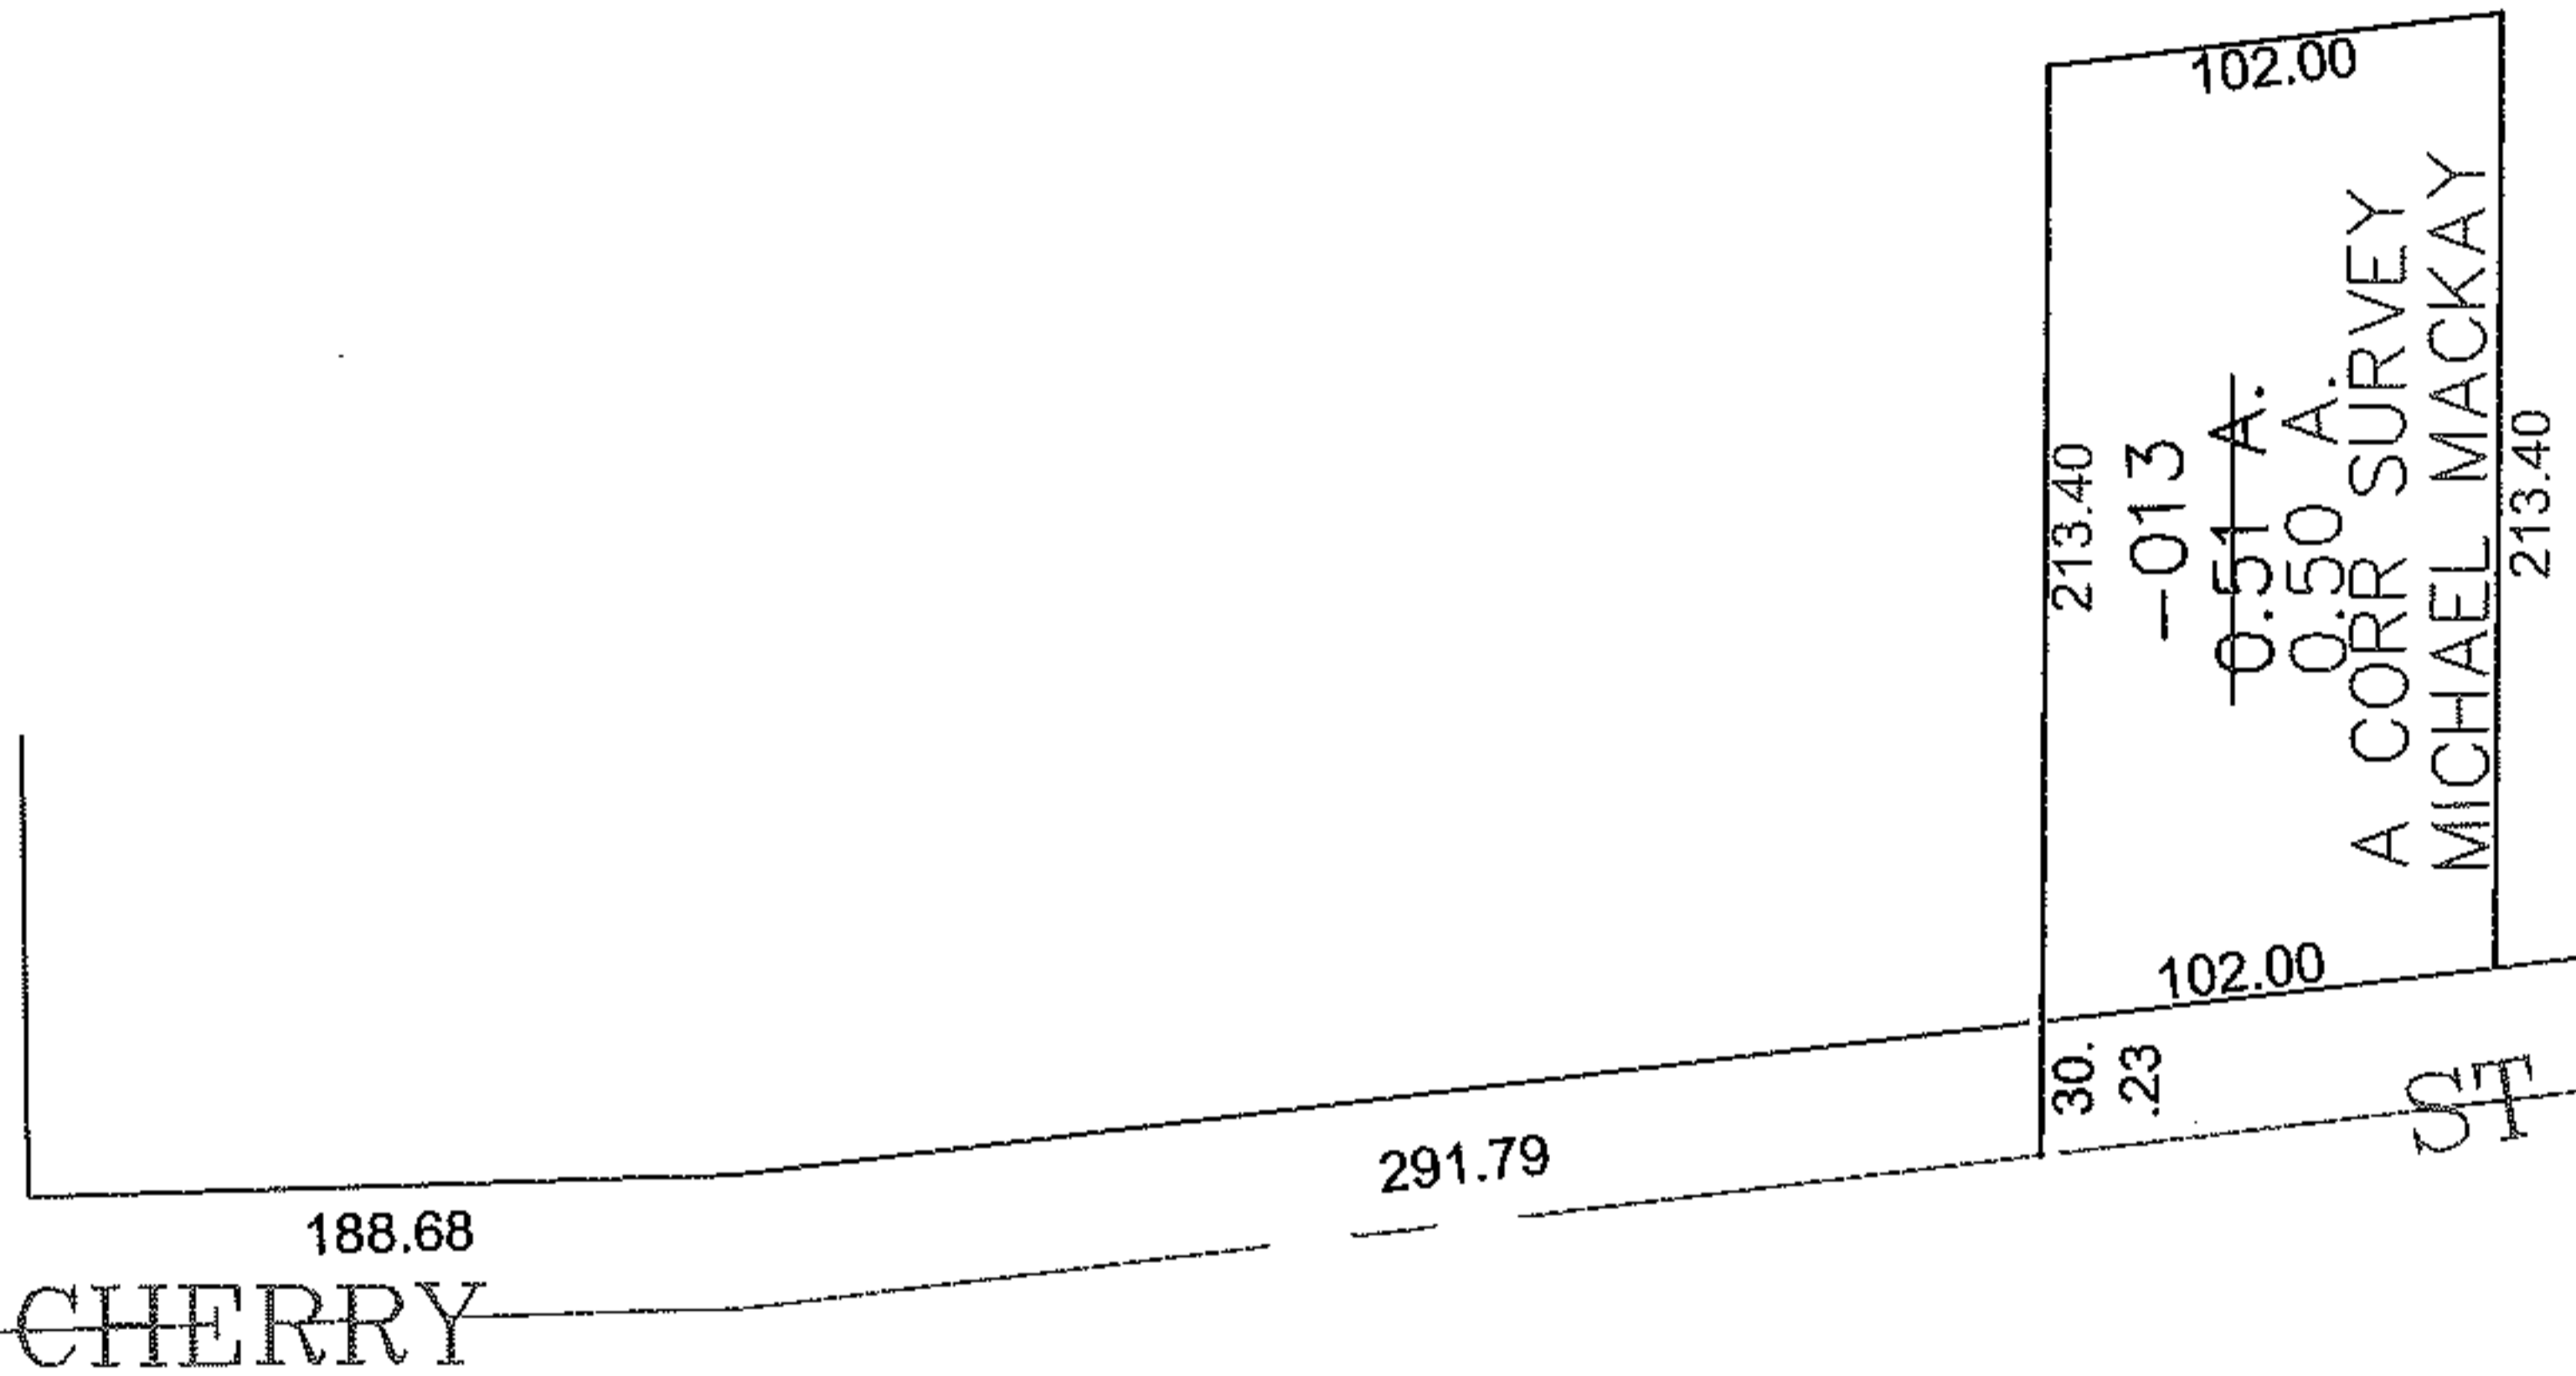

SPLITS/DEEDS PROCESSED

LORAIN COUNTY TAX MAP DEPARTMENT
226 MIDDLE AVE. ELYRIA, OHIO

SURVEYED BY: MICHAEL MACKAY

CLOSURE: 0.00 : 10.000

MAP PAGE(S): 04-00-027-E

APPROVED BY: JAH DATE: 2-5-2013

SCALE: 1" = 100' PRIOR INSTRUMENT: DV 1394/73