
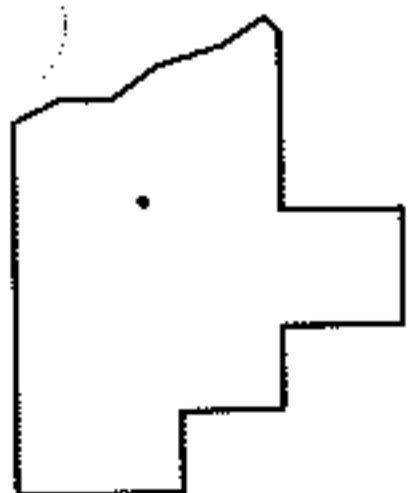
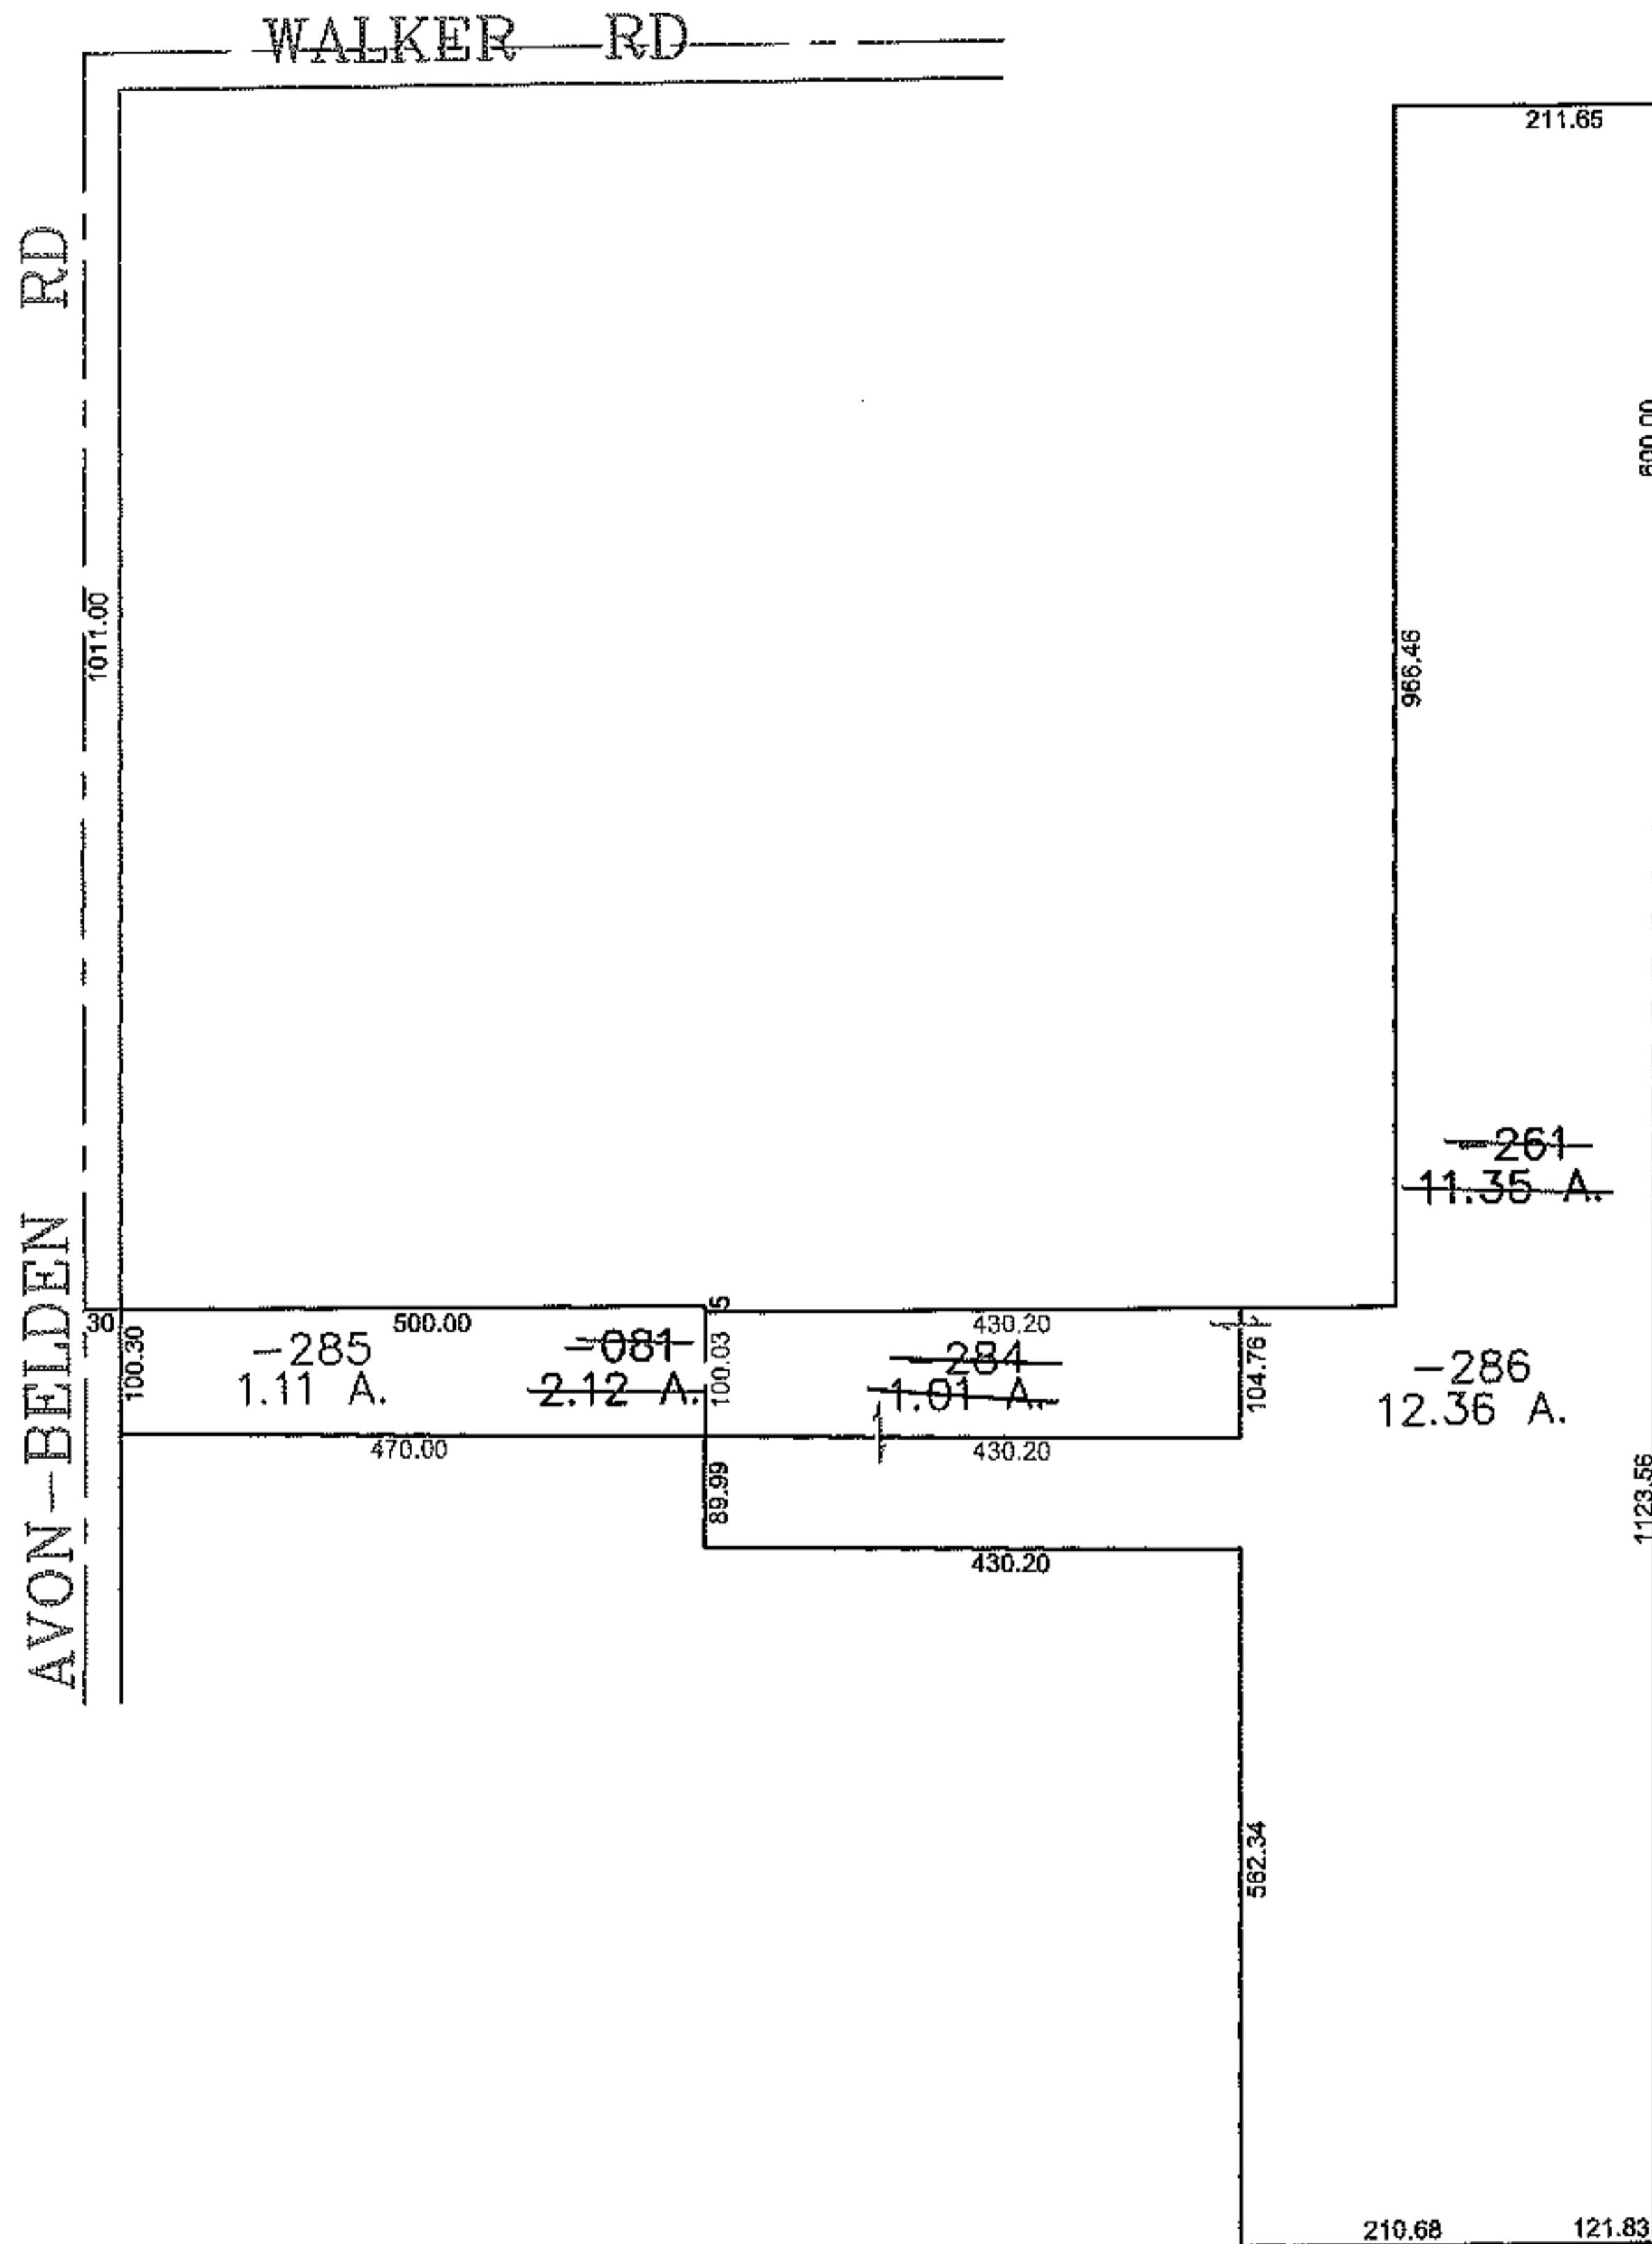


PARENT PARCEL: 04-00-017-103-081

CHILD PARCEL: 04-00-017-103-284, -285, -286

STARTING POINT: CENTERLINE OF AVON-BELDEN RD & WALKER RD

13-03122

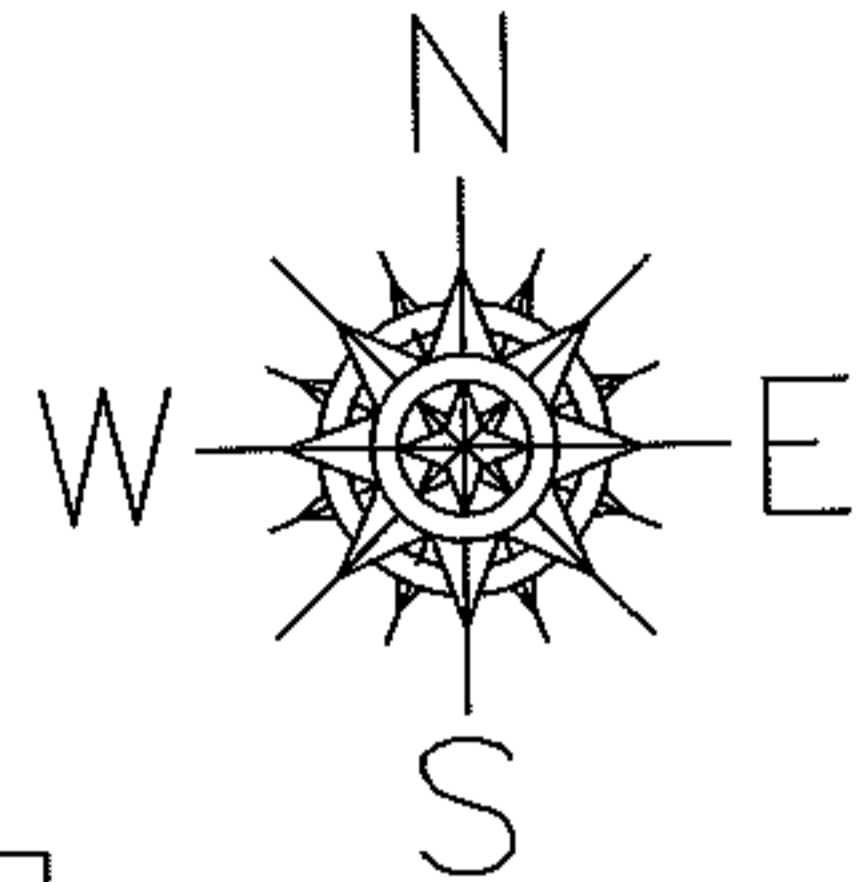

SPLITS/DEEDS PROCESSED
LORAIN COUNTY TAX MAP DEPARTMENT
 226 MIDDLE AVE. ELYRIA, OHIO

SURVEYED BY: JAMES T SAYLER
 CLOSURE: 0.00 : 10.000
 MAP PAGE(S): 04-00-017-C
 APPROVED BY: JAH DATE: 2/19/2013
 SCALE: 1" = 300 PRIOR INSTRUMENT: OR 122/161