
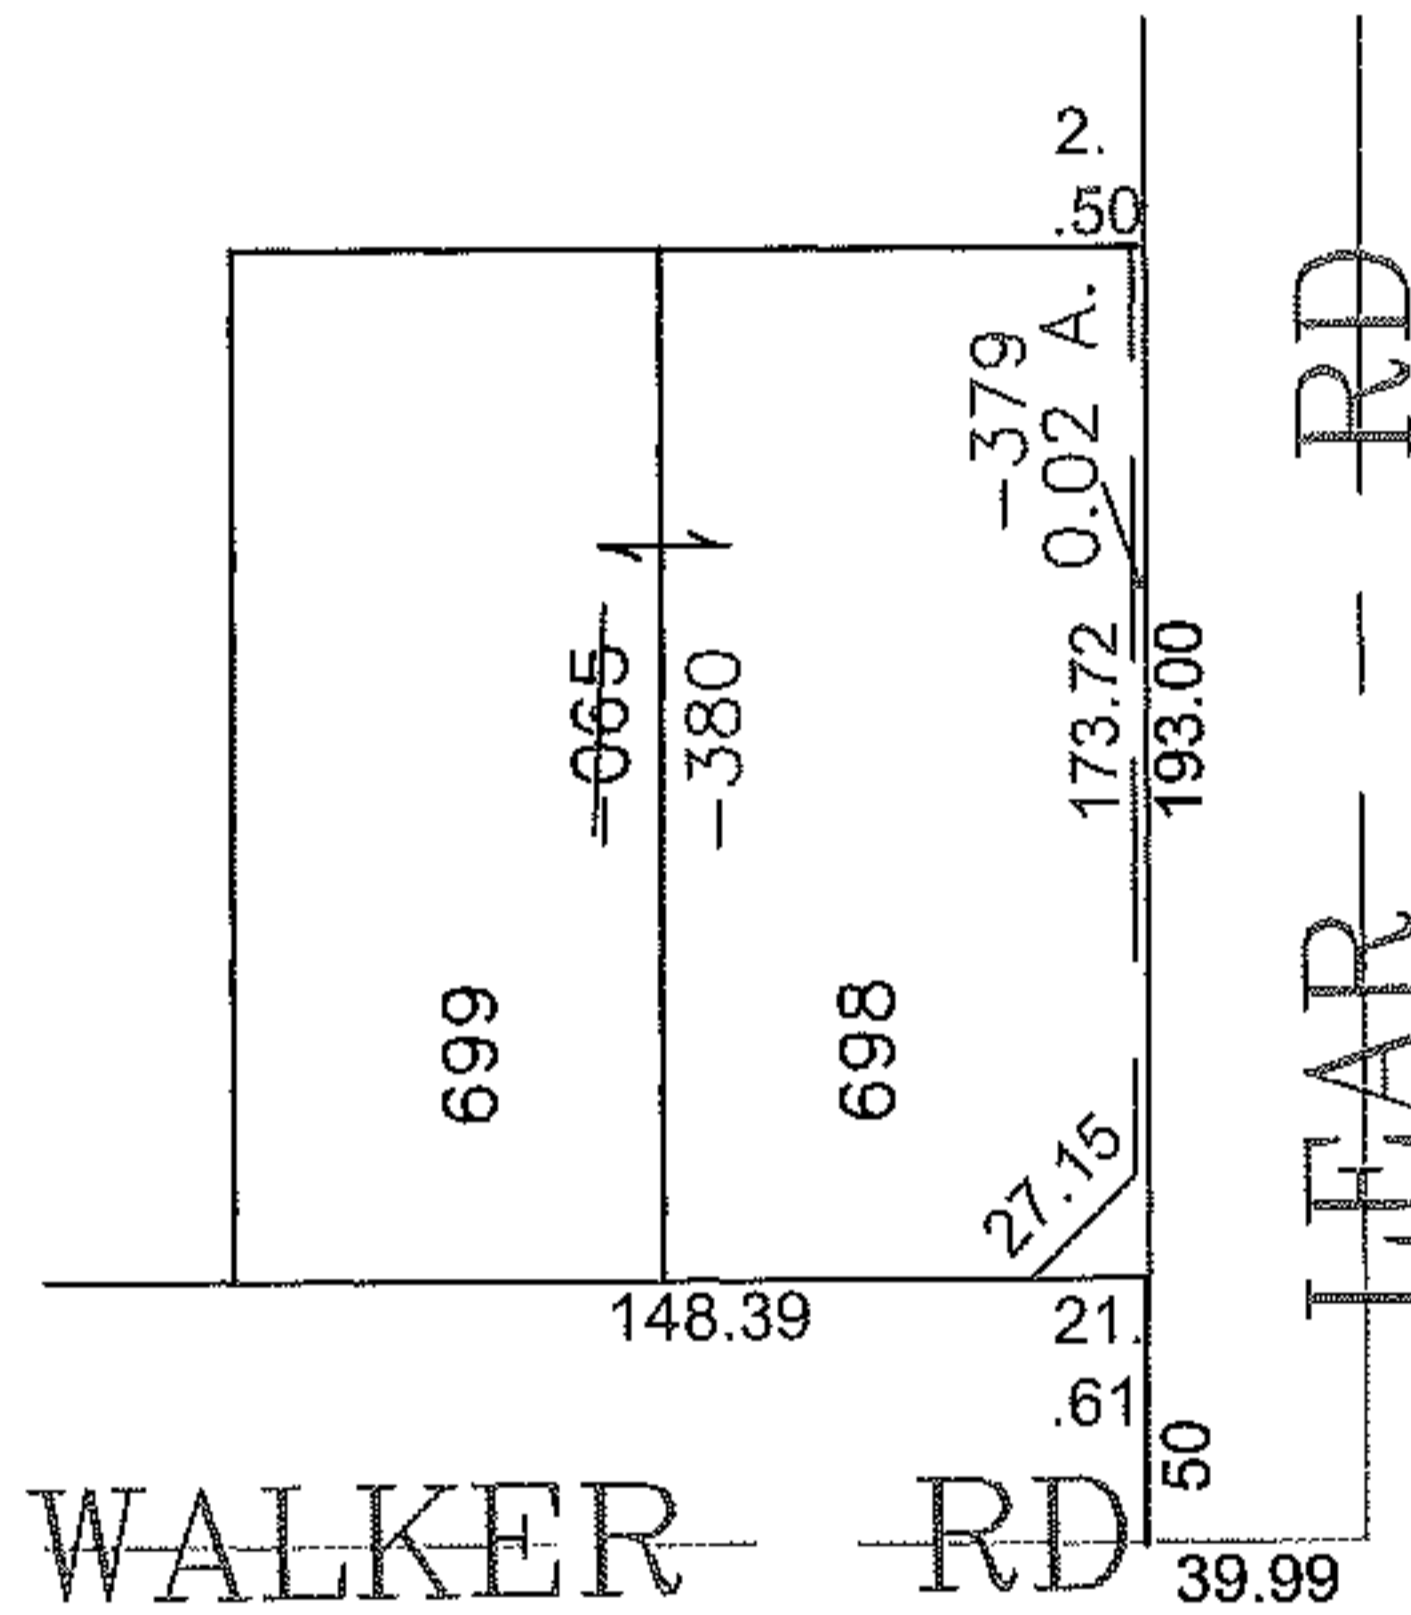


PARENT PARCEL: 04-00-019-144-065

CHILD PARCEL: 04-00-019-144-379, -380

STARTING POINT: CENTERLINE OF WALKER RD & LEAR RD

13-03125

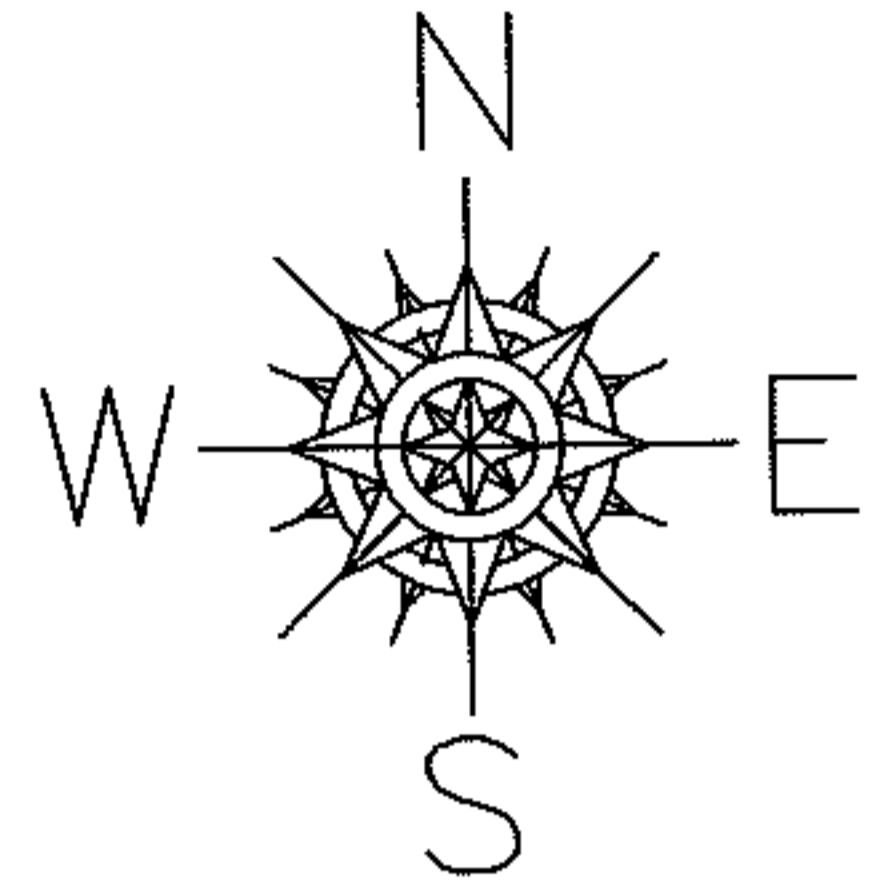

SPLITS/DEEDS PROCESSED

LORAIN COUNTY TAX MAP DEPARTMENT
226 MIDDLE AVE. ELYRIA, OHIO

SURVEYED BY: AMY M KELLY

CLOSURE: 0.00 : 10.000

MAP PAGE(S): 04-00-019-1

APPROVED BY: JAH DATE: 2/26/2013

SCALE: 1" = 100 PRIOR INSTRUMENT: 20010792130