
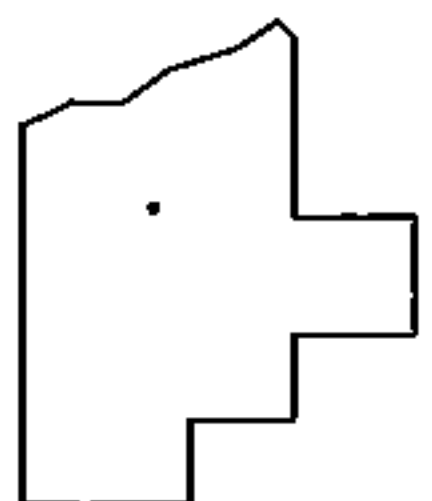
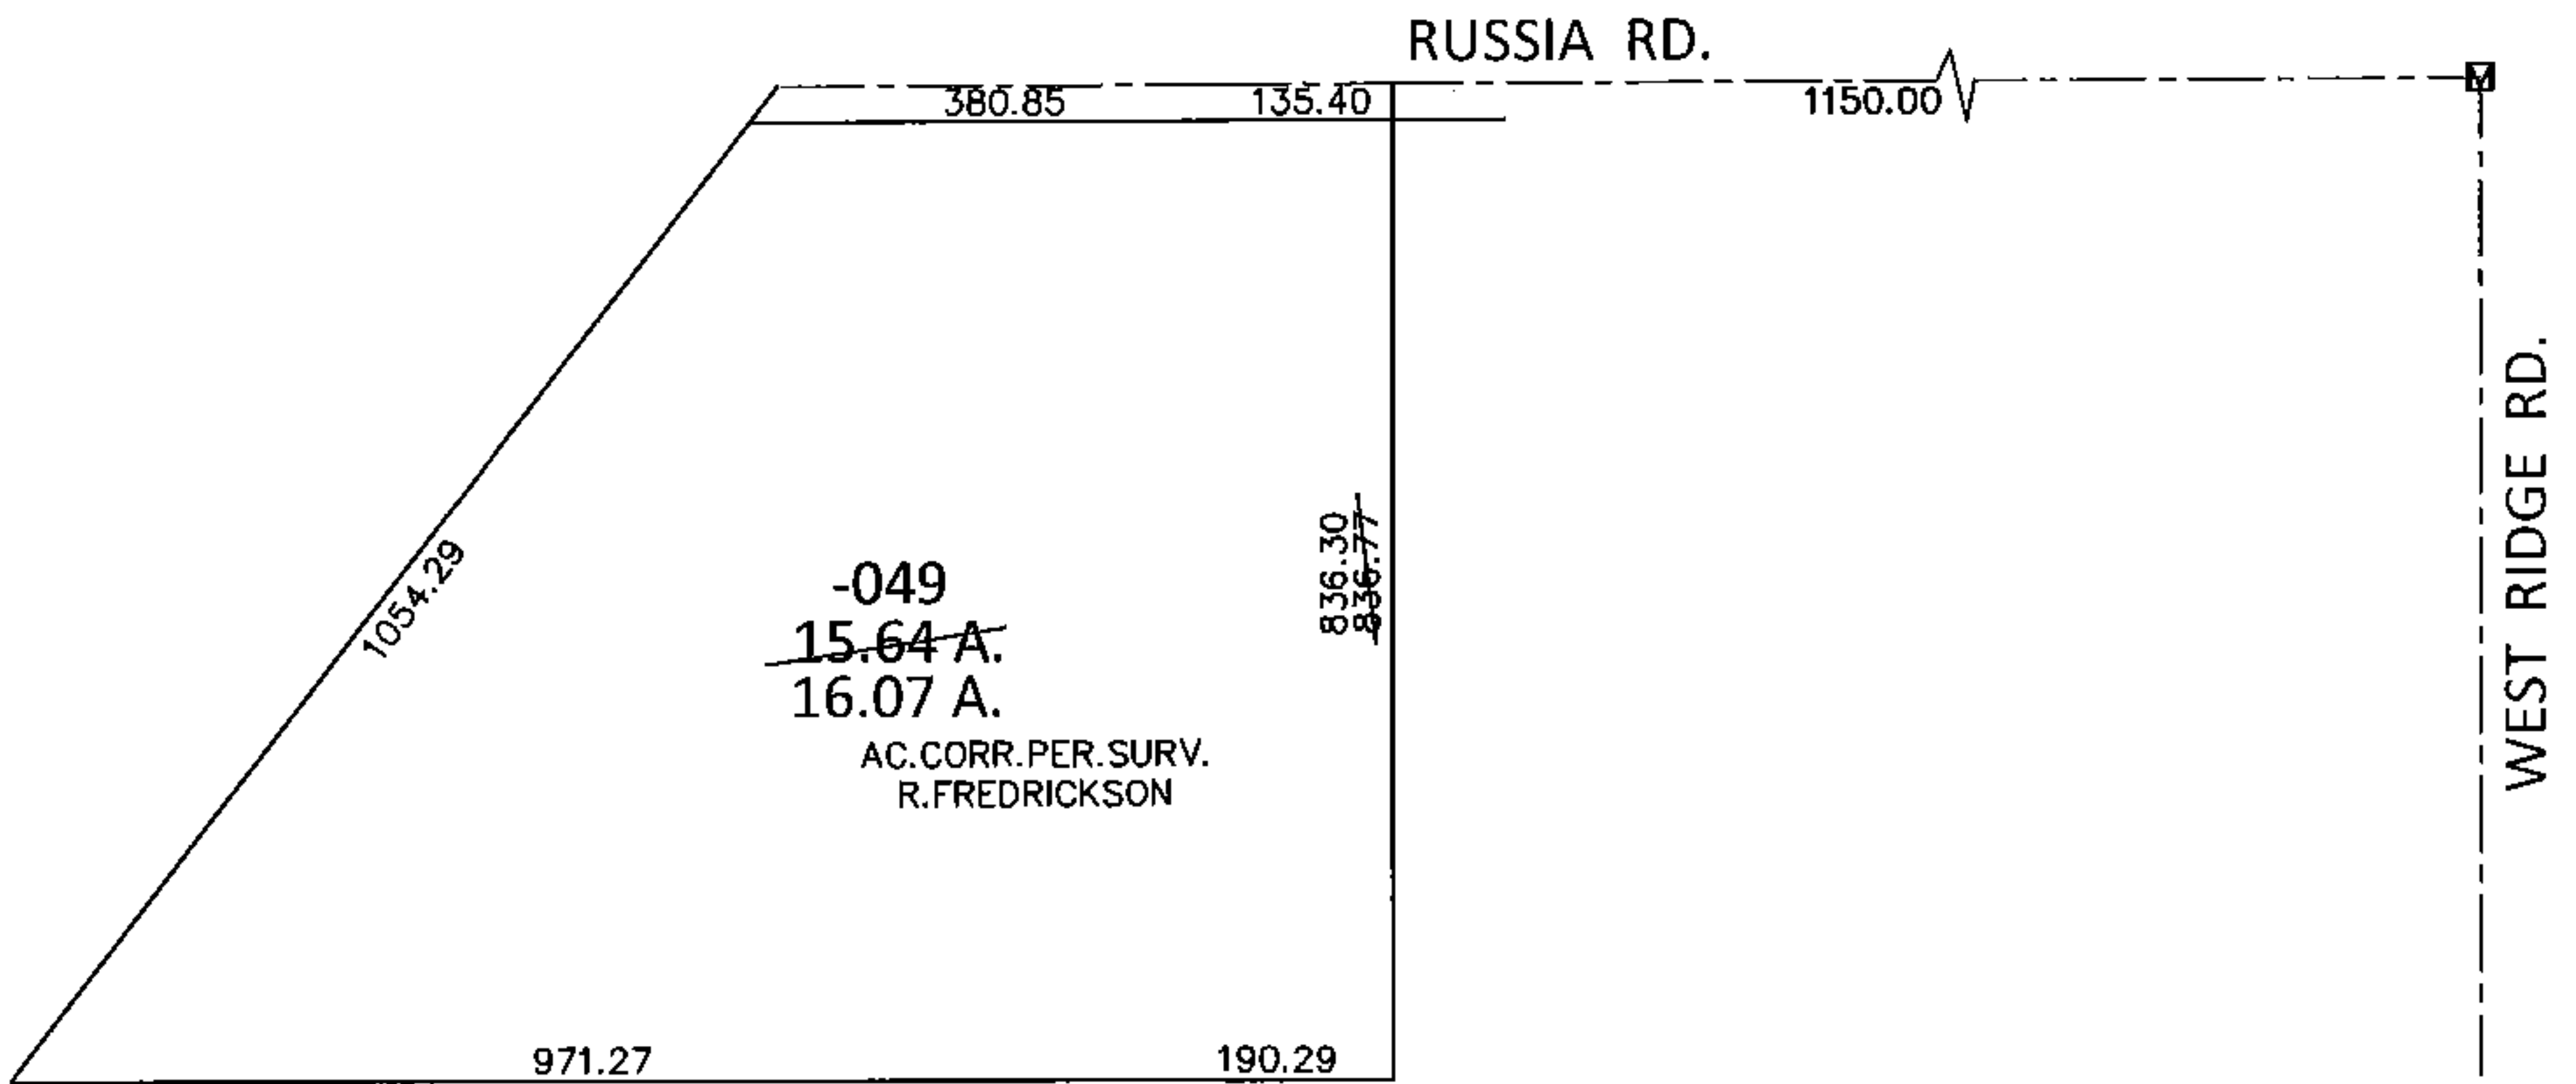


PARENT PARCEL: 10-00-010-000-049

CHILD PARCEL: \_\_\_\_\_

STARTING POINT: AT A MON BOX AT THE INTERSECTION OF C/L OF RUSSIA RD. AND C/L OF WEST RIDGE RD.

**15-03129-A**

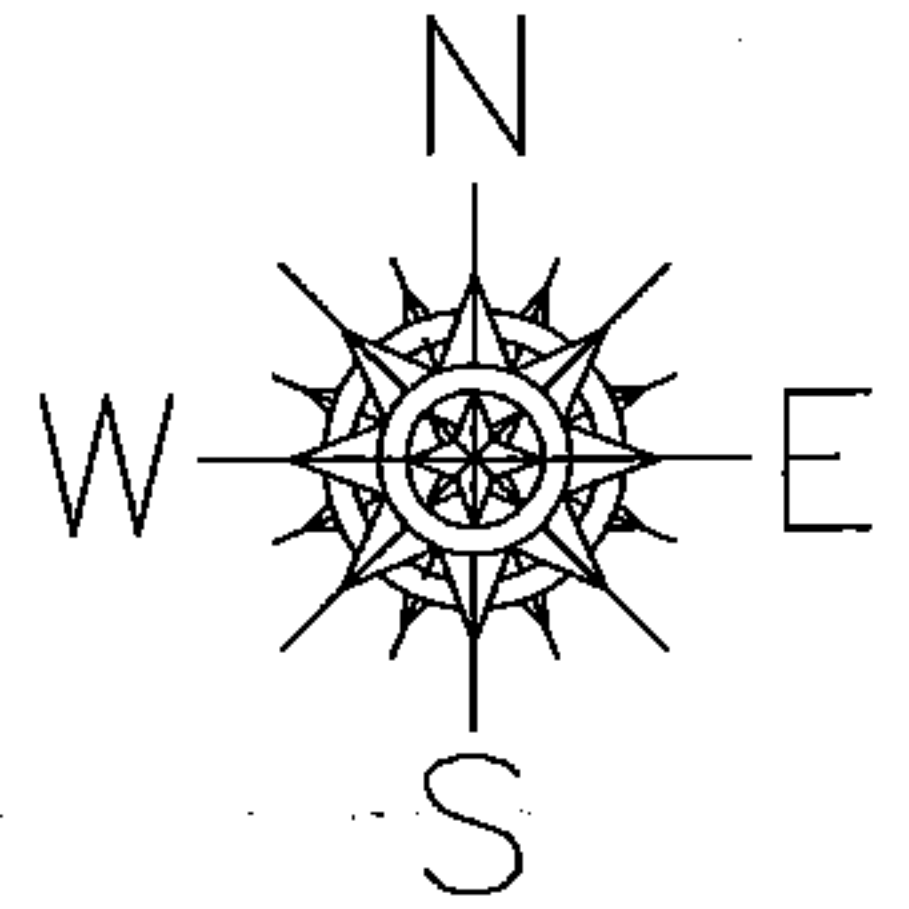

**SPLITS/DEEDS PROCESSED**

LORAIN COUNTY TAX MAP DEPARTMENT  
226 MIDDLE AVE. ELYRIA, OHIO

SURVEYED BY: RICHARD A. FREDRICKSON  
CLOSURE: .01:10,000  
MAP PAGE(S): 10-A  
APPROVED BY: RRM DATE: 3-20-15  
SCALE: 1" = 300 PRIOR INST.: 20060141285