
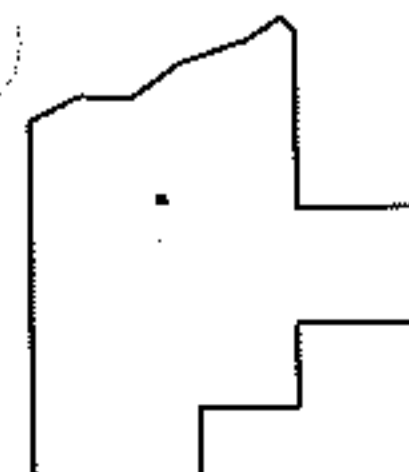
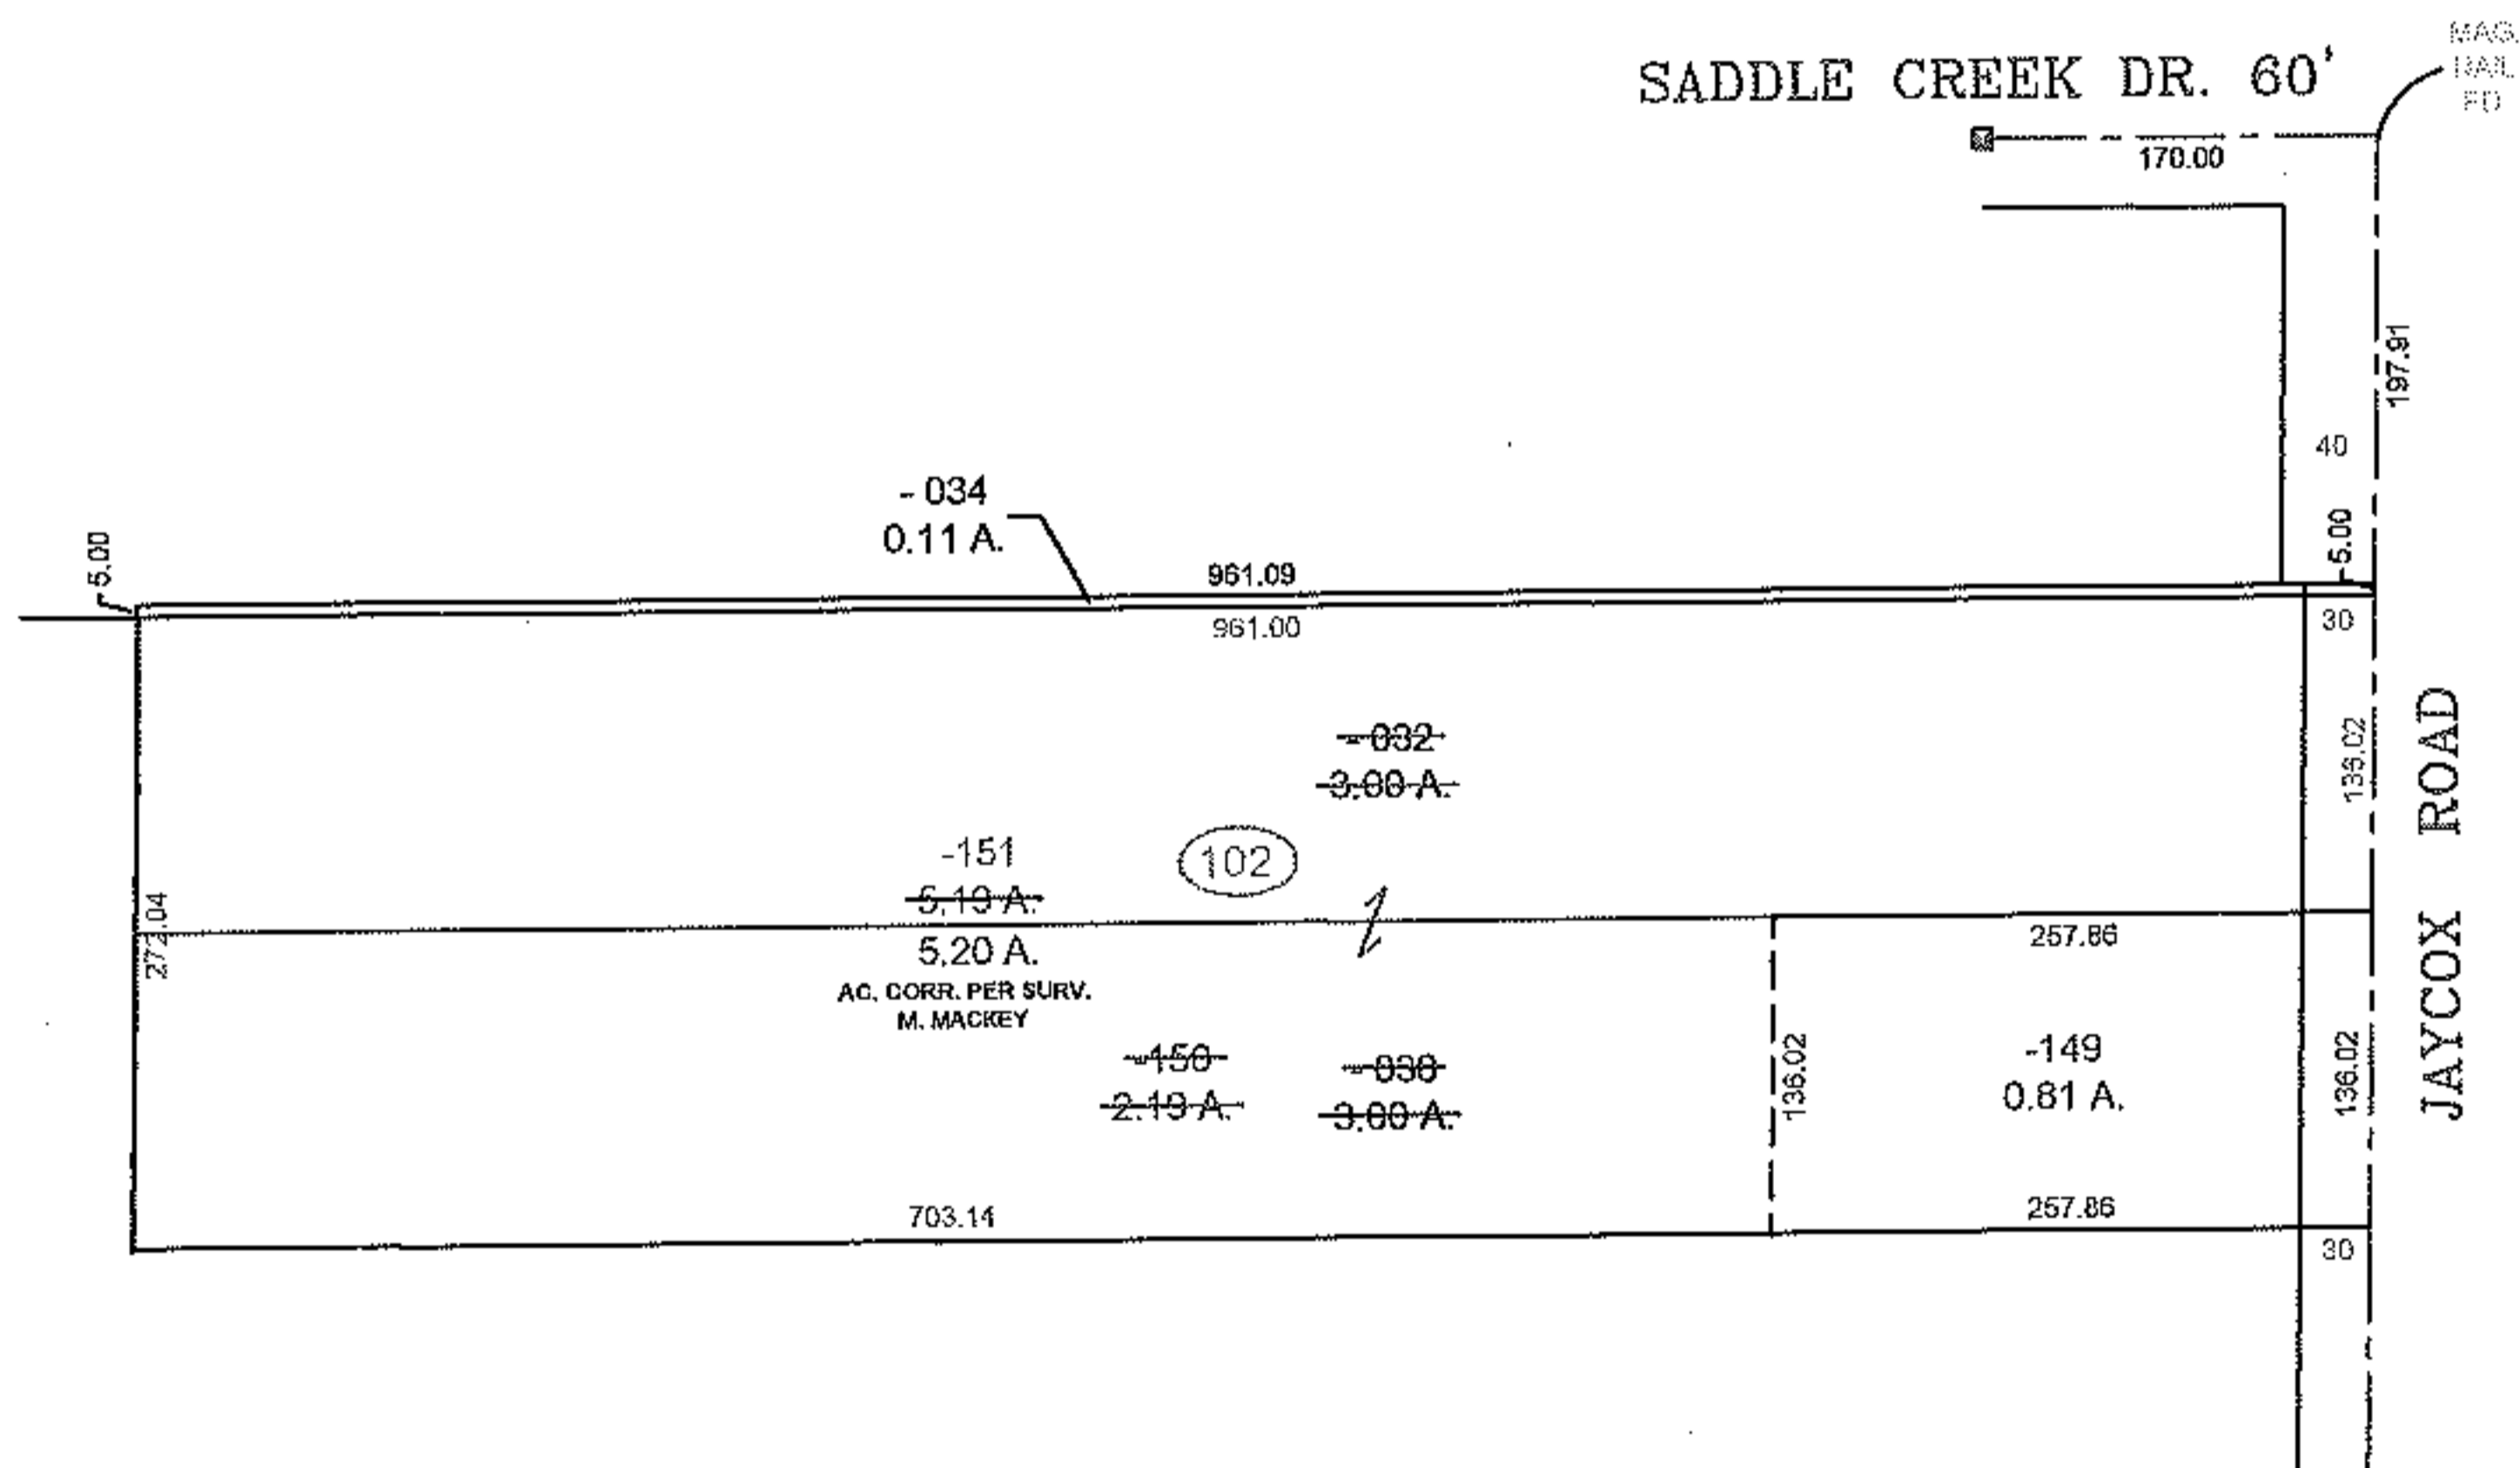


PARENT PARCEL: 04-00-023-102-030 & -032
 CHILD PARCEL: 04-00-023-102-149 THRU -151
 STARTING POINT: MON. BOX, CL OF SADDLE CREEK DR. 170.00 FEET FROM MAG. NAIL AT THE
 INTERSECTION OF THE CL OF SADDLE CREEK DR. & CL OF JAYCOX RD.

13-03129

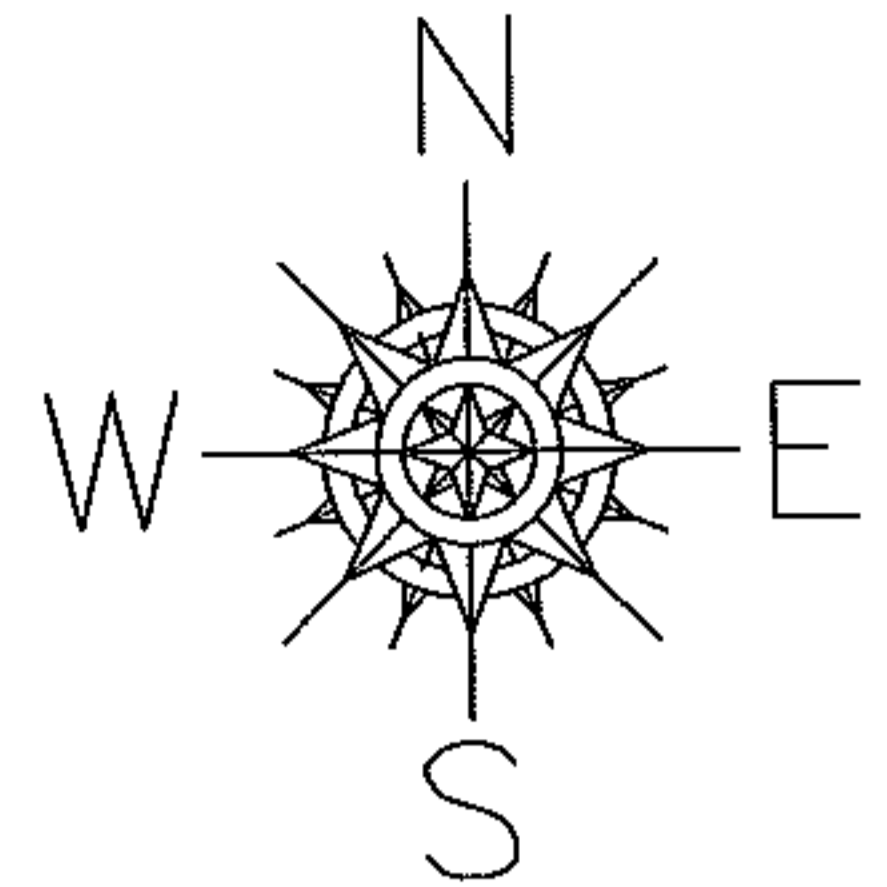

SPLITS/DEEDS PROCESSED
 LORAIN COUNTY TAX MAP DEPARTMENT
 226 MIDDLE AVE. ELYRIA, OHIO

SURVEYED BY: MICHAEL MACKAY
 CLOSURE: 0.00 : 10,000
 MAP PAGE(S): 4-00-023-B
 APPROVED BY: TJS DATE: 3/20/13
 SCALE: 1" = 200 PRIOR INSTRUMENT: 20060179213