

PARENT PARCEL: 12-00-047-102-034 & -050

CHILD PARCEL: XX-XX-XXX-XXX-XXX

STARTING POINT: S/L 32 IN HOMER C. AKIN SUBDIVISION P.V. 22 PG. 48

15-03130-C




MAP & ACREAGE CORRECTION

12-00-047-102-050

~~64.56 X 84~~

19.11 X 32.56

SURVEY BEFORE NEXT TRANSFER
DOESN'T CLOSE

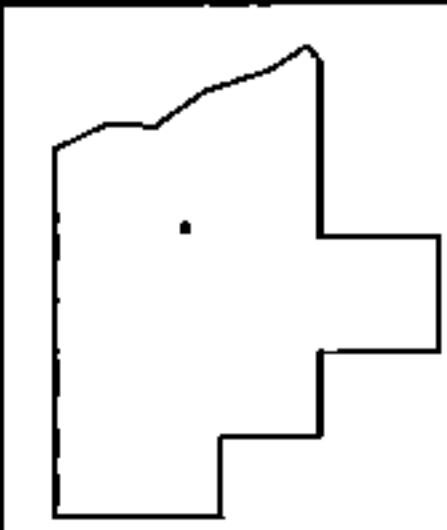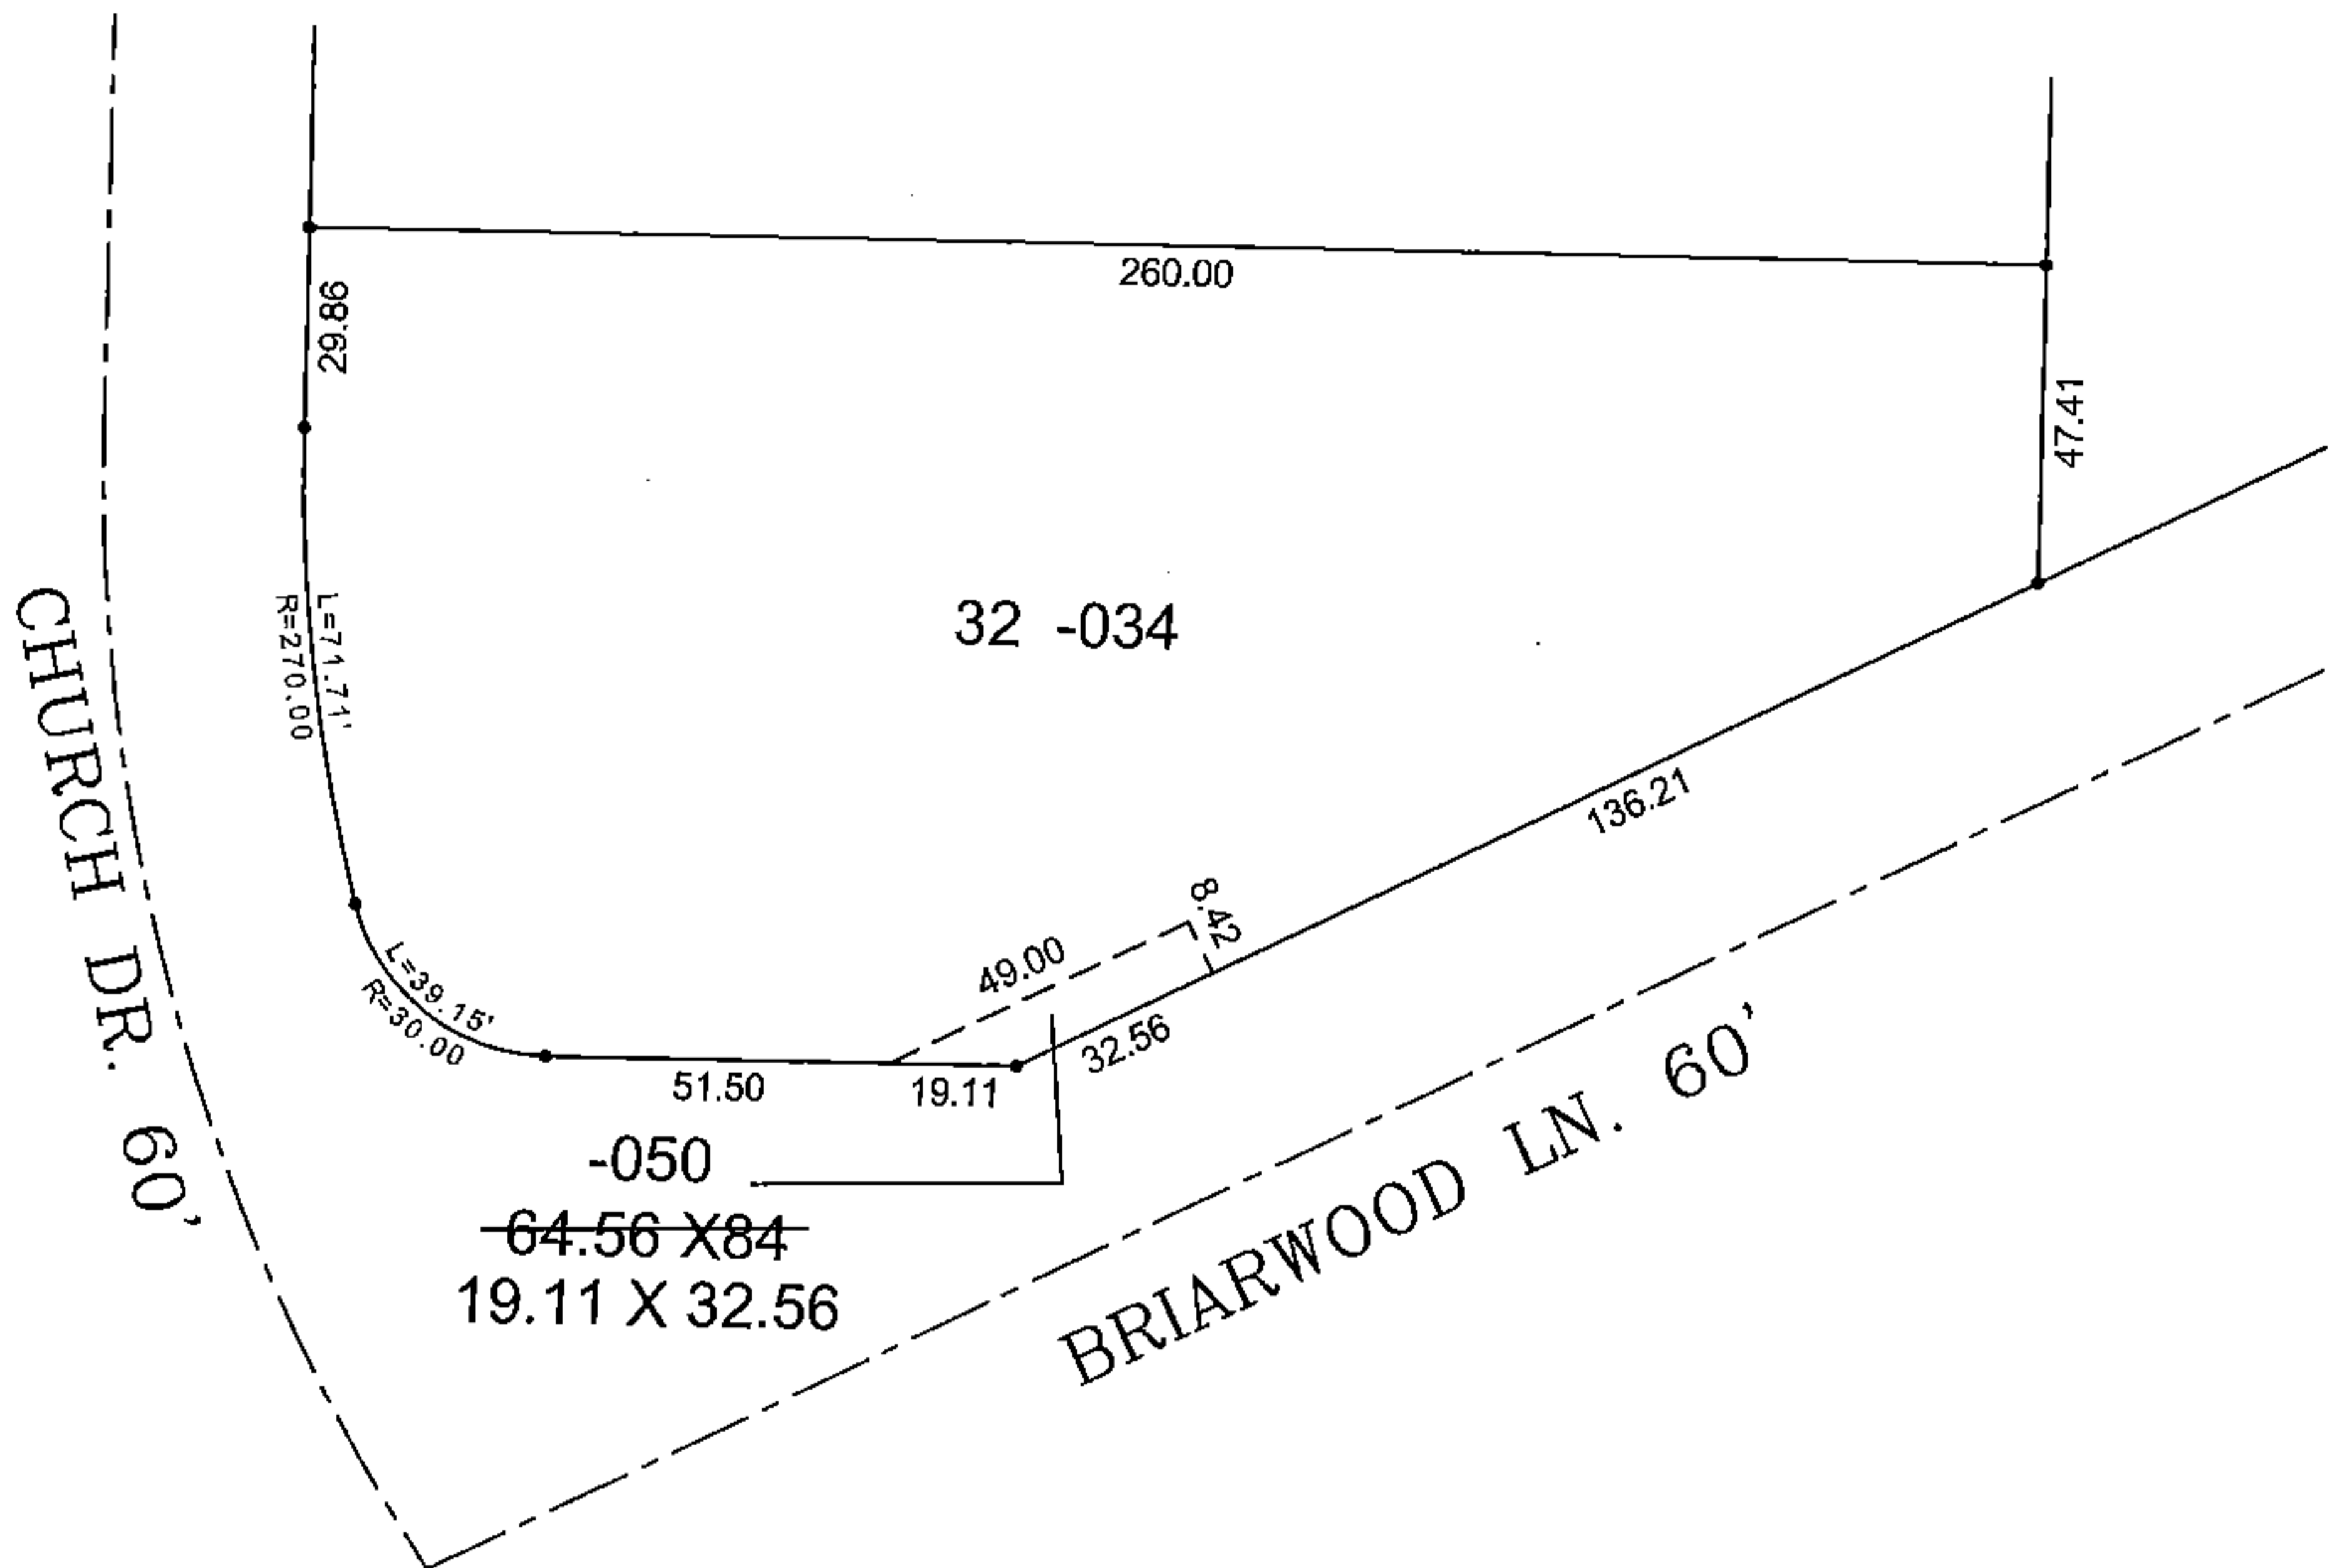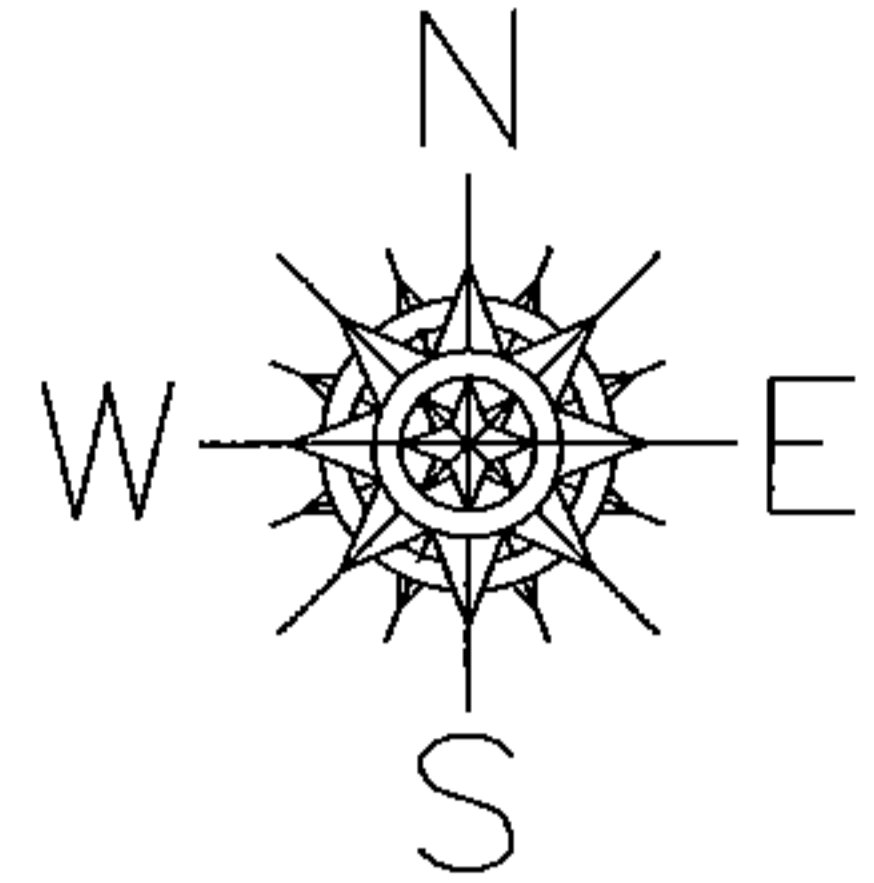

SPLITS/DEEDS PROCESSED

LORAIN COUNTY TAX MAP DEPARTMENT
226 MIDDLE AVE. ELYRIA, OHIO

SURVEYED BY: A.D. JEANCOLA

CLOSURE: 1: 163

MAP PAGE(S): 12-00-047

APPROVED BY: TJS DATE: 3/20/15

SCALE: 1"= 50' PRIOR INST.: DV XXXX/XXX