
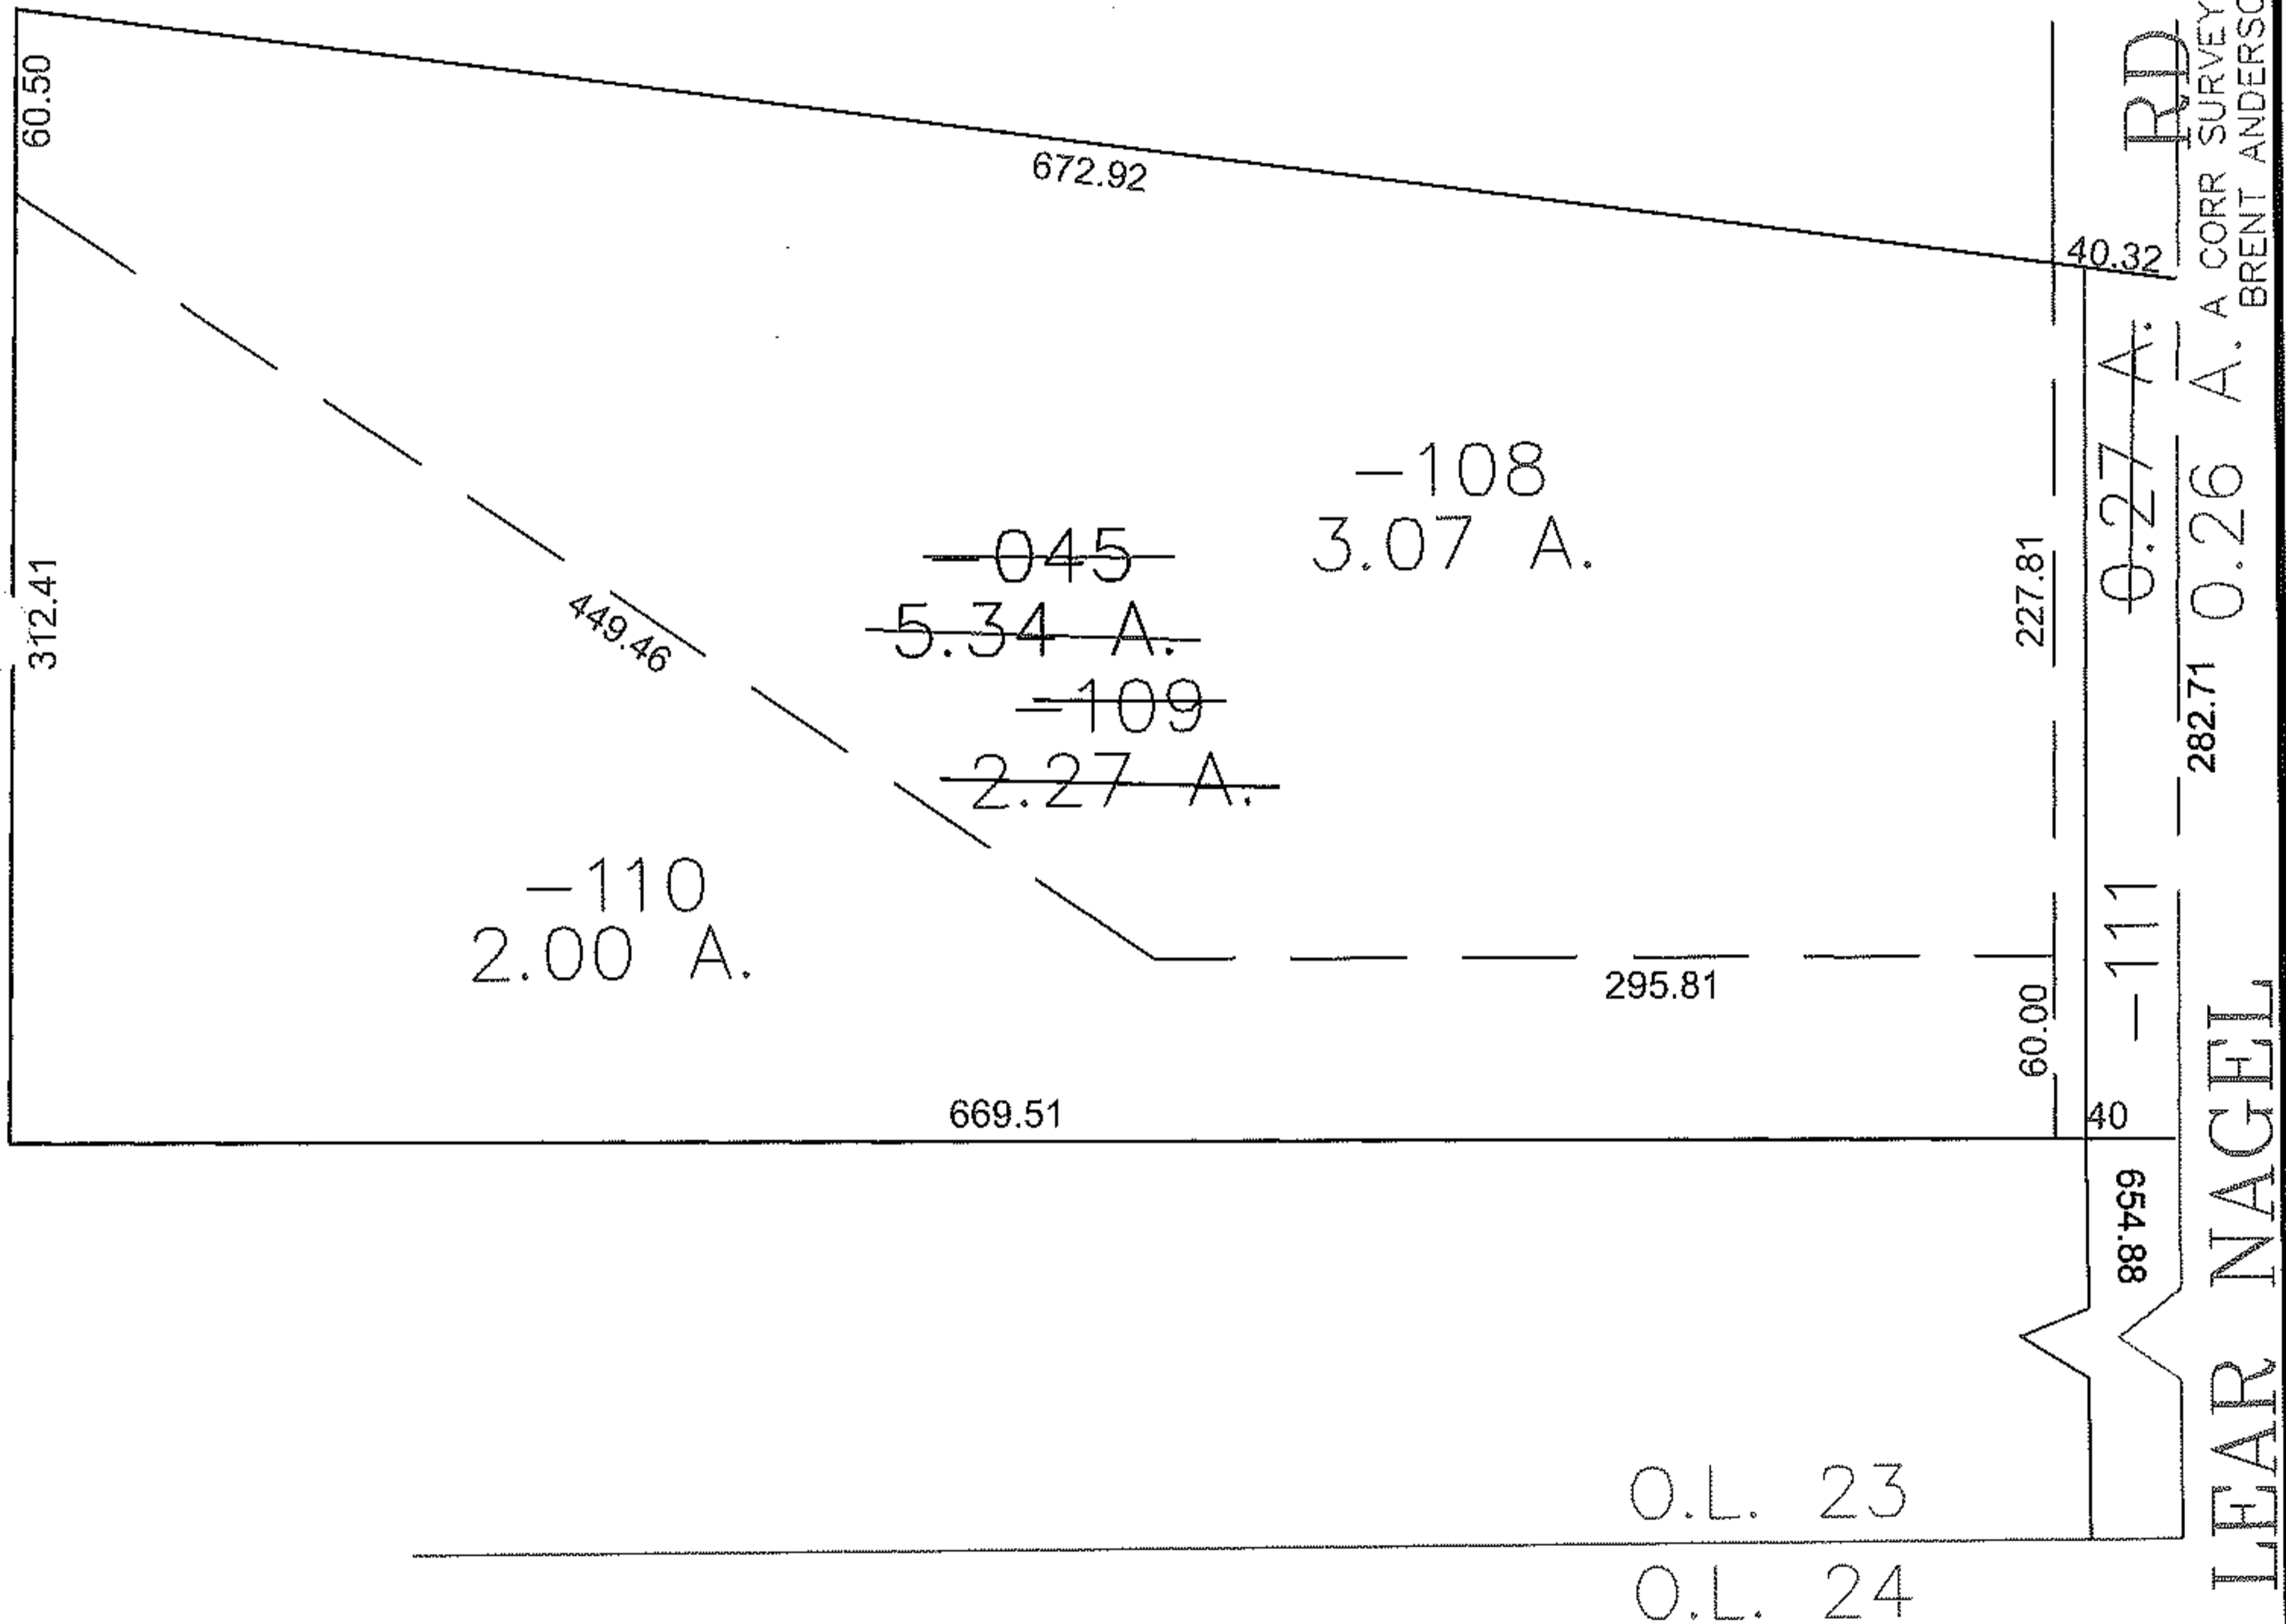


PARENT PARCEL: 04-00-023-110-045

CHILD PARCEL: 04-00-023-110-108 THRU -111

STARTING POINT: CENTERLINE OF NAGEL RD & O.L. 23

13-03130

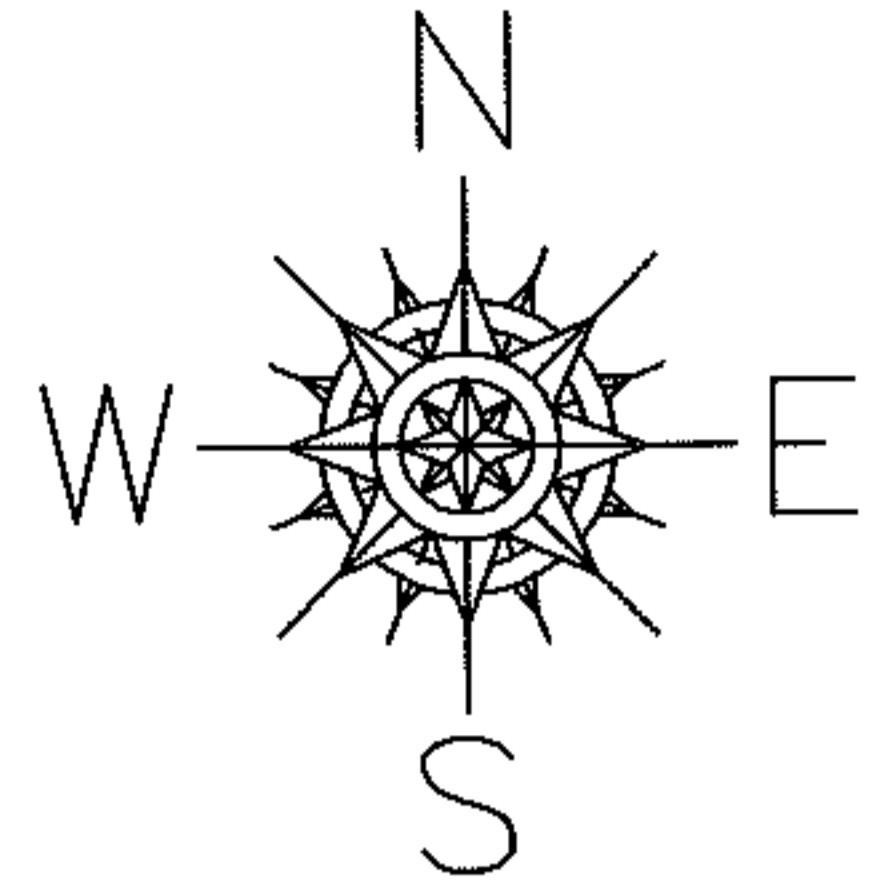

SPLITS/DEEDS PROCESSED

LORAIN COUNTY TAX MAP DEPARTMENT
226 MIDDLE AVE. ELYRIA, OHIO

SURVEYED BY: BRENT ANDERSON

CLOSURE: 0.00 : 10.000

MAP PAGE(S): 04-00-023-H

APPROVED BY: JAH DATE: 3-20-2013

SCALE: 1" = 100 PRIOR INSTRUMENT: 20120429972