

PARENT PARCEL: 12-00-047-102-022

CHILD PARCEL: 12-00-047-900-003 & -004

STARTING POINT: PLAT VOL 22 PG. 48


15-03132-C

DROP FROM DUPLICATE



12-00-047-102-022
0.72 A.

ADD TO DUPLICATE

12-00-047-900-003
3.43 A.
&
12-00-047-900-004
0.47 A.

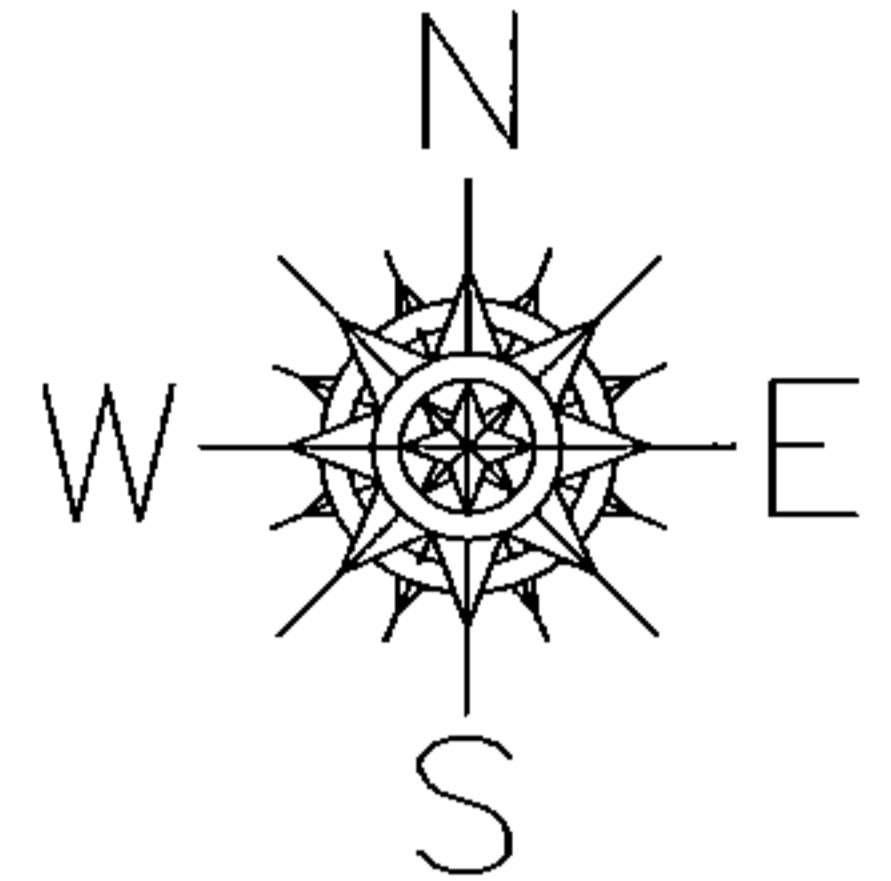

PER P.V. 22 PG. 48
HOMER C. AKINS SUBDIVISION

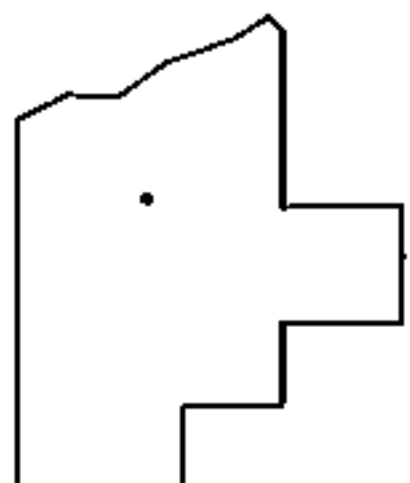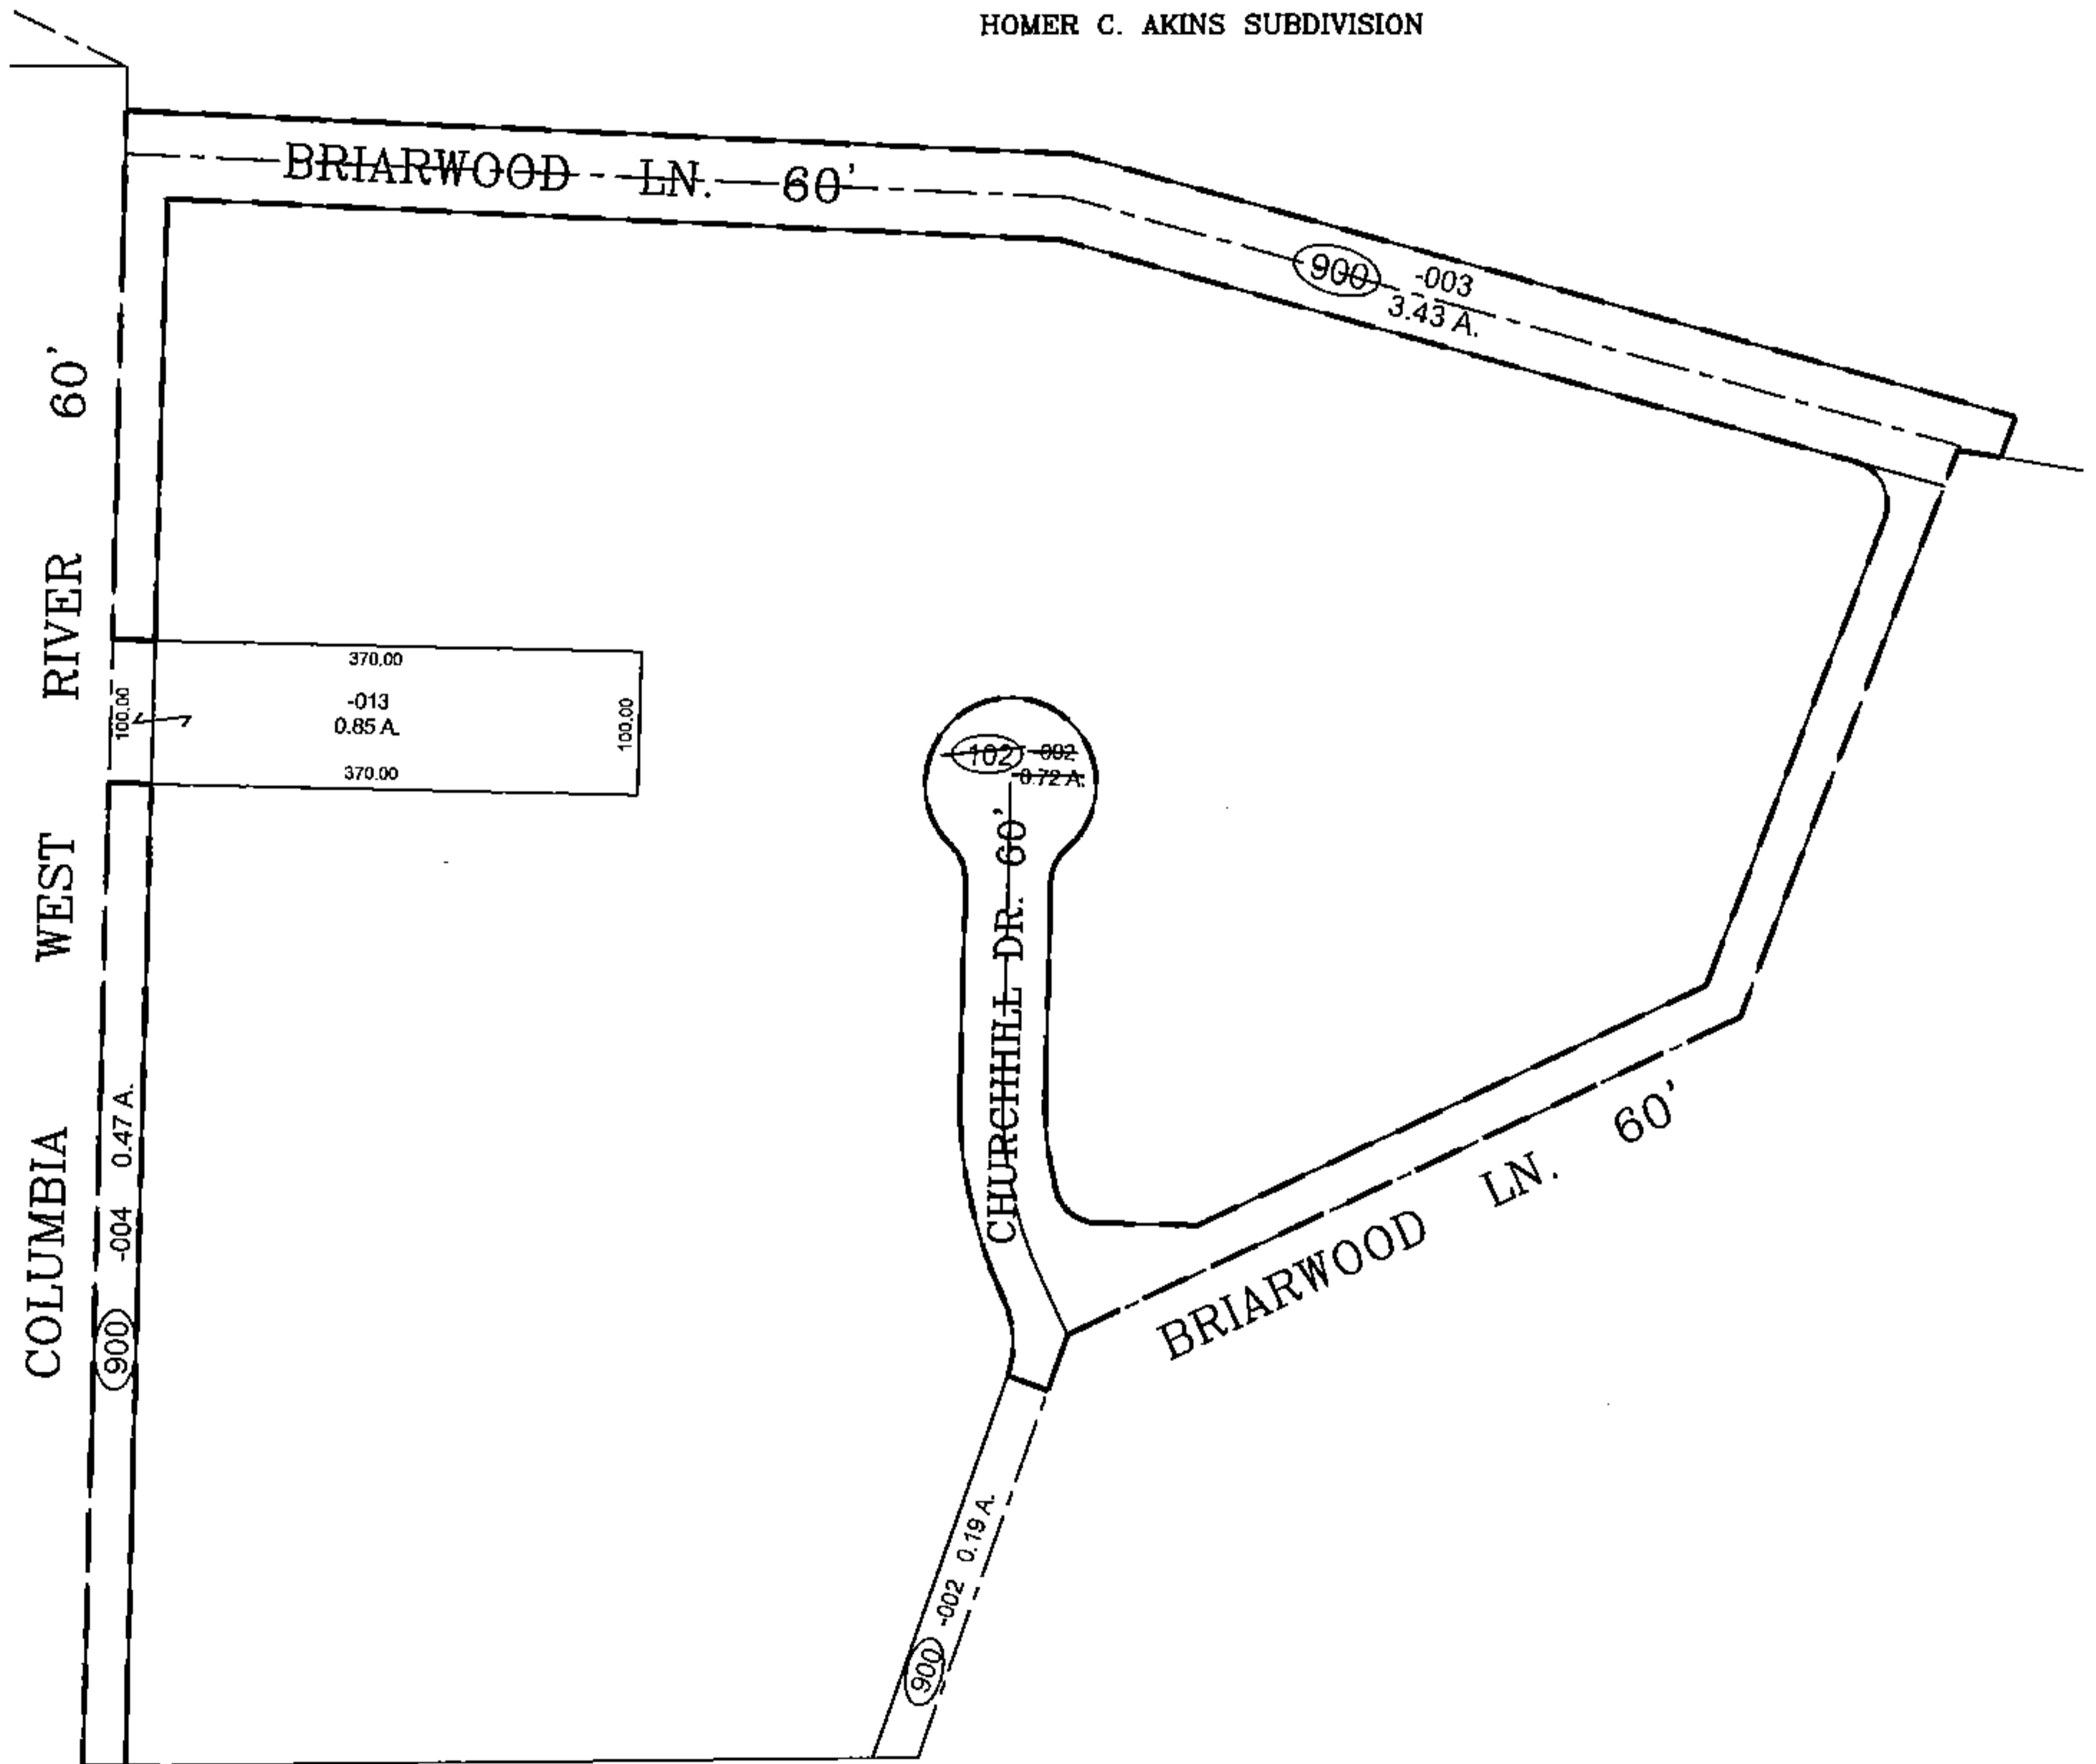

SPLITS/DEEDS PROCESSED
LORAIN COUNTY TAX MAP DEPARTMENT
226 MIDDLE AVE. ELYRIA, OHIO

SURVEYED BY: JOHN THOMSON
CLOSURE: 0.01 : 10.000
MAP PAGE(S): 12-00-047
APPROVED BY: TJS DATE: 3/25/15
SCALE: 1" = 200' PRIOR INSTRUMENT: PV. 22 PG. 48