

PARENT PARCEL: 03-00-108-111-023
 CHILD PARCEL: 03-00-108-111-079 THRU -081
 STARTING POINT: CL OF VACATED E. 46TH ST. & EAST LINE OF TOLEDO AVE.



15-03133-C

UNCOMBINATION

FR. & DEPTH CORR.

~~03-00-108-111-023~~
~~93.49 X 184~~
 03-00-108-111-079
 13.01 X 151.16
 03-00-108-111-080
 50.48 X 151.16
 03-00-108-111-081
 30.23 X 151.16

03-00-108-111-021
~~63.49 X 184~~
 63.49 X 151.16
 &
 03-00-108-111-022
~~63.49 X 184~~
 63.49 X 151.16

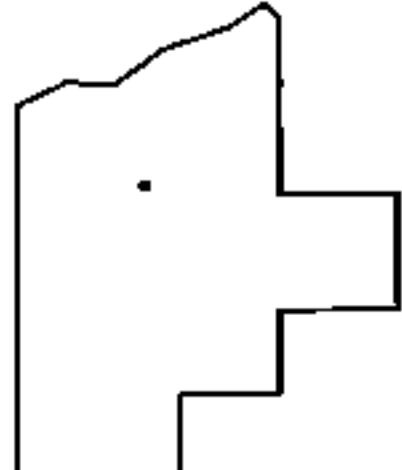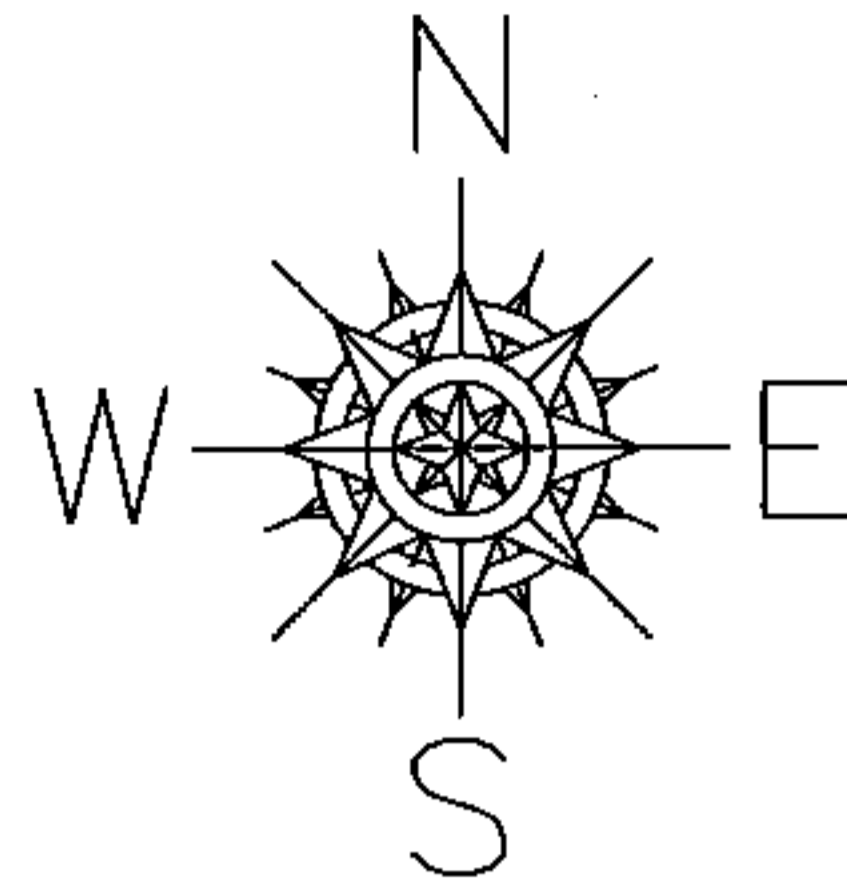

SPLITS/DEEDS PROCESSED

LORAIN COUNTY TAX MAP DEPARTMENT
 226 MIDDLE AVE. ELYRIA, OHIO

SURVEYED BY: RAY HOLLIS
 CLOSURE: 0.00 : 10,000
 MAP PAGE(S): 03-00-108
 APPROVED BY: TJS DATE: 3/31/15
 SCALE: 1" = 50' PRIOR INST.: 20020812293