
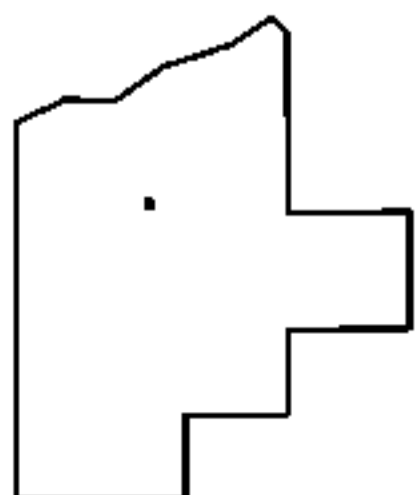
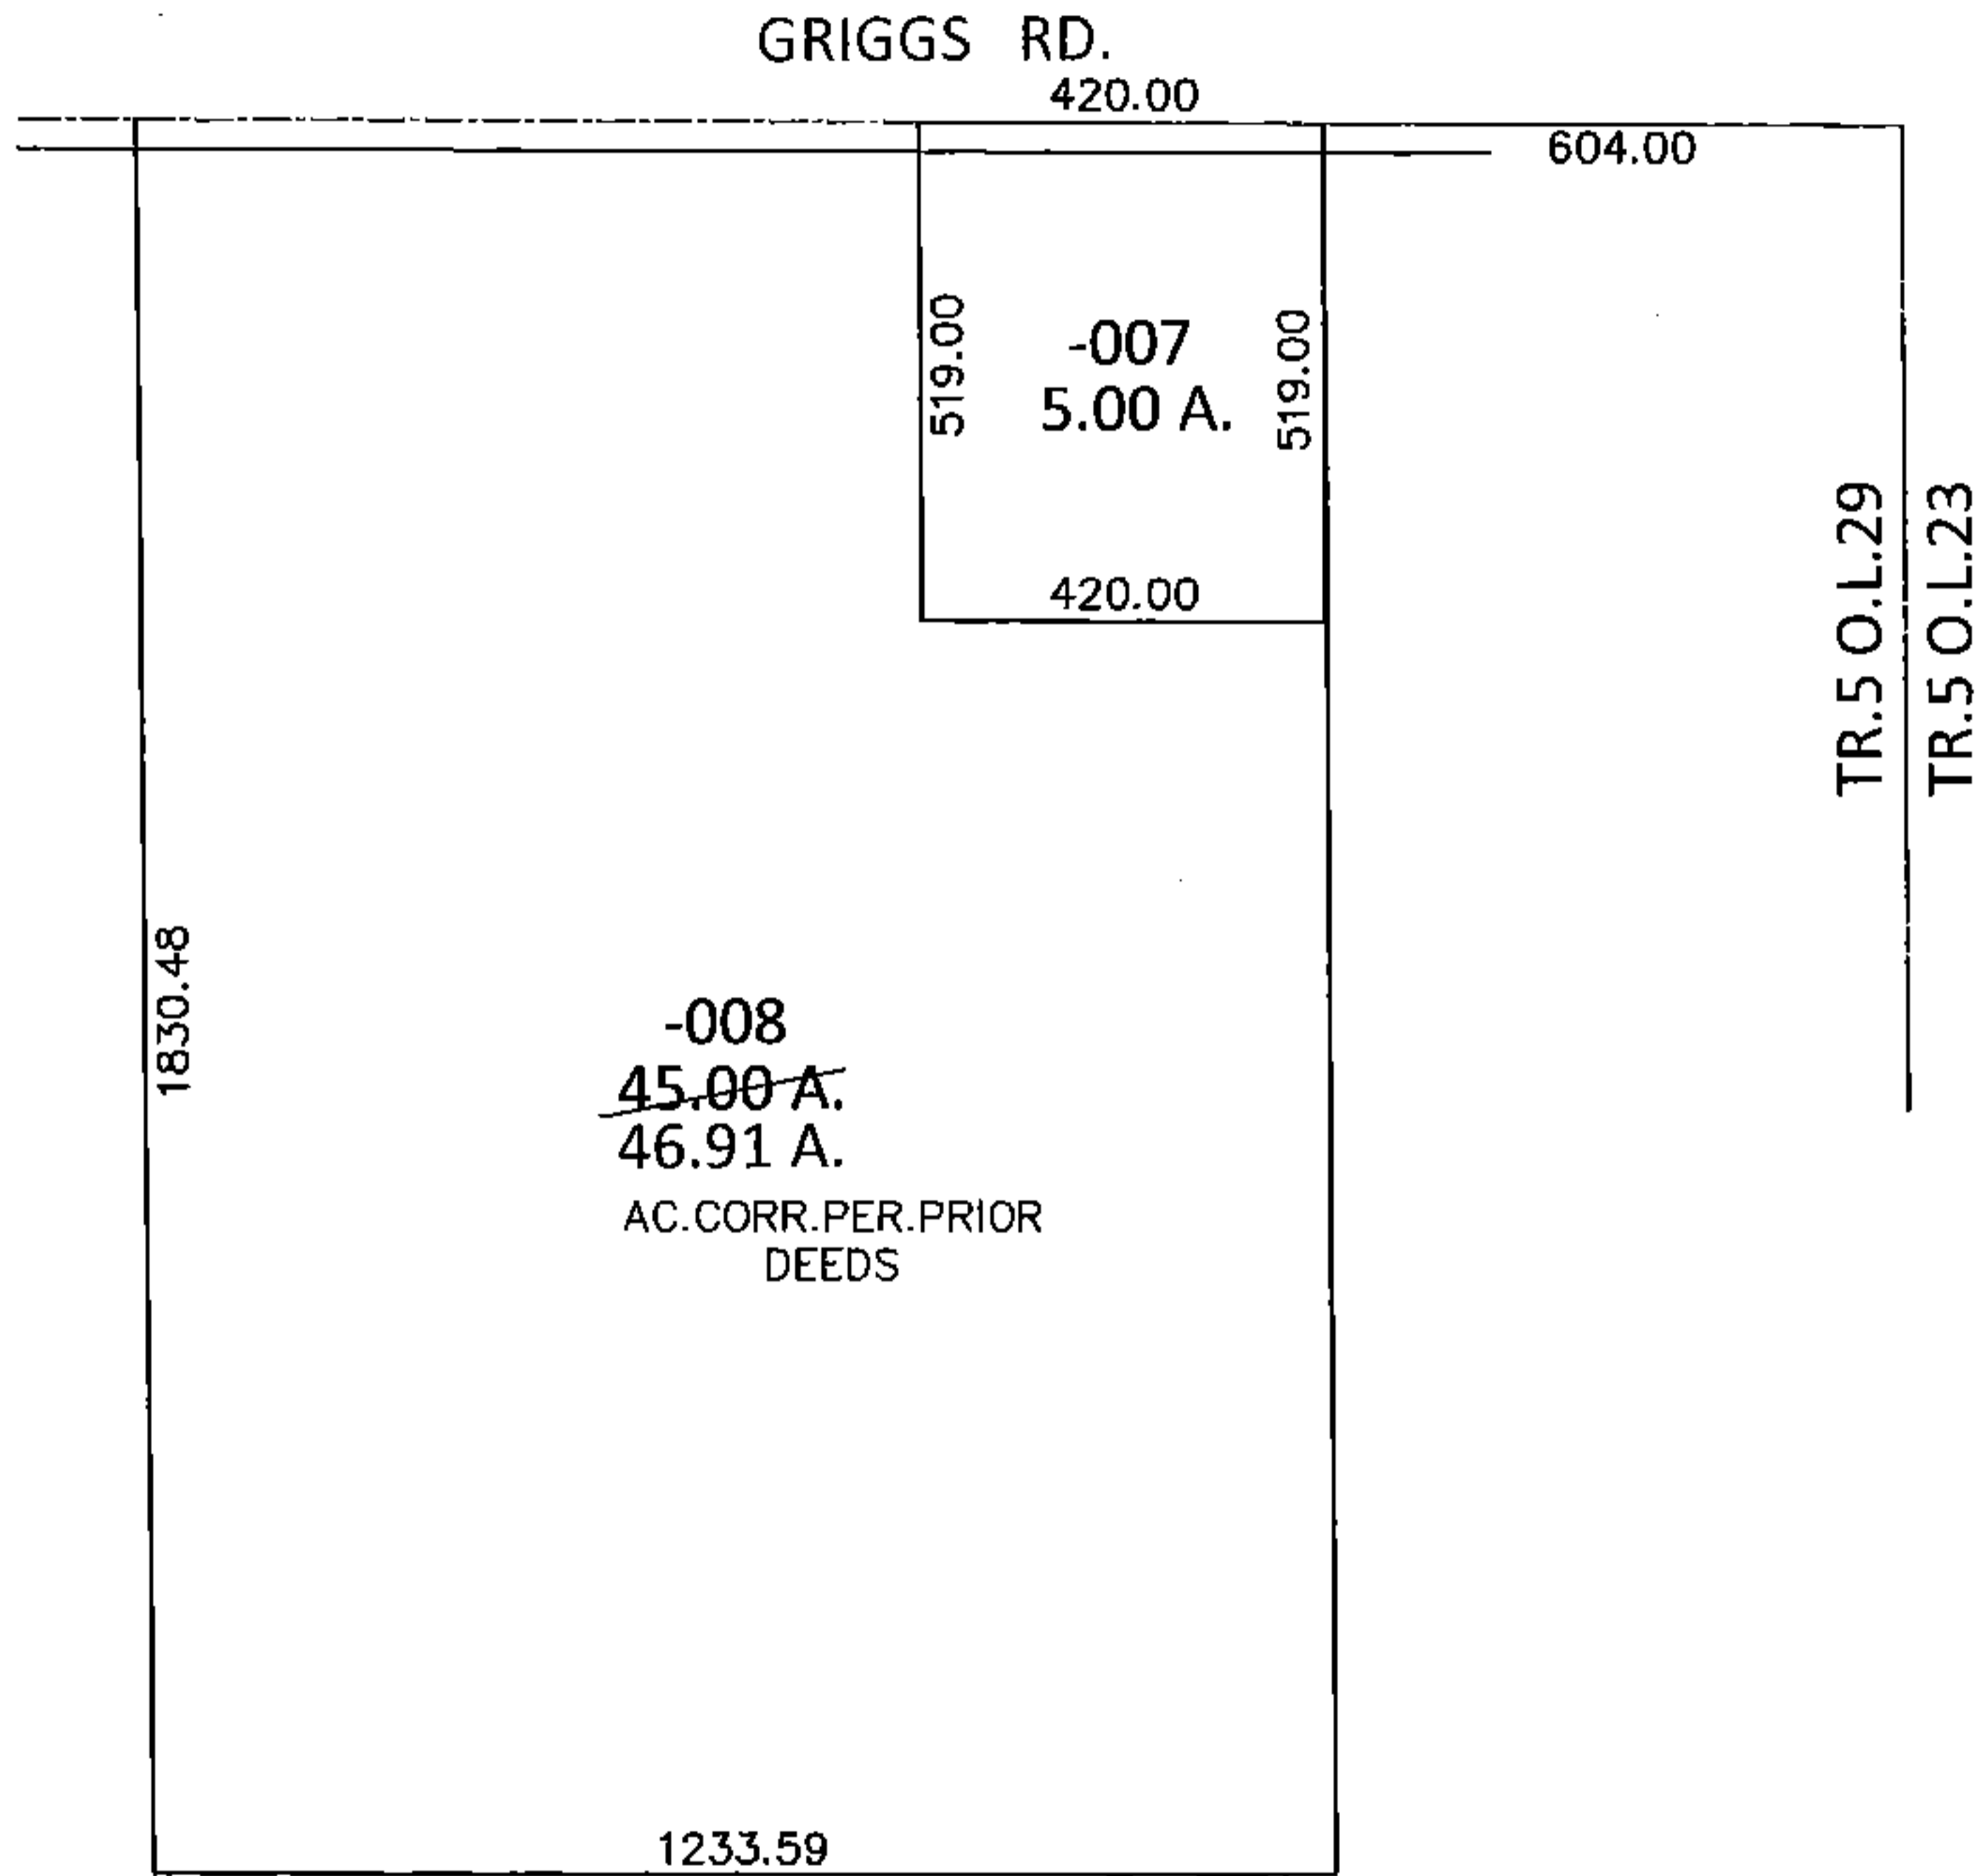


PARENT PARCEL: 20-05-029-000-008

CHILD PARCEL: _____

STARTING POINT: INTERSECTION OF C/L OF GRIGGS RD. AND EAST LINE OF O.L.29

15-03135-A

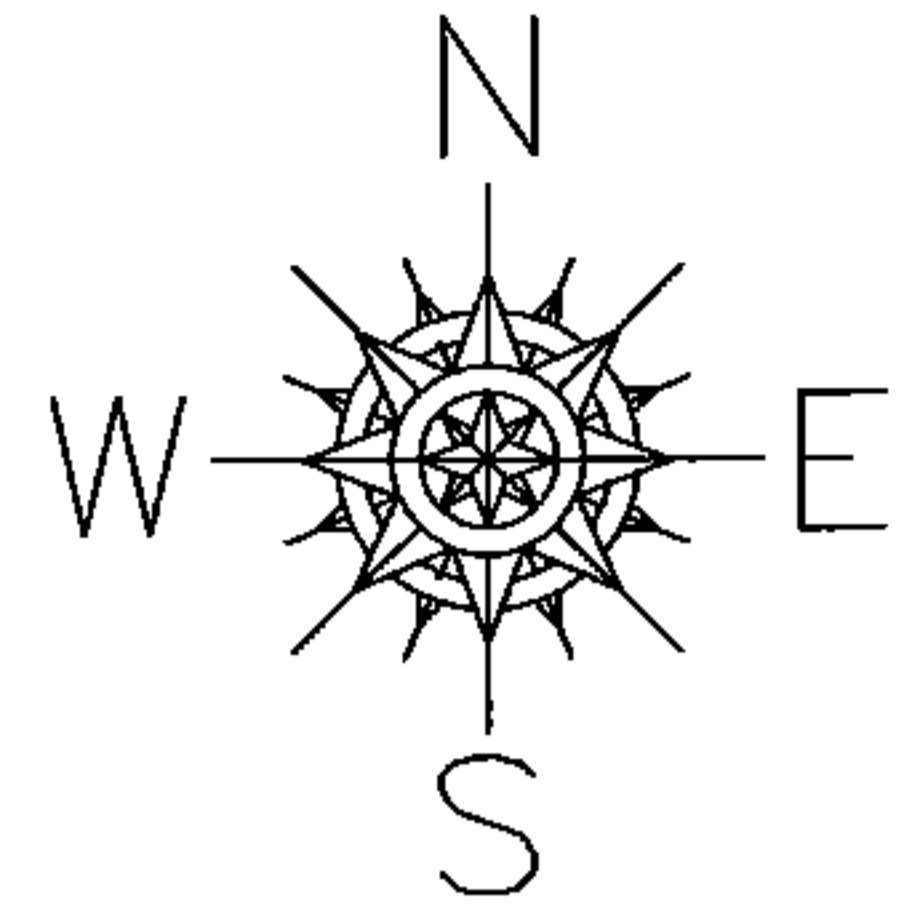

SPLITS/DEEDS PROCESSED

LORAIN COUNTY TAX MAP DEPARTMENT
226 MIDDLE AVE. ELYRIA, OHIO

SURVEYED BY: N/A

CLOSURE: N/A

MAP PAGE(S): 20-B

APPROVED BY: RRM DATE: 3-31-15

SCALE: 1" = 400 PRIOR INST.: _____