
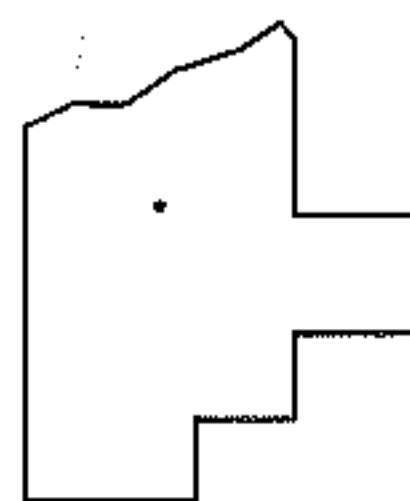
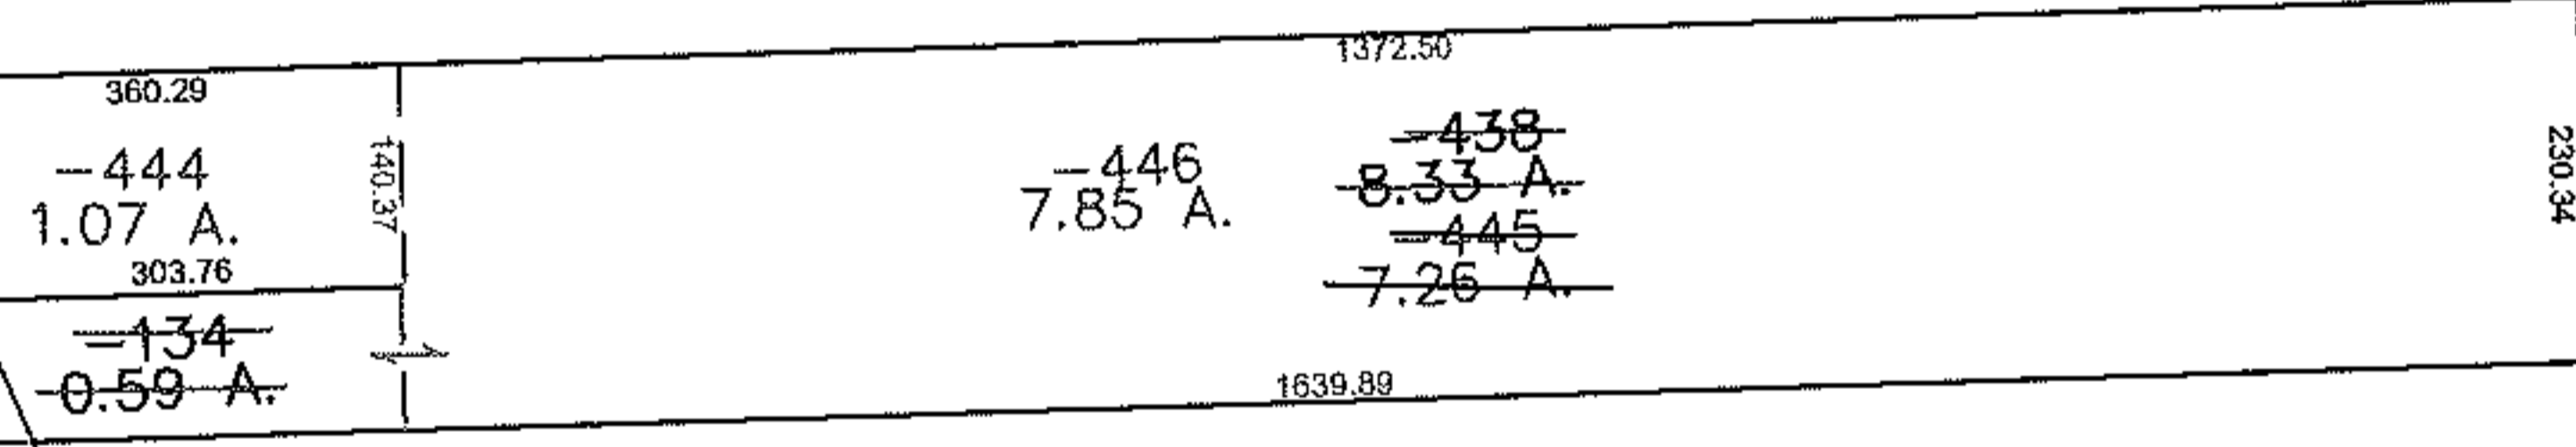
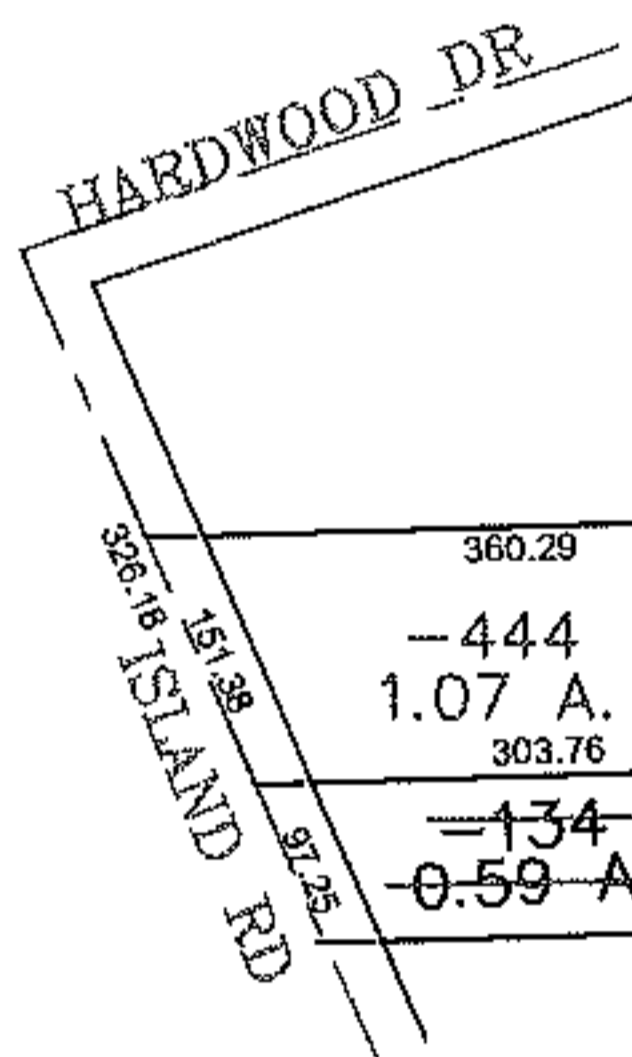


PARENT PARCEL: 07-00-013-000-438, 07-00-013-000-134

CHILD PARCEL: 07-00-013-000-444 THRU -446

STARTING POINT: CENTERLINE OF ISLAND RD & HARDWOOD DR

13-03135

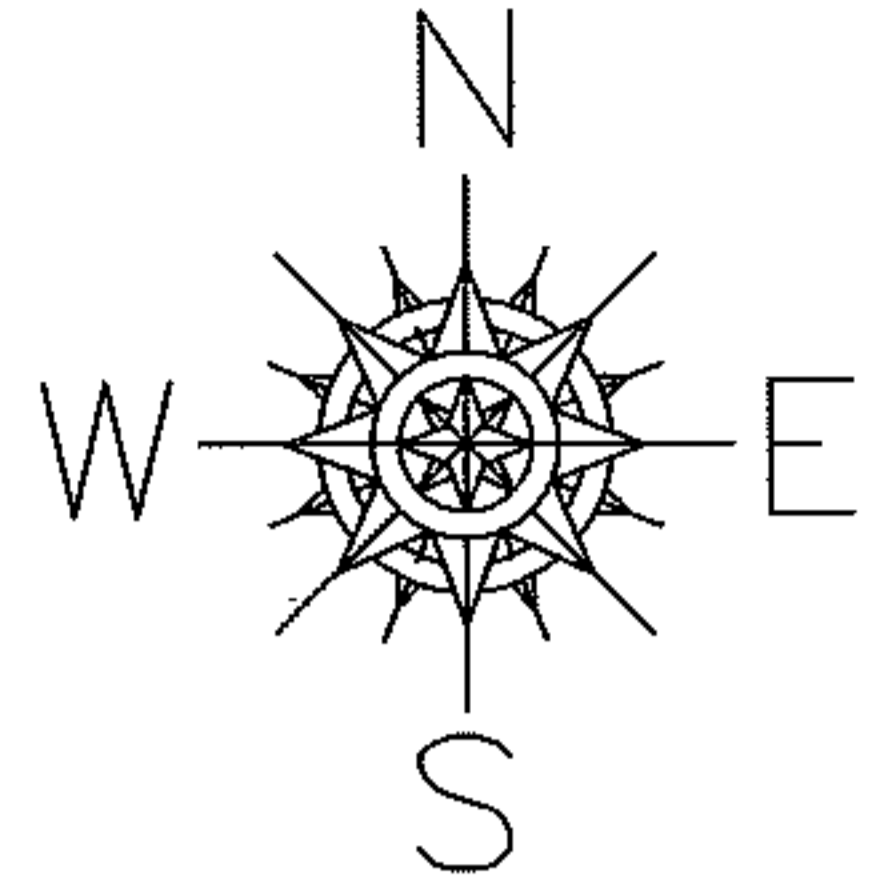

**SPLITS/DEEDS PROCESSED**  
LORAIN COUNTY TAX MAP DEPARTMENT  
226 MIDDLE AVE. ELYRIA, OHIO

SURVEYED BY: WILL BARBOSA  
CLOSURE: 0.00 : 10.000  
MAP PAGE(S): 07-00-013-A, B  
APPROVED BY: JAH DATE: 4-9-2013  
SCALE: 1" = 300 PRIOR INSTRUMENT: 20110396916