
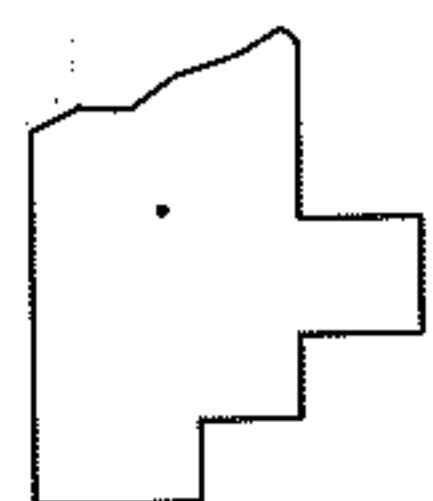
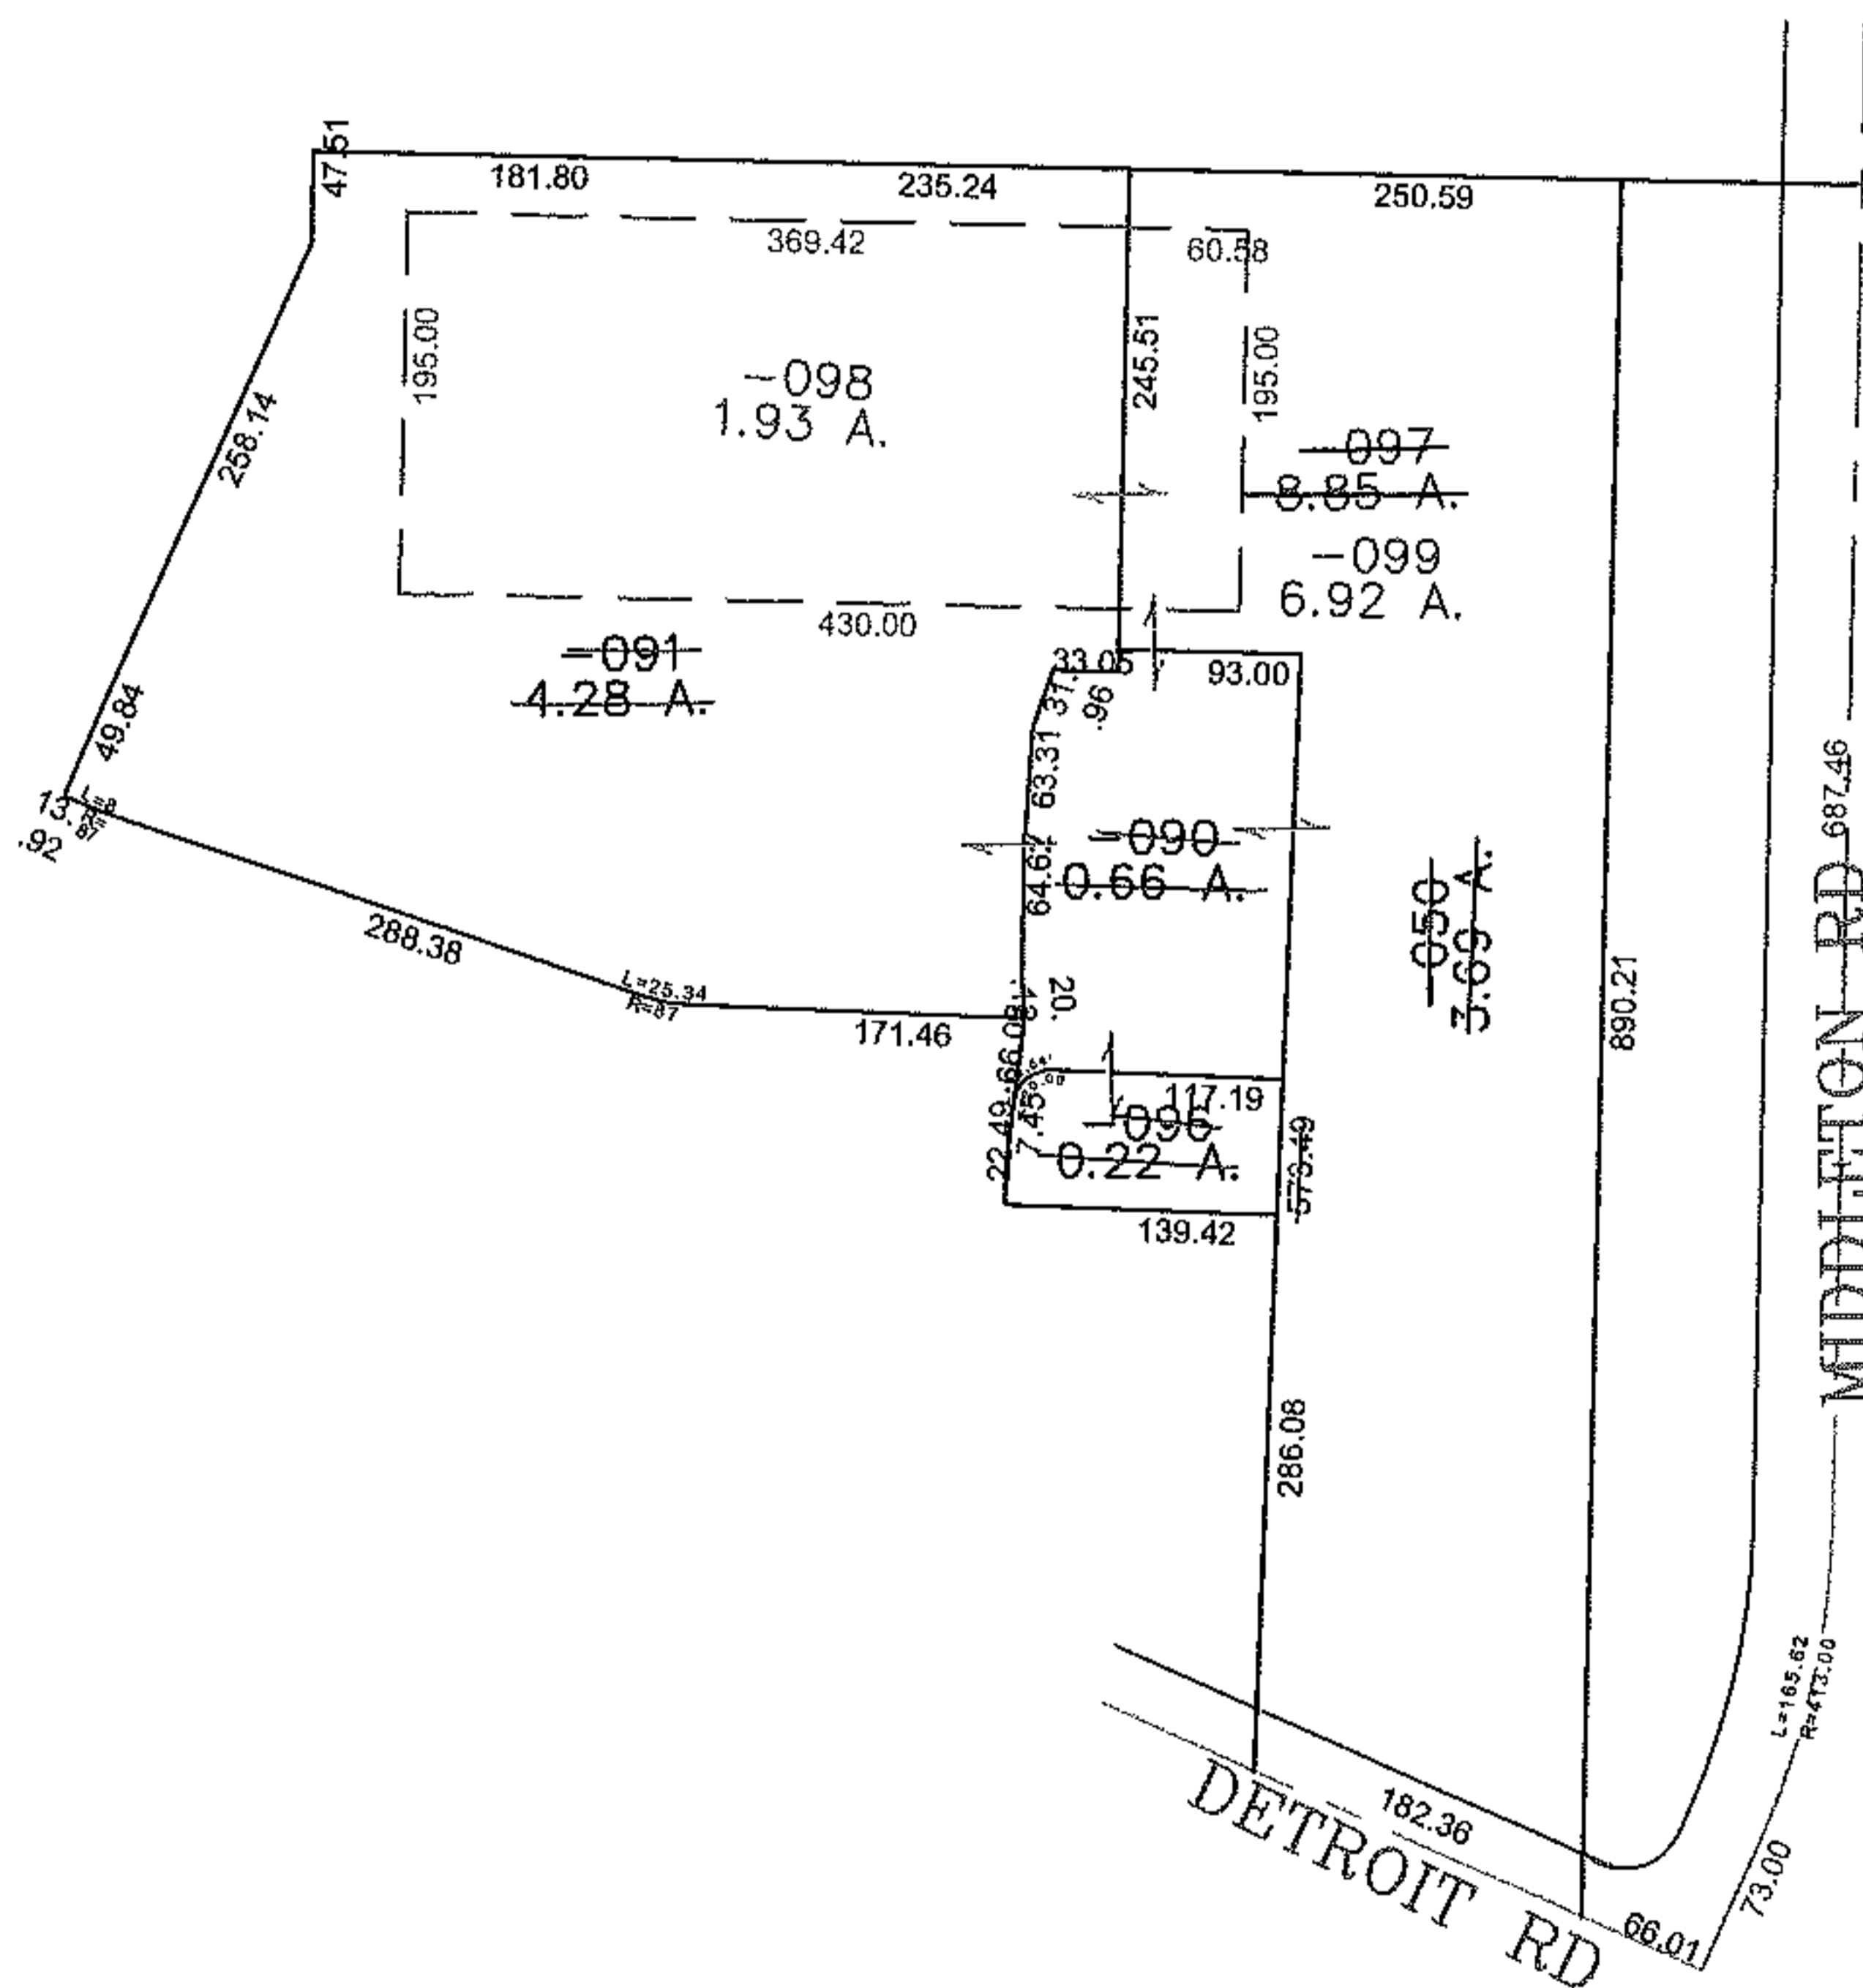


PARENT PARCEL: 04-00-015-103-050, -090, -091, -096

CHILD PARCEL: 04-00-015-103-097 THRU -099

STARTING POINT: CENTERLINE OF DETROIT RD & MIDDLETON RD

13-03138

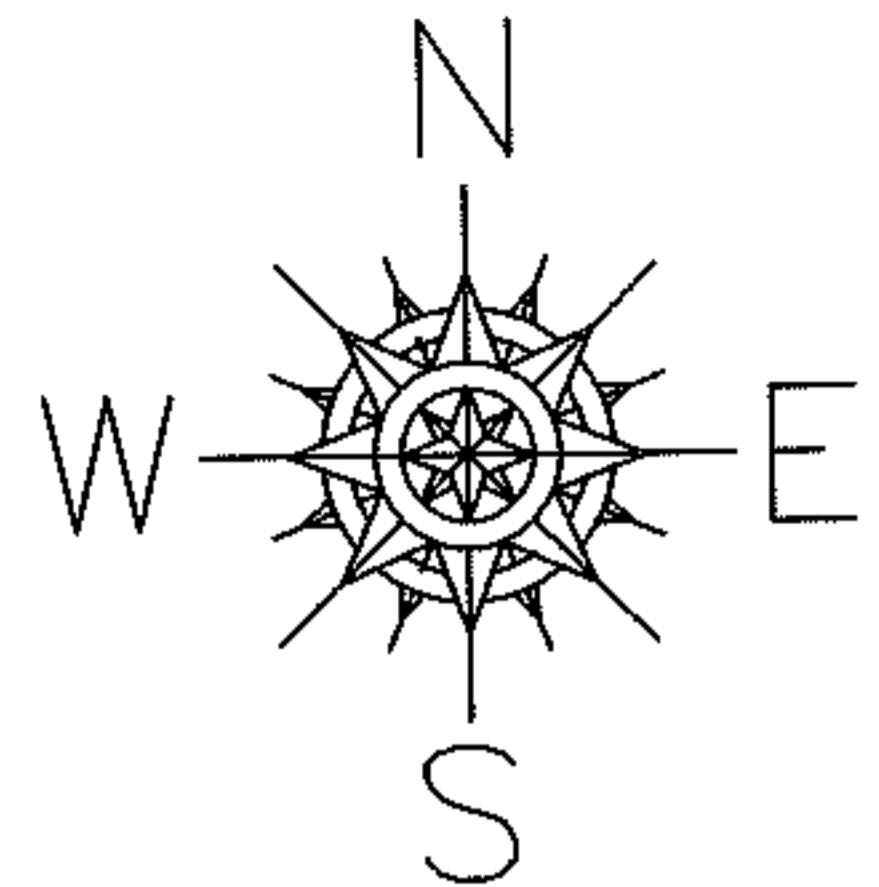

SPLITS/DEEDS PROCESSED
LORAIN COUNTY TAX MAP DEPARTMENT
226 MIDDLE AVE. ELYRIA, OHIO

SURVEYED BY: MIKE SPELLACY
CLOSURE: 0.00 : 10.00
MAP PAGE(S): 04-00-015-D
APPROVED BY: JAH DATE: 4-23-2013
SCALE: 1" = 200 PRIOR INSTRUMENT: 20120400989