
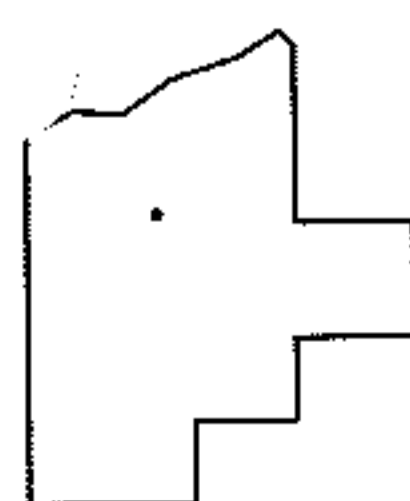
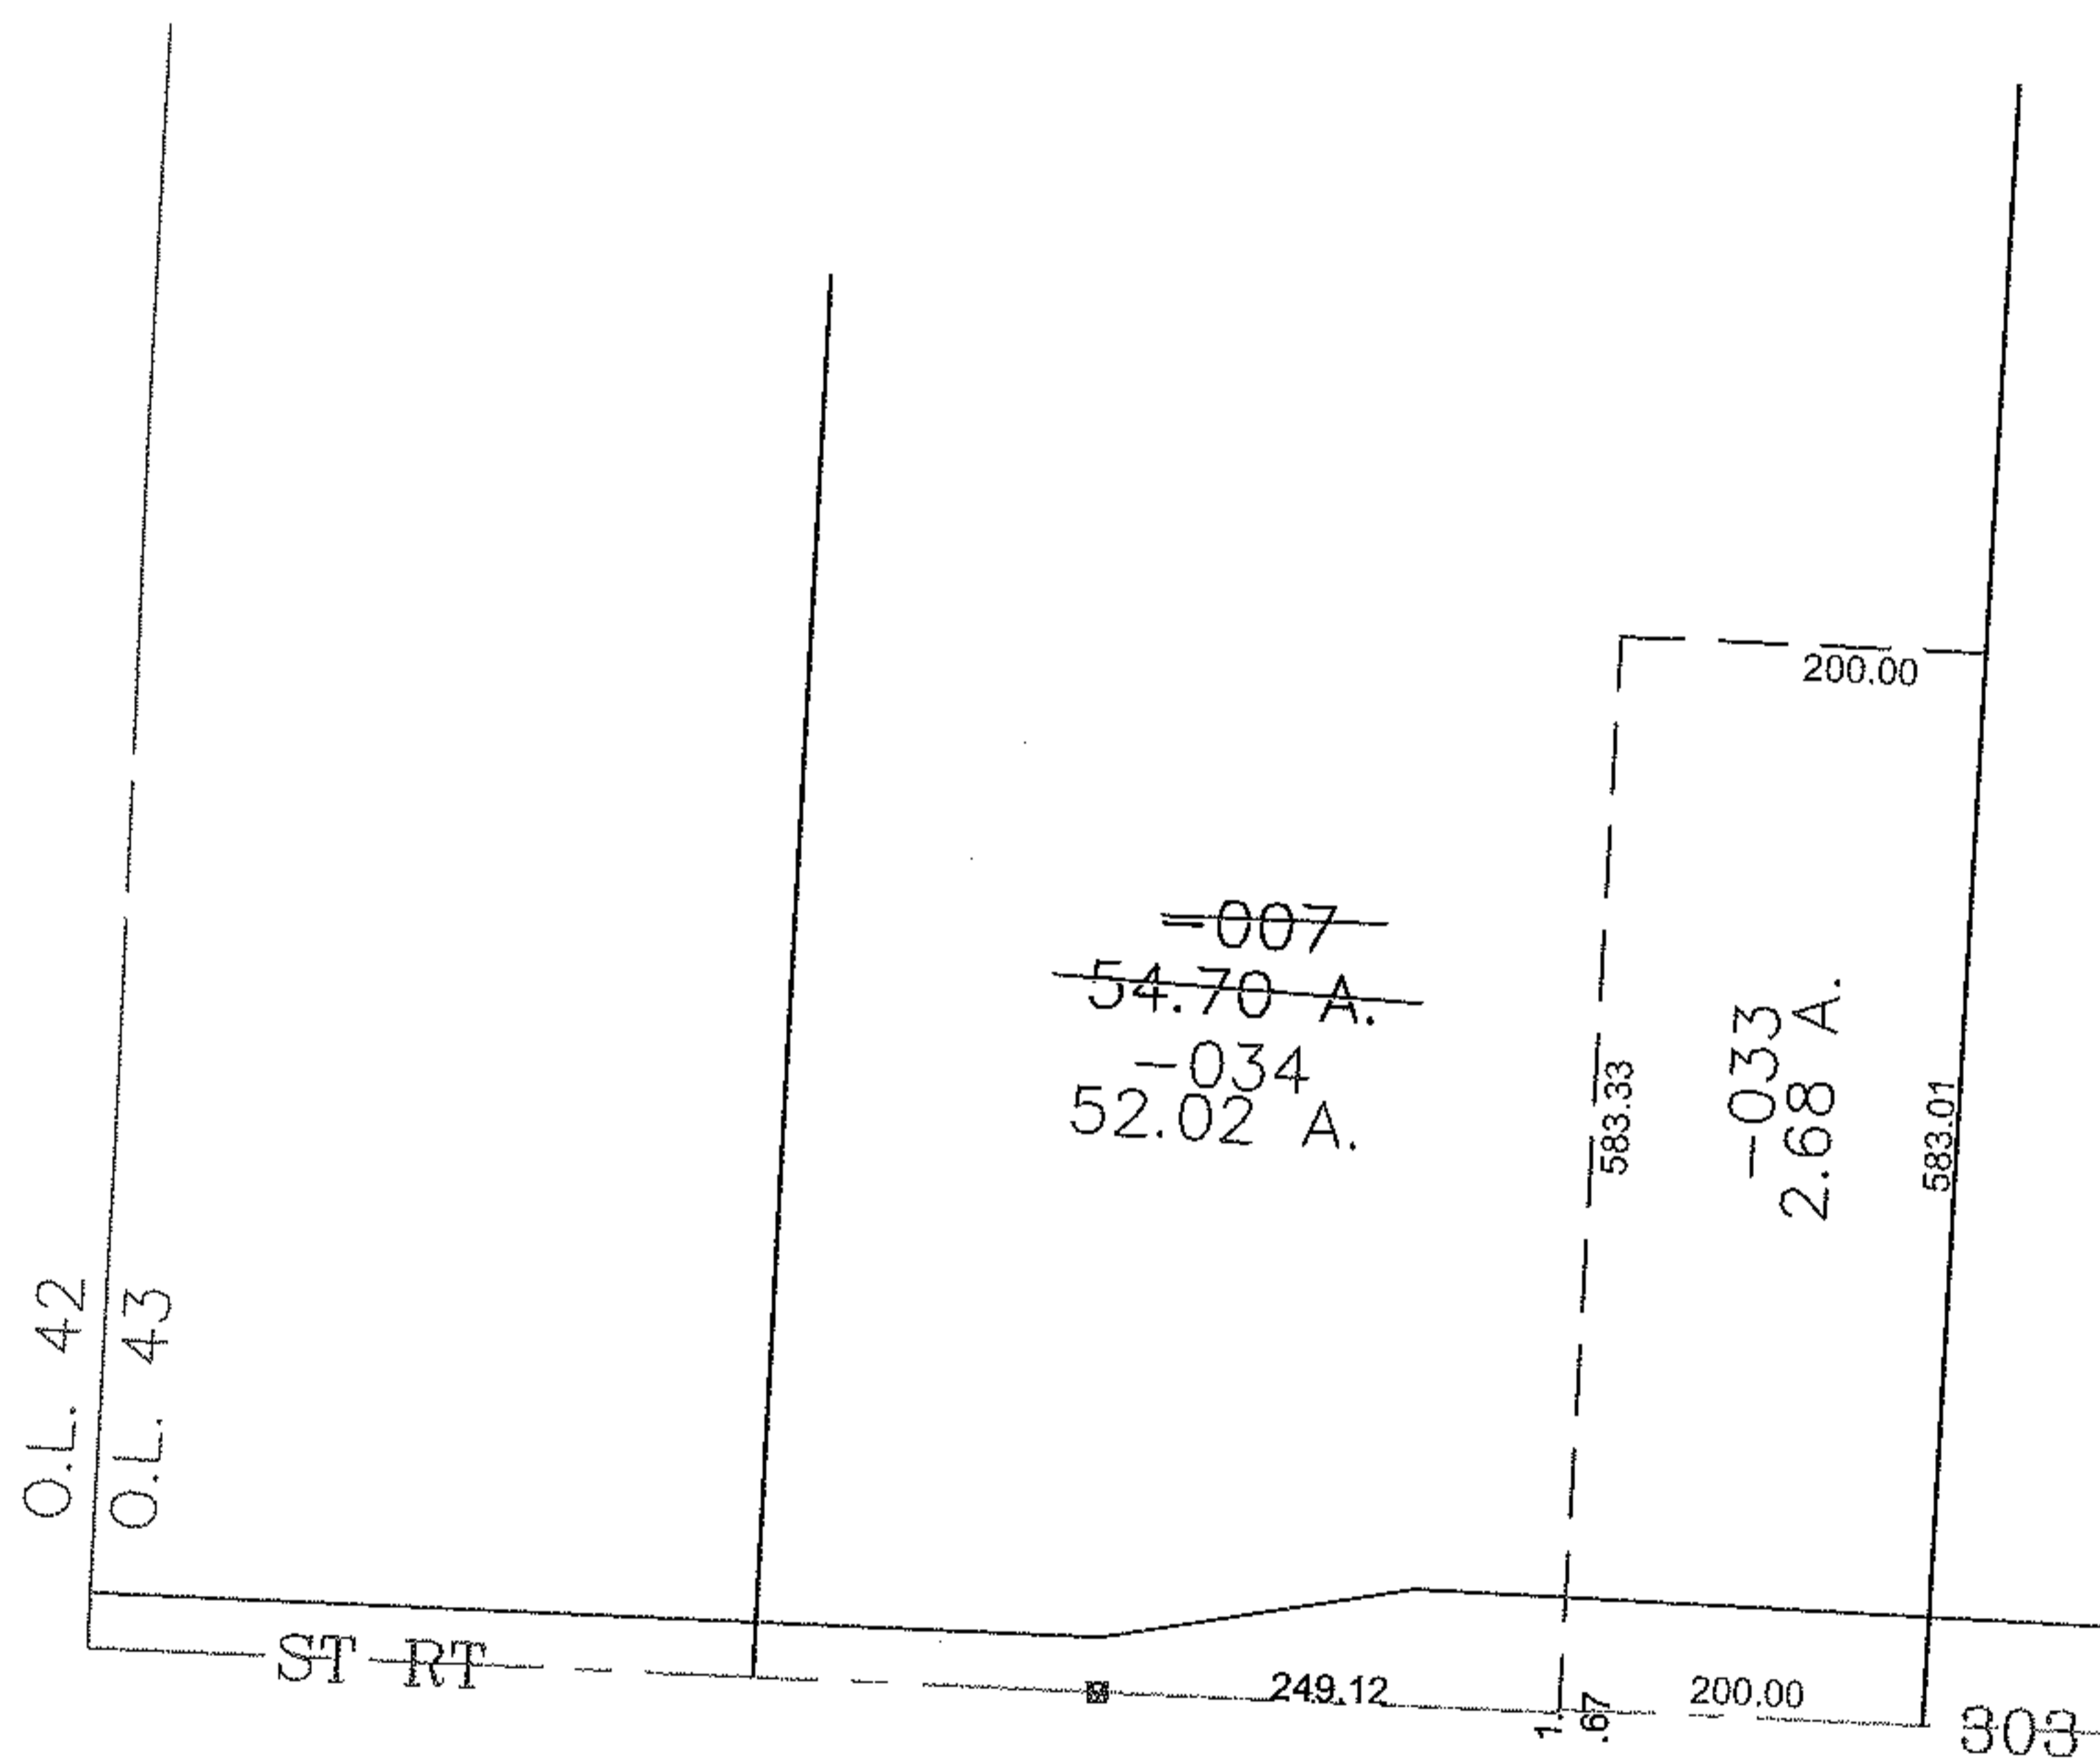


PARENT PARCEL: 16-00-043-000-007

CHILD PARCEL: 16-00-043-000-033, -034

STARTING POINT: CENTERLINE OF ST RT 303 AT A MON BOX STA 805+00.00

13-03139

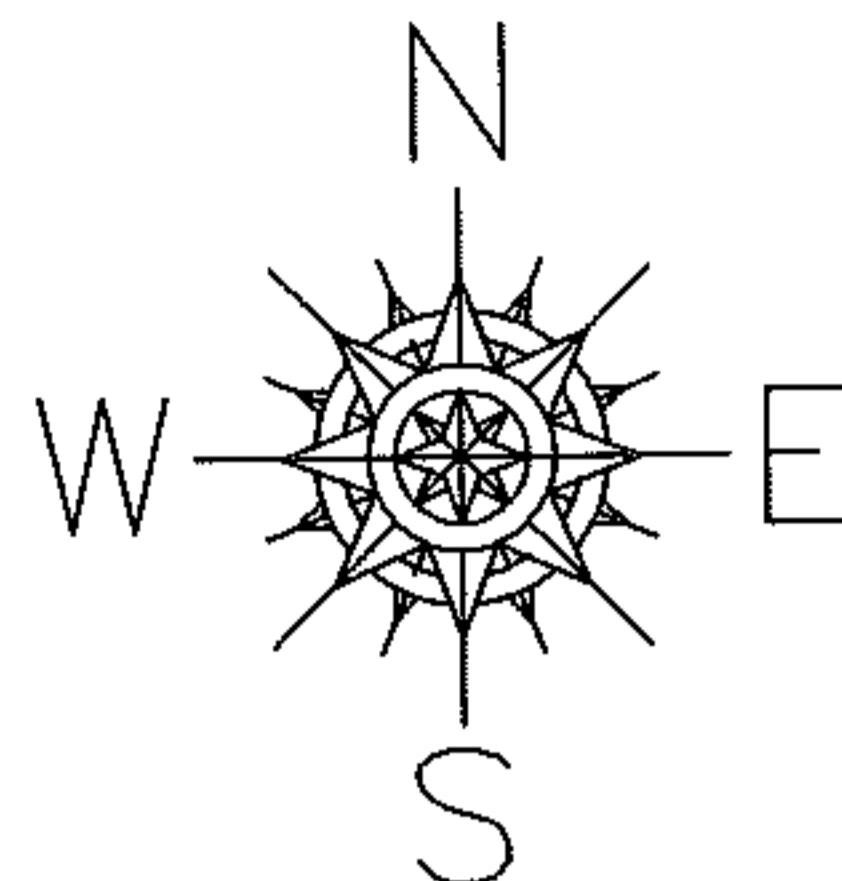

SPLITS/DEEDS PROCESSED
 LORAIN COUNTY TAX MAP DEPARTMENT
 226 MIDDLE AVE. ELYRIA, OHIO

SURVEYED BY: RICK CARLSON
 CLOSURE: 0.00 : 10.000
 MAP PAGE(S): 16-00-043
 APPROVED BY: JAH DATE: 4-30-2013
 SCALE: 1" = 200 PRIOR INSTRUMENT: DV 1190/902