
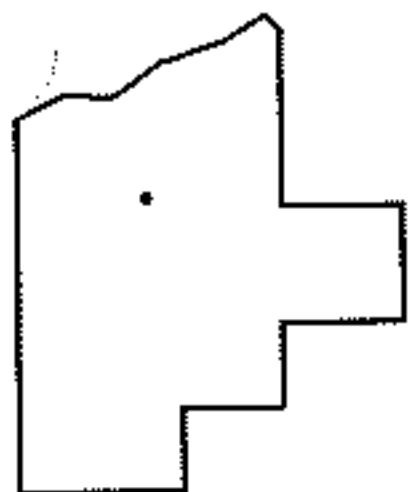
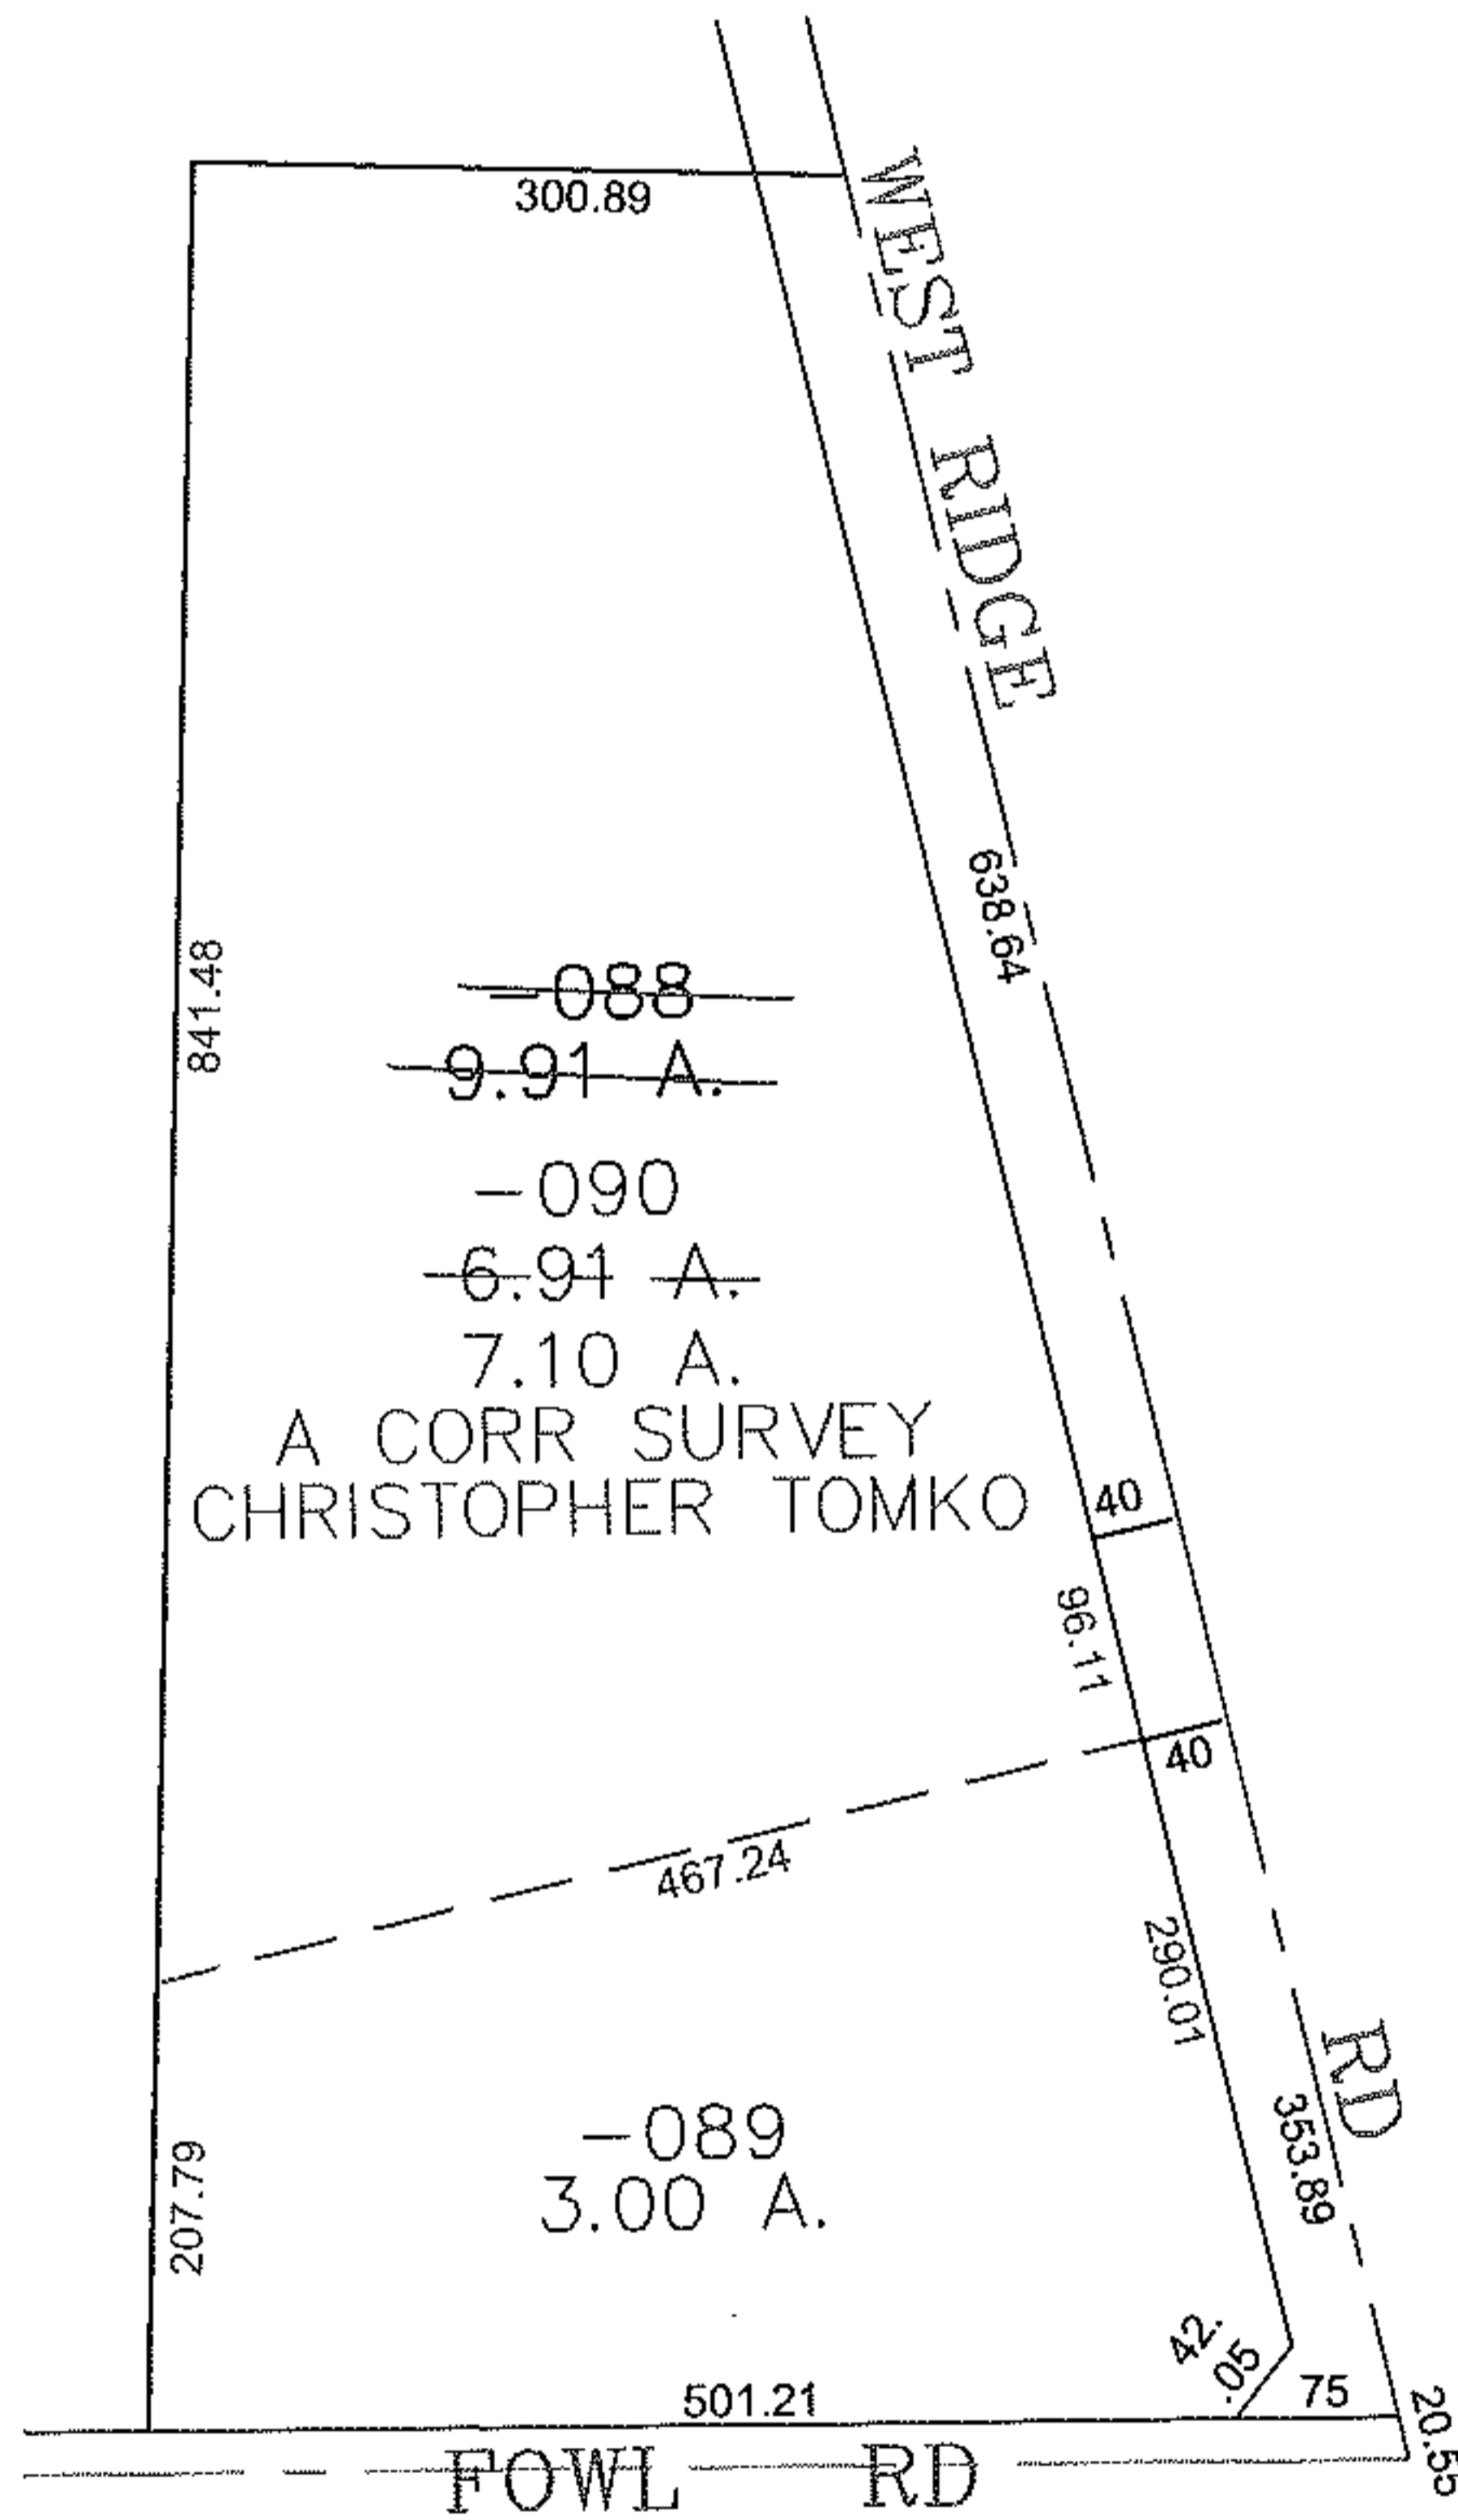


PARENT PARCEL: 06-24-016-000-088

CHILD PARCEL: 06-24-016-000-089, -090

STARTING POINT: CENTERLINE OF FOWL RD & WEST RIDGE RD

13-03141

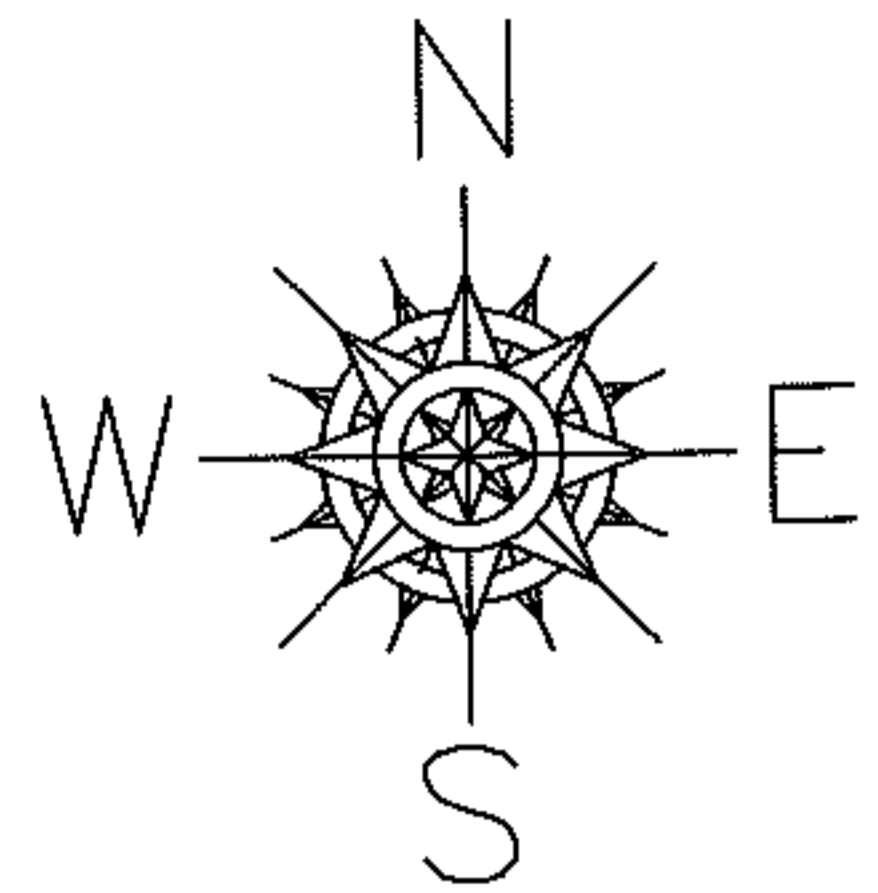

SPLITS/DEEDS PROCESSED

LORAIN COUNTY TAX MAP DEPARTMENT
226 MIDDLE AVE. ELYRIA, OHIO

SURVEYED BY: CHRISTOPHER TOMKO

CLOSURE: 0.00 : 10.000

MAP PAGE(S): 6-109

APPROVED BY: JAH DATE: 5-1-2013

SCALE: 1" = 200 PRIOR INSTRUMENT: 20060169440