
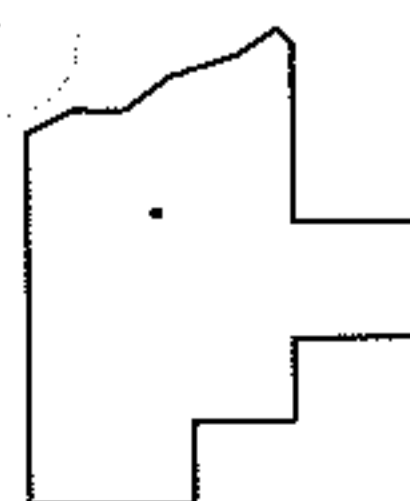
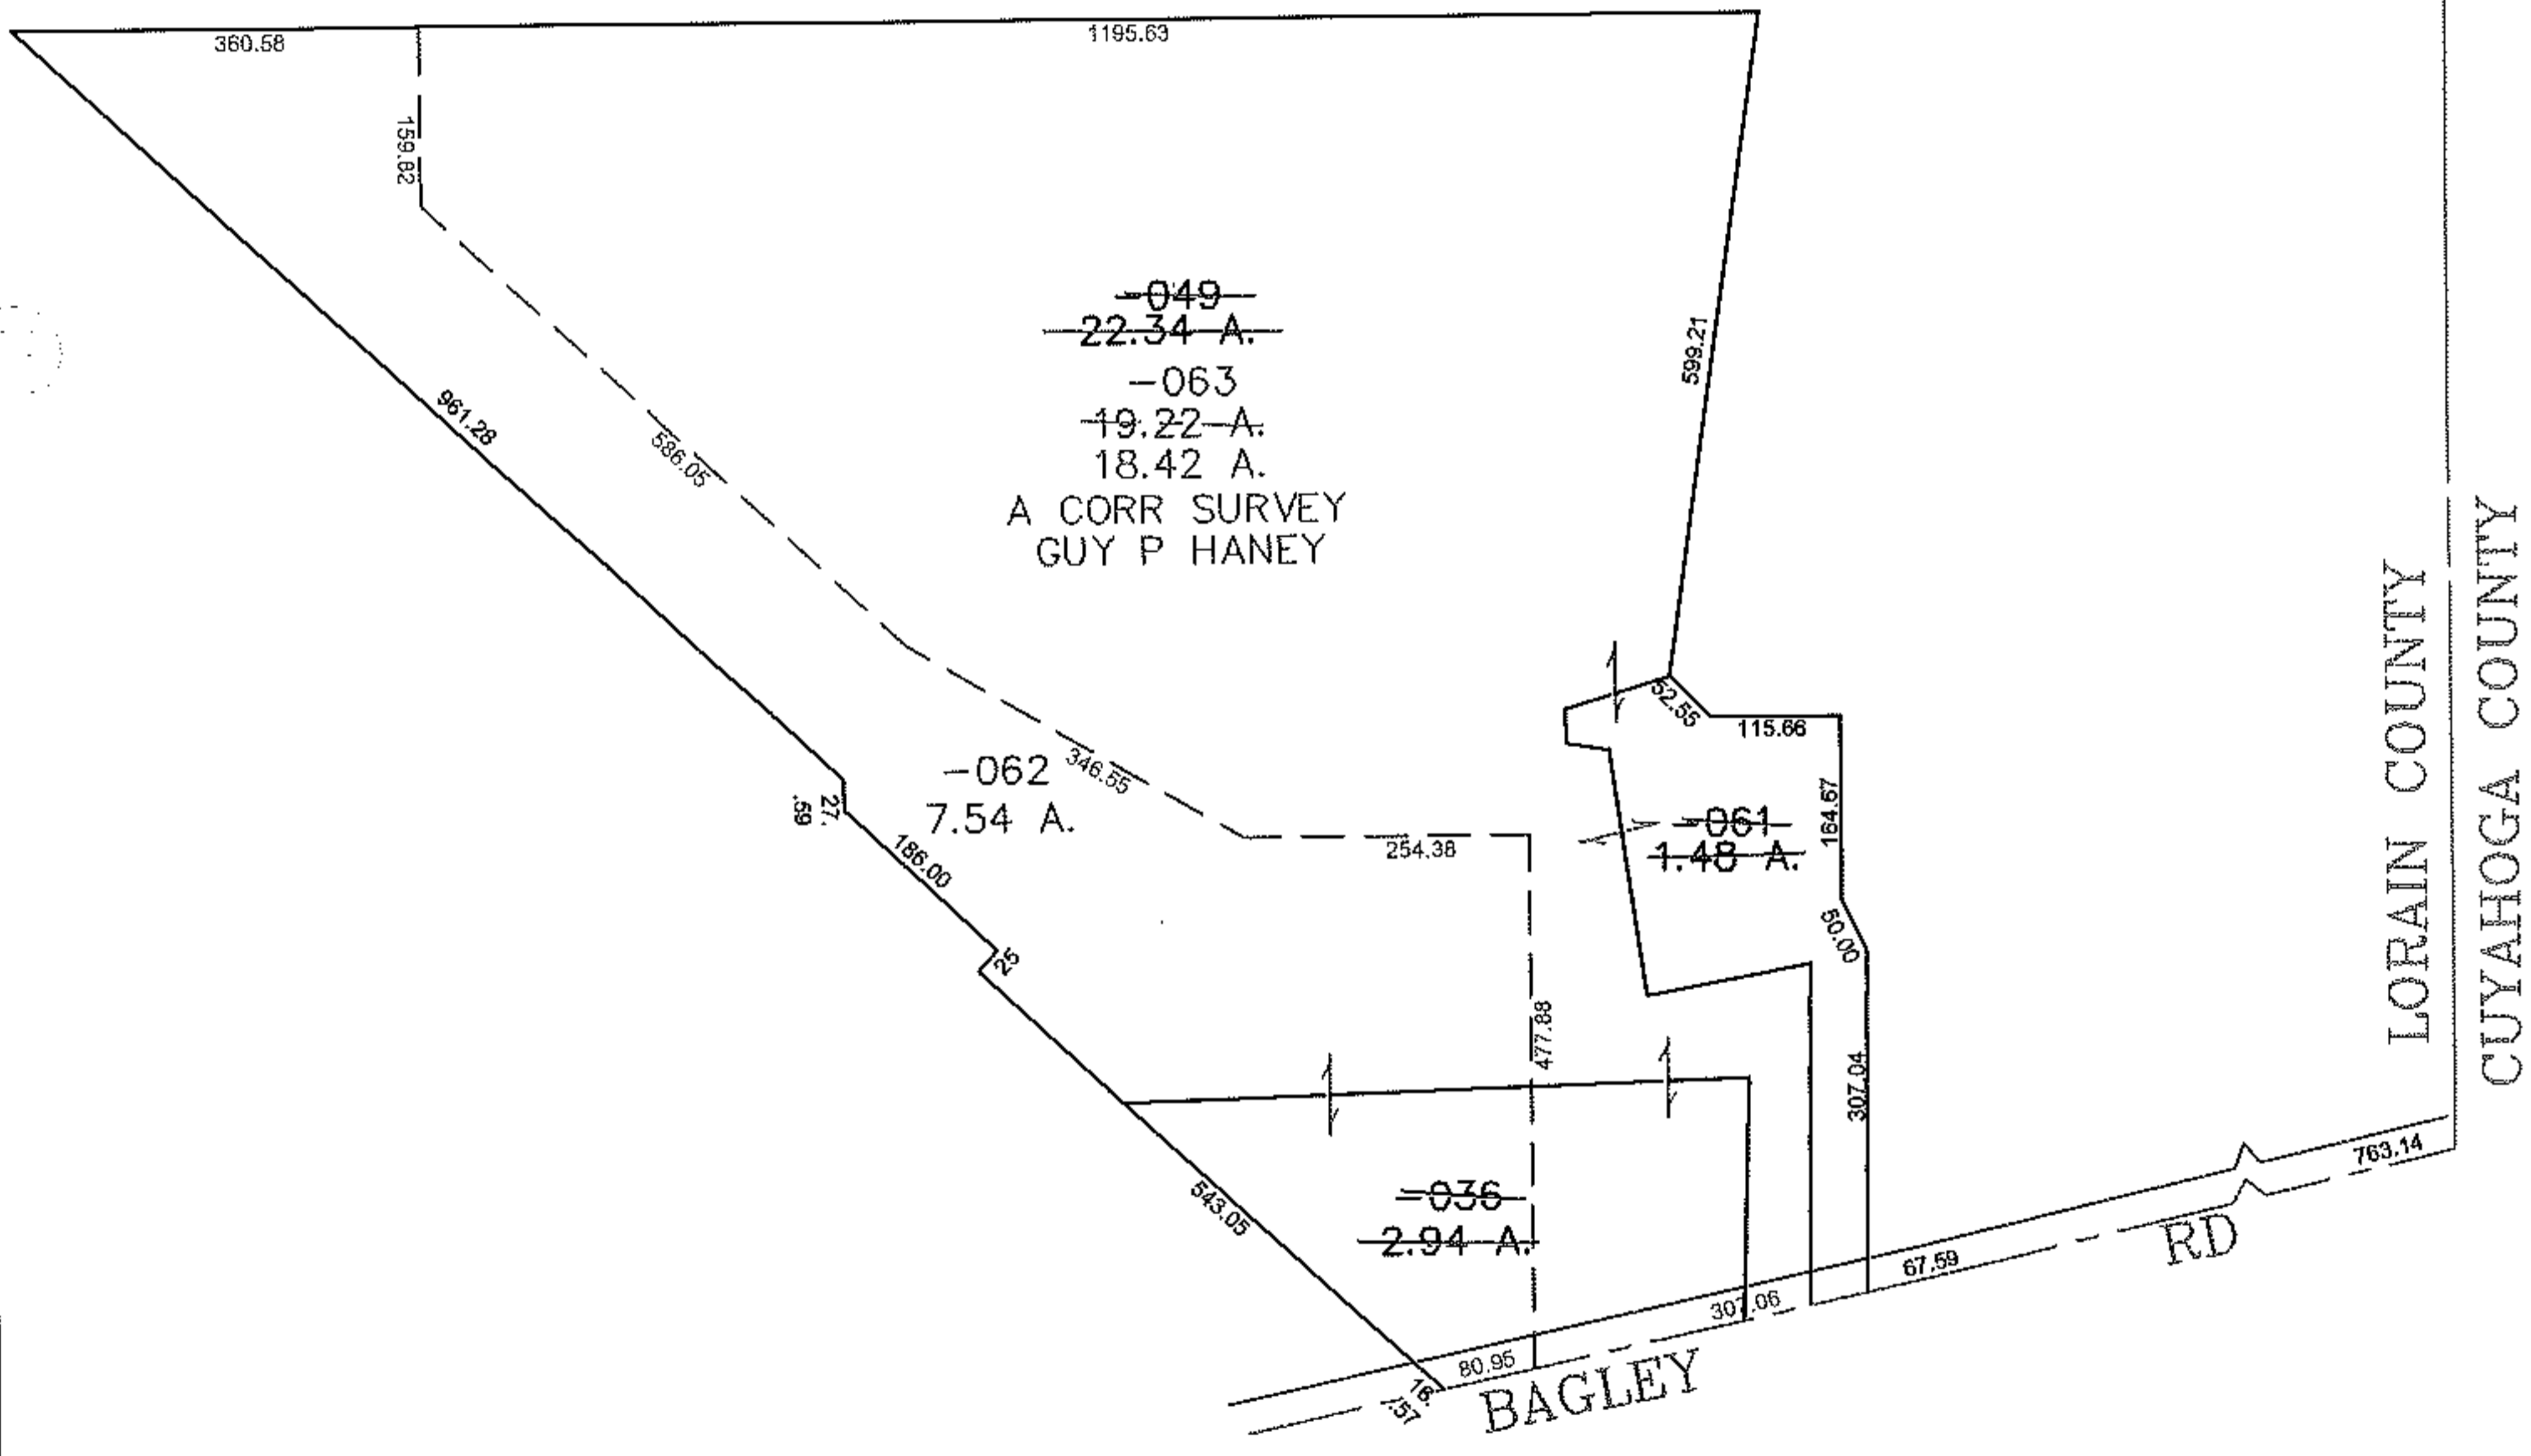


PARENT PARCEL: 07-00-002-101-036, -049, -061  
CHILD PARCEL: 07-00-002-101-062, -063  
STARTING POINT: CENTERLINE OF BAGLEY RD & LORAIN COUNTY/CUYAHOGA COUNTY LINE

13-03143

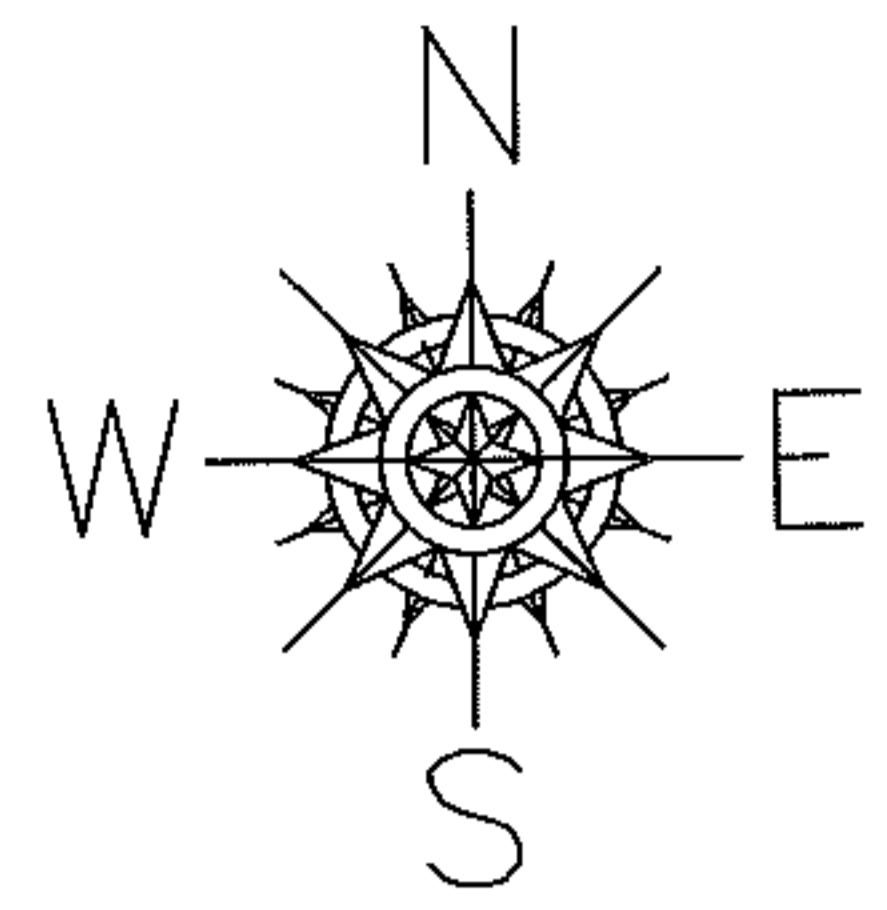

**SPLITS/DEEDS PROCESSED**  
LORAIN COUNTY TAX MAP DEPARTMENT  
226 MIDDLE AVE. ELYRIA, OHIO

SURVEYED BY: GUY P HANEY  
CLOSURE: 0.00 : 10.000  
MAP PAGE(S): 07-00-002-B  
APPROVED BY: JAH DATE: 5-8-2013  
SCALE: 1" = 300 PRIOR INSTRUMENT: 20130454202