
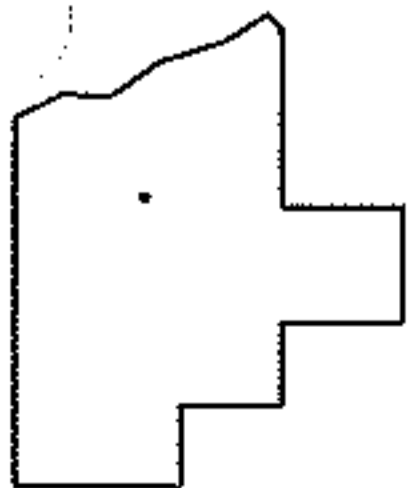
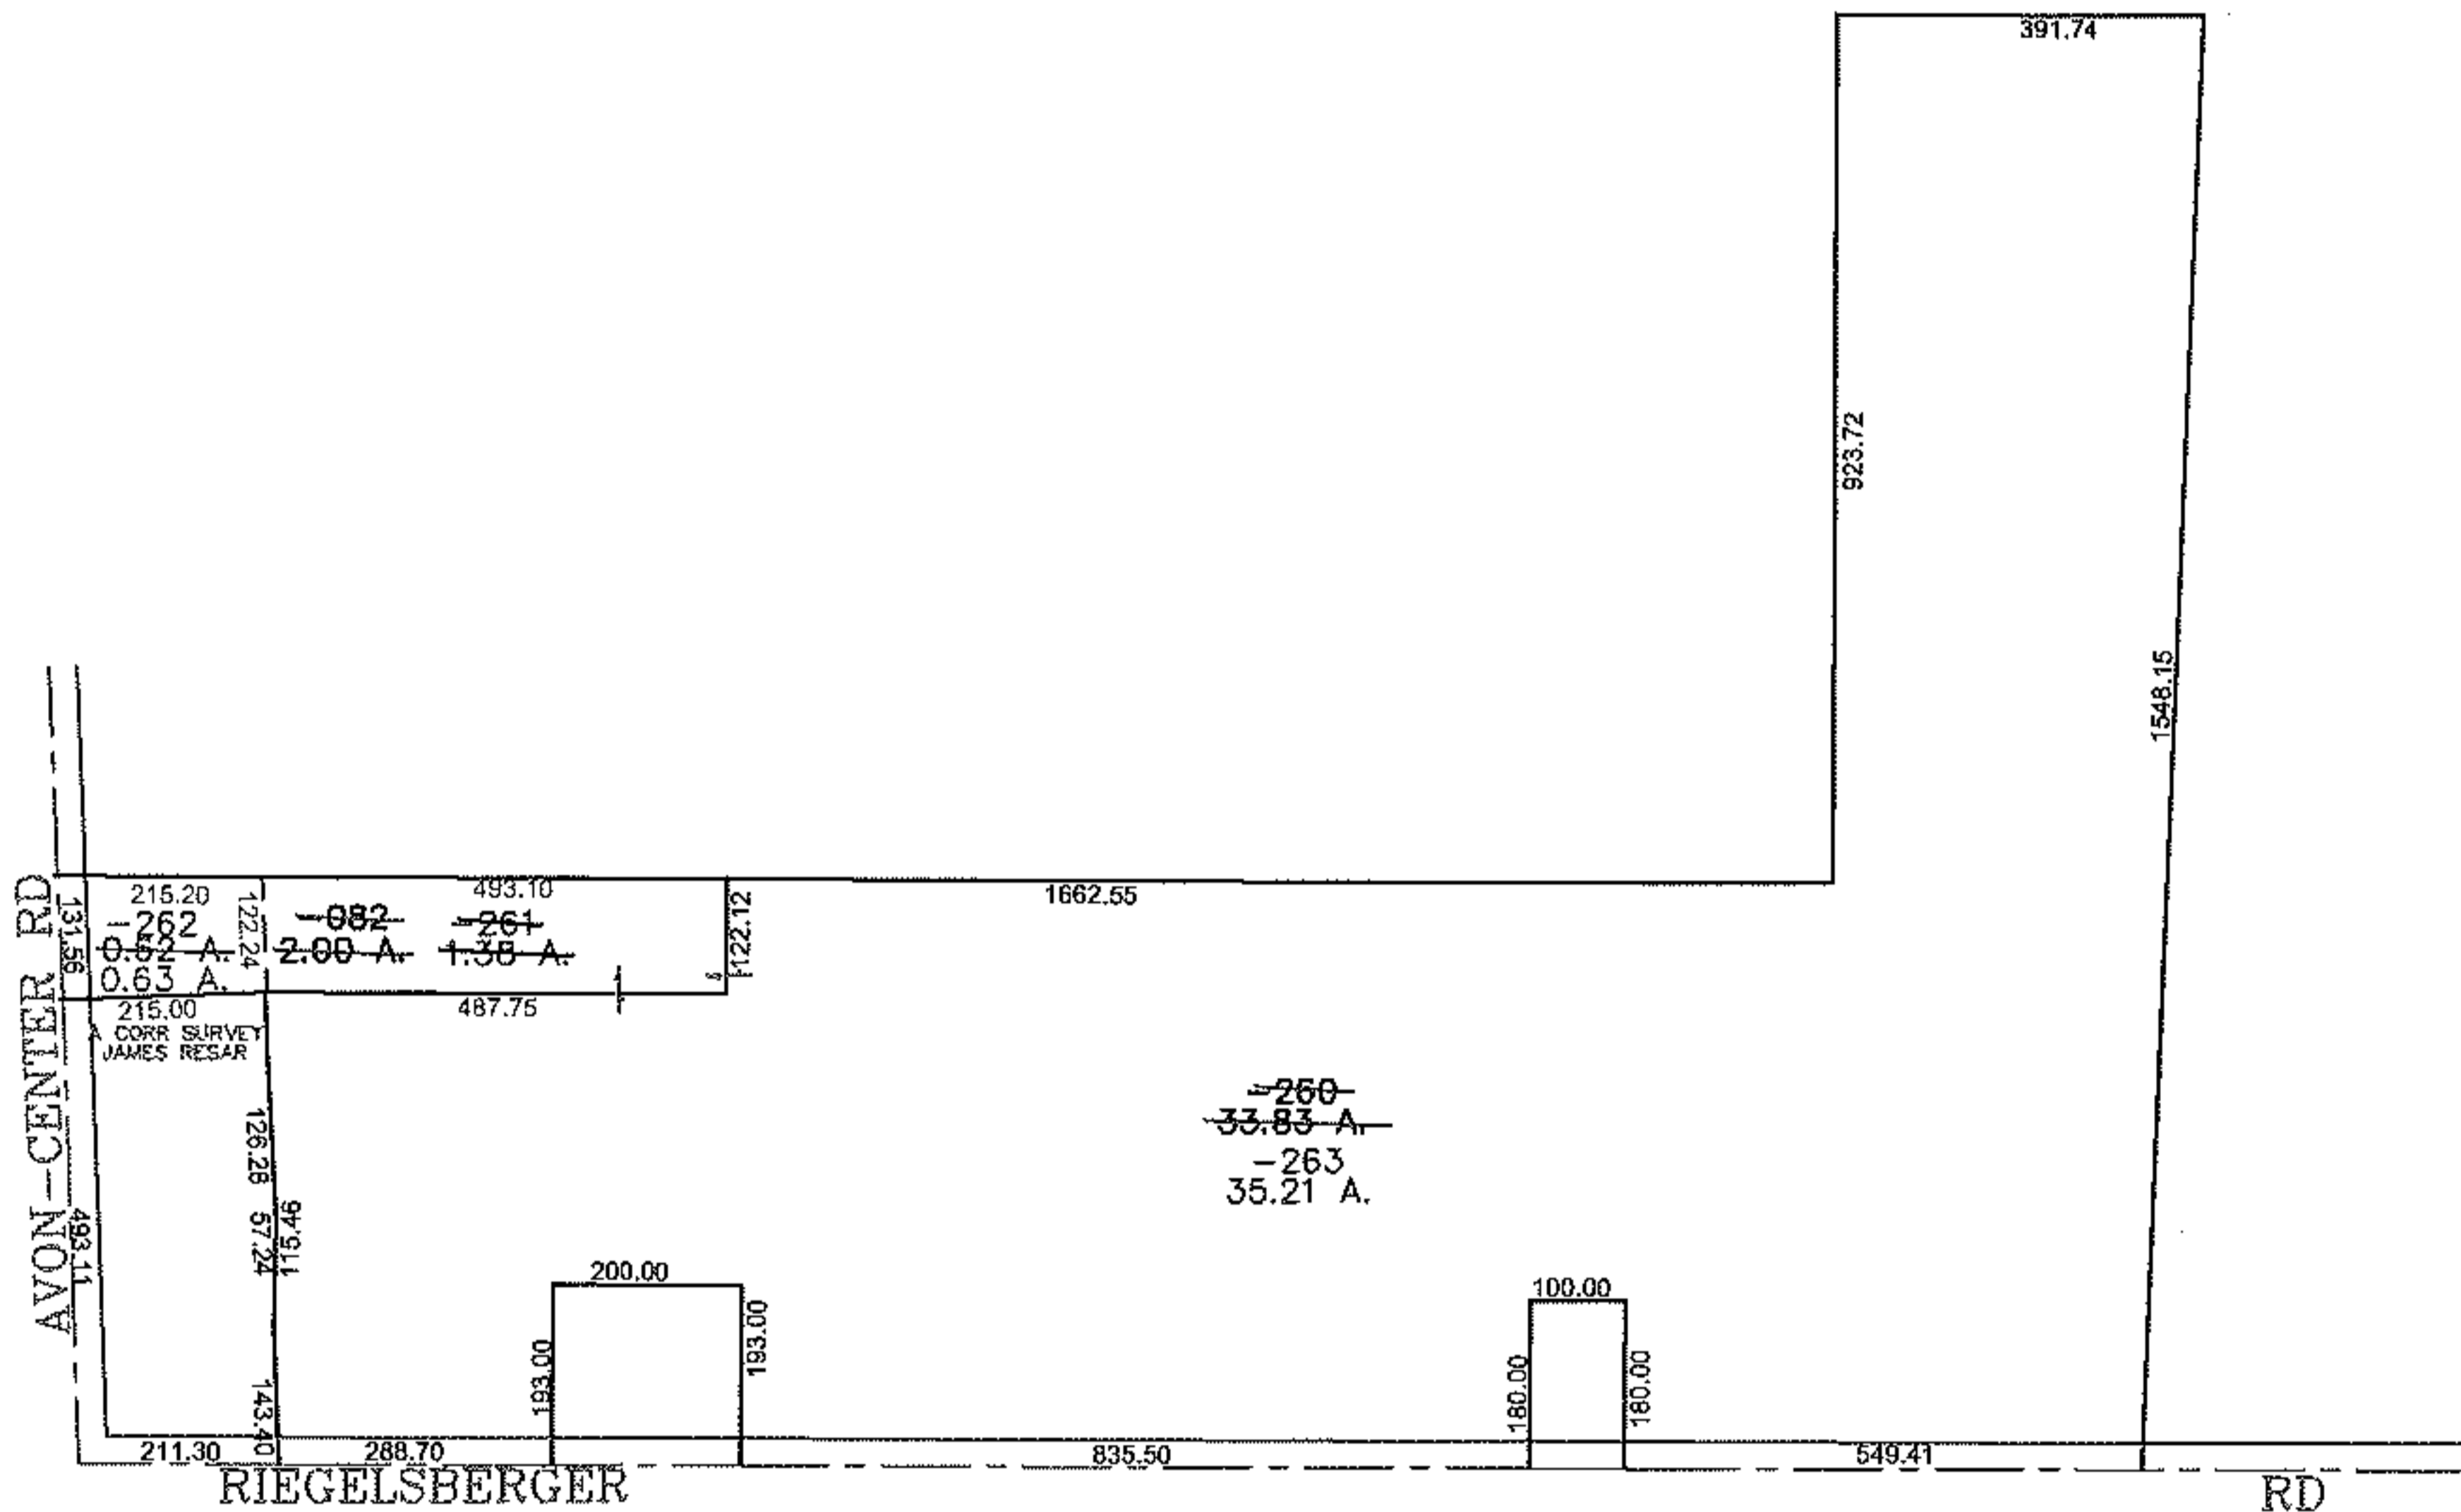


PARENT PARCEL: 04-00-014-107-082, 04-00-014-107-260

CHILD PARCEL: 04-00-014-107-261, -262, -263

STARTING POINT: CENTERLINE OF AVON-CENTER RD & RIEGELSBERGER RD

13-03144

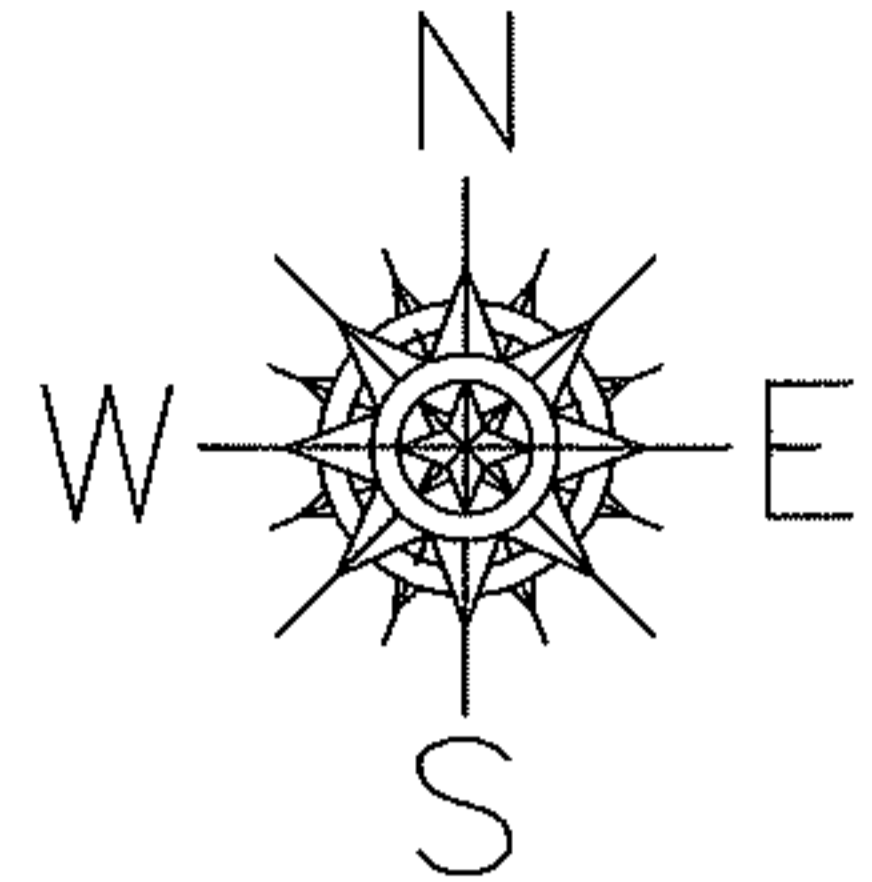

SPLITS/DEEDS PROCESSED

LORAIN COUNTY TAX MAP DEPARTMENT
226 MIDDLE AVE. ELYRIA, OHIO

SURVEYED BY: JAMES RESAR

CLOSURE: 0.00 : 10,000

MAP PAGE(S): 04-00-014-G

APPROVED BY: JAH DATE: 5/28/2013

SCALE: 1"= 400 PRIOR INST.: 20050117530