
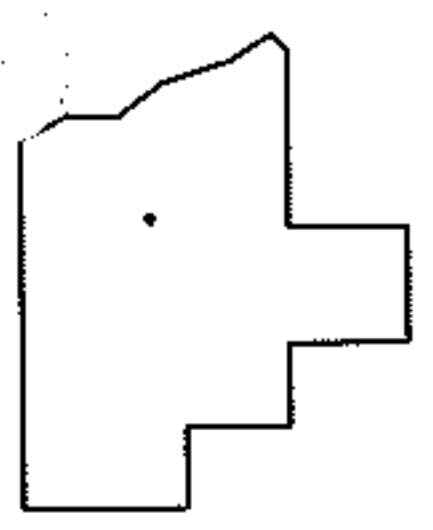
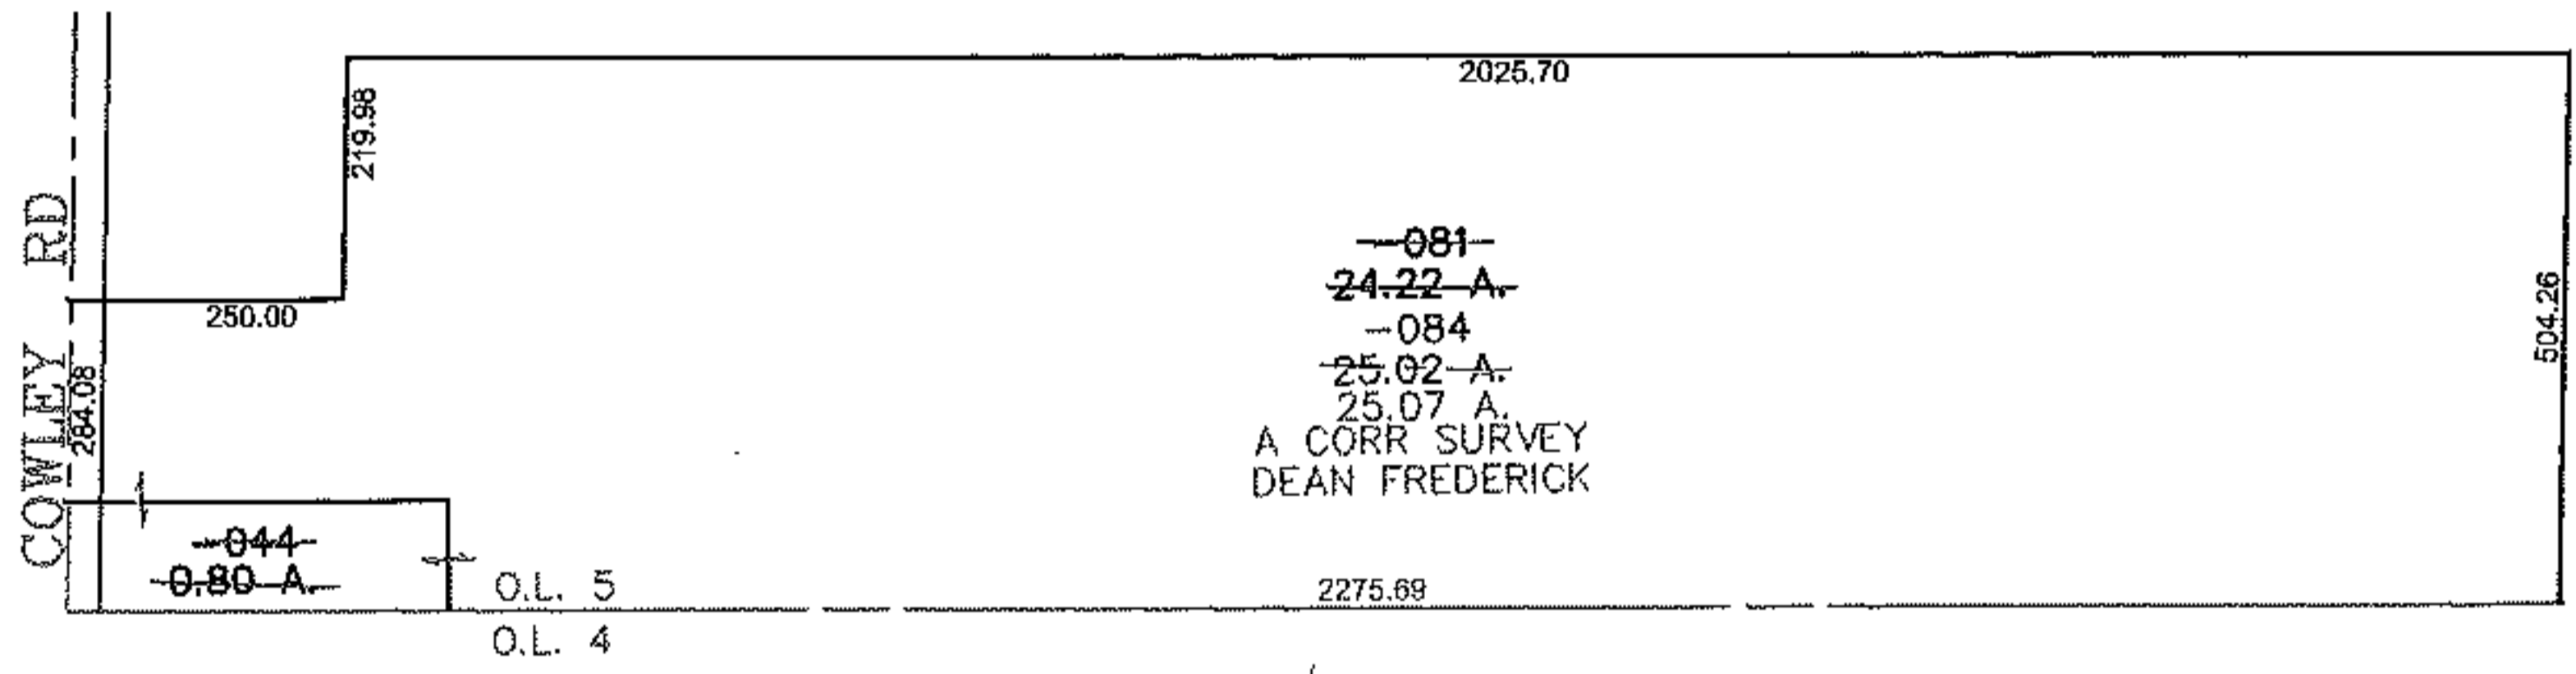


PARENT PARCEL: 11-00-005-000-081, -044

CHILD PARCEL: 11-00-005-000-084

STARTING POINT: CENTERLINE OF COWLEY RD & O.L. 5

13-03148

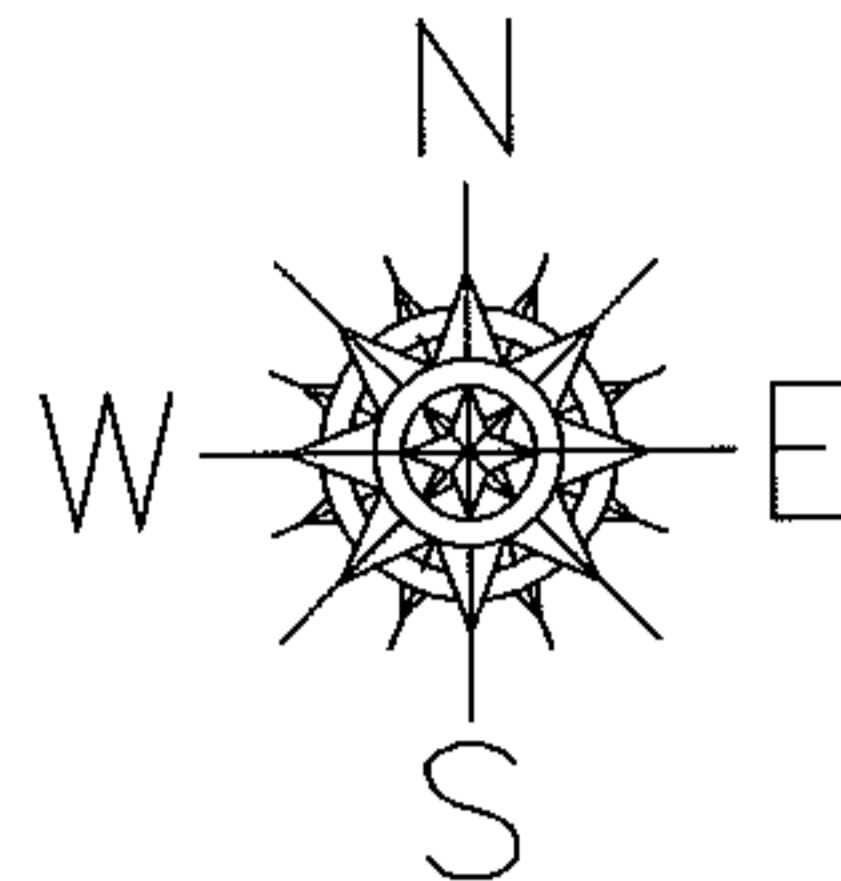

SPLITS/DEEDS PROCESSED

LORAIN COUNTY TAX MAP DEPARTMENT
226 MIDDLE AVE. ELYRIA, OHIO

SURVEYED BY: DEAN FREDERICK
CLOSURE: 0.00 : 10,000
MAP PAGE(S): 11-00-005-A
APPROVED BY: JAH DATE: 5/29/2013
SCALE: 1"= 400 PRIOR INST.: 20050099958