
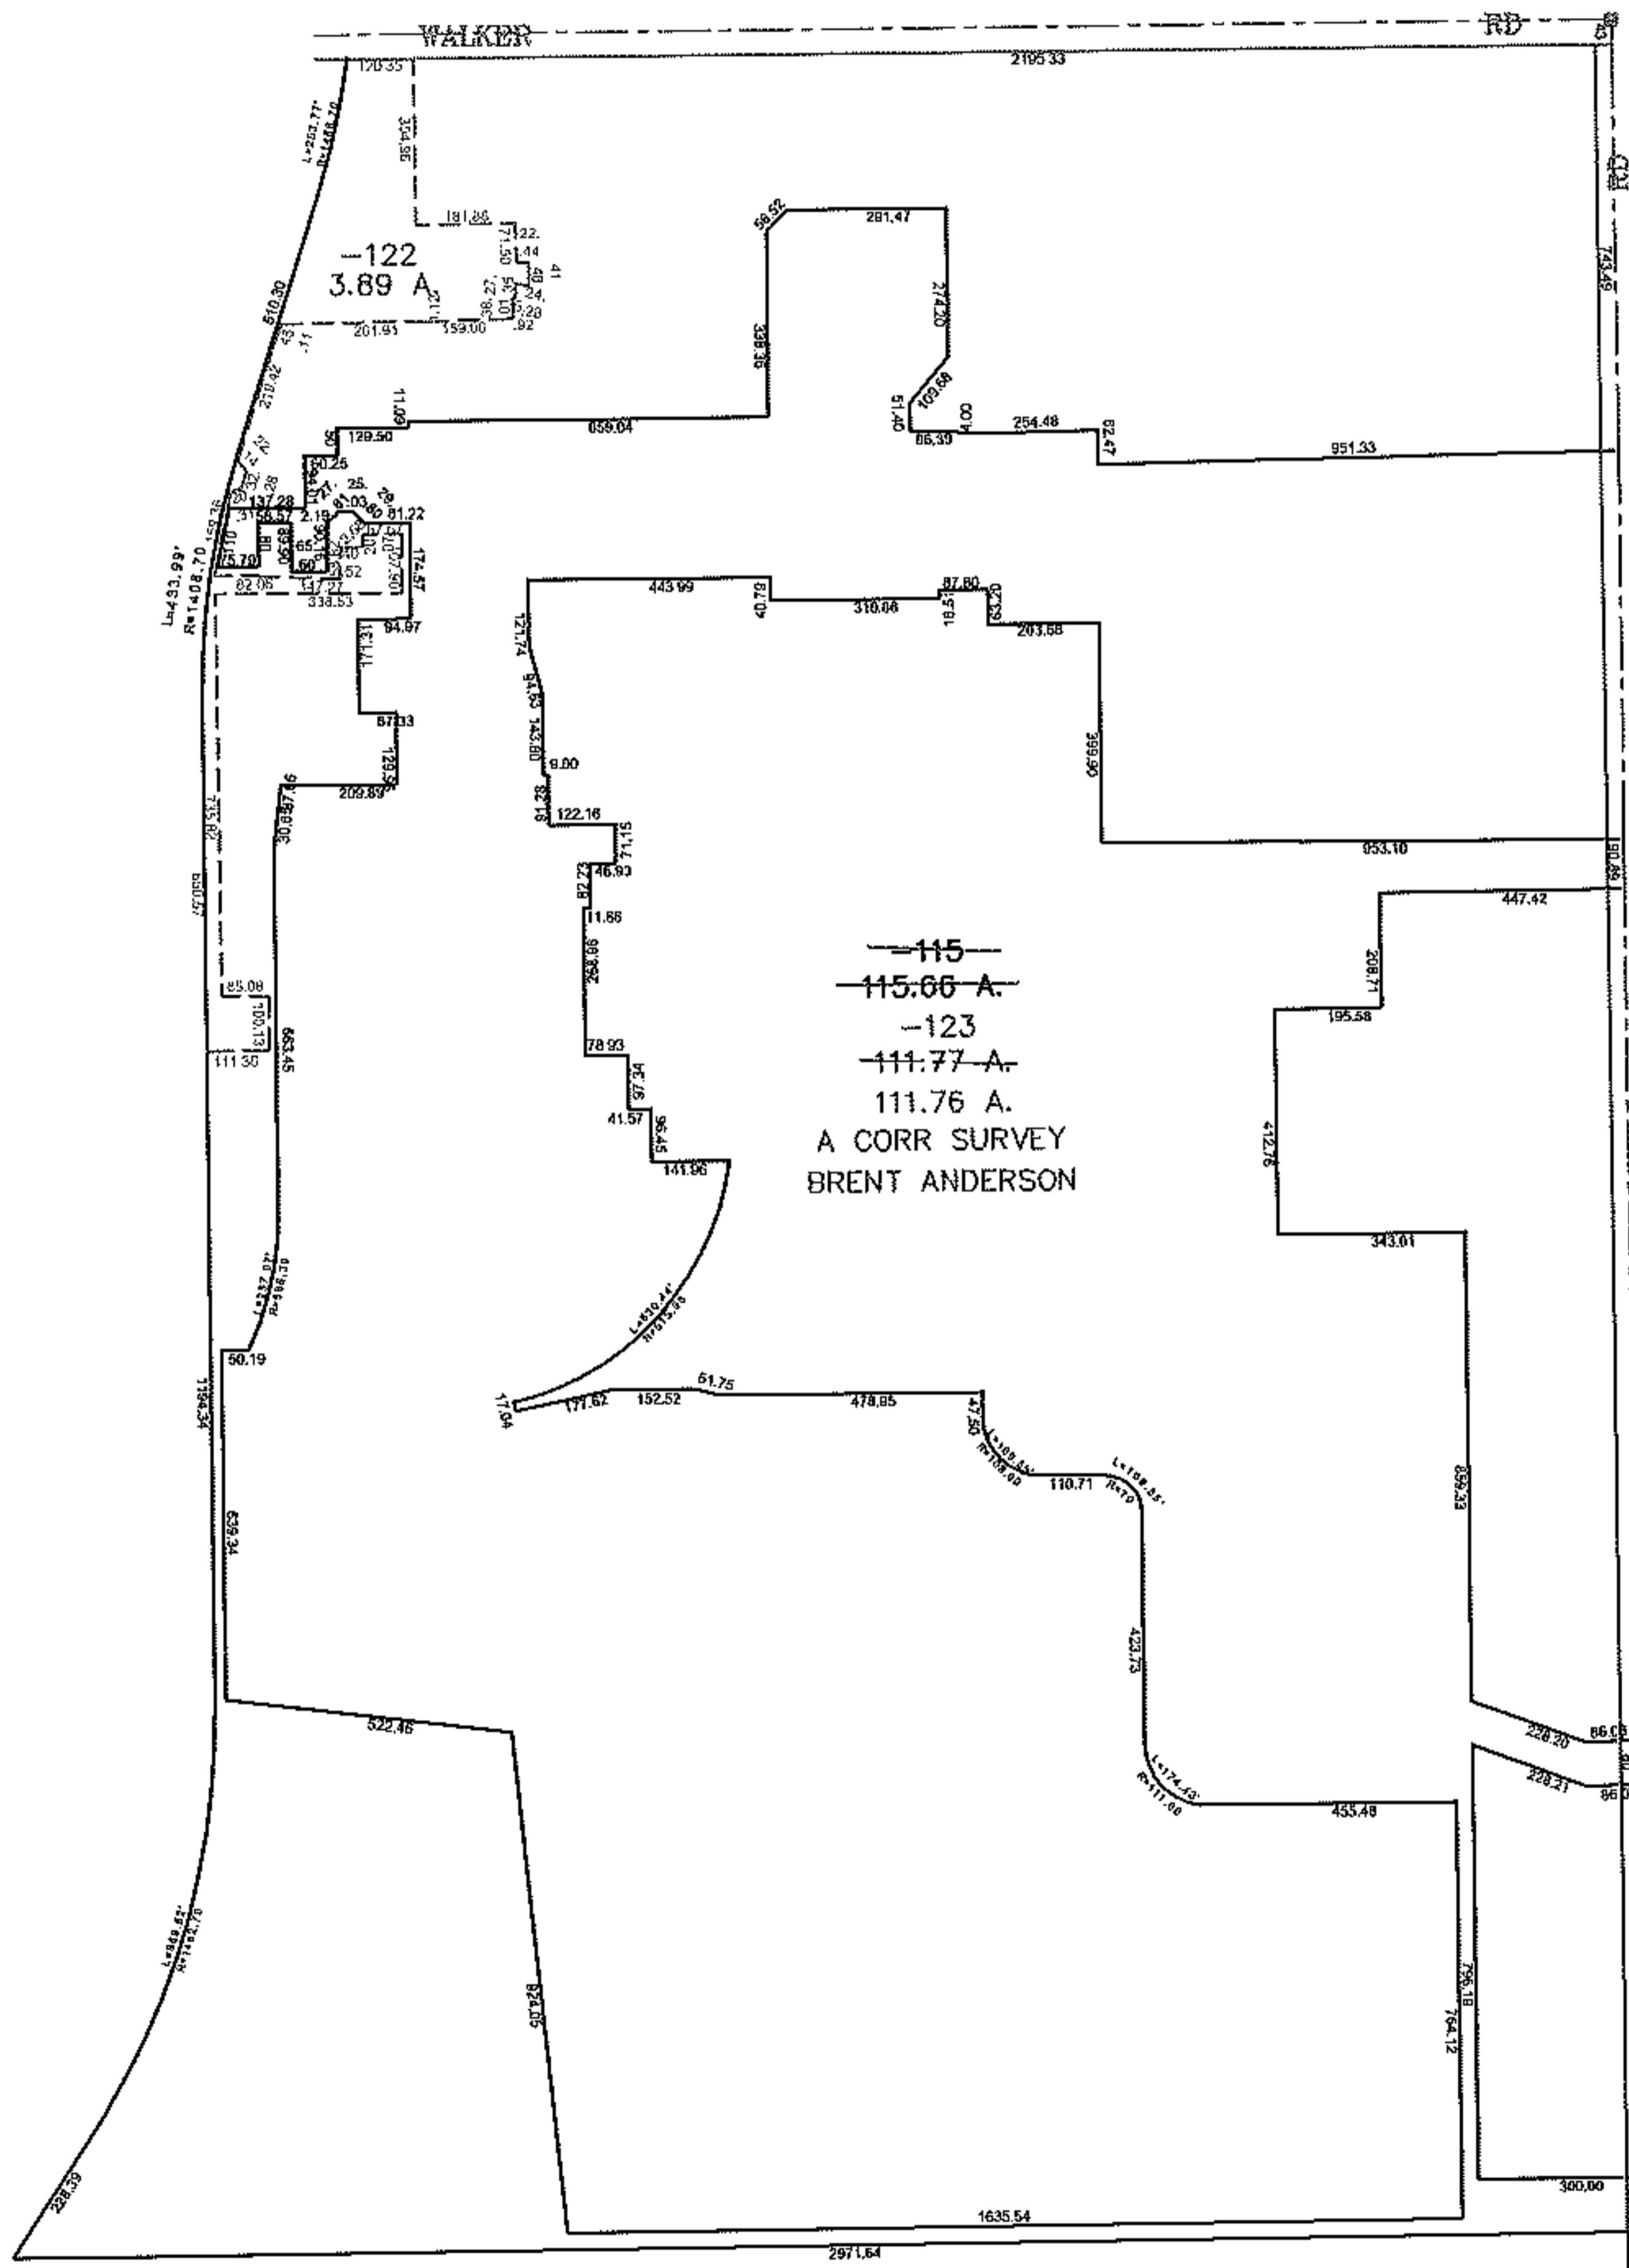


PARENT PARCEL: 04-00-005-000-115

CHILD PARCEL: 04-00-005-000-122, -123

STARTING POINT: CENTERLINE OF WALKER RD & MOORE RD

13-03149

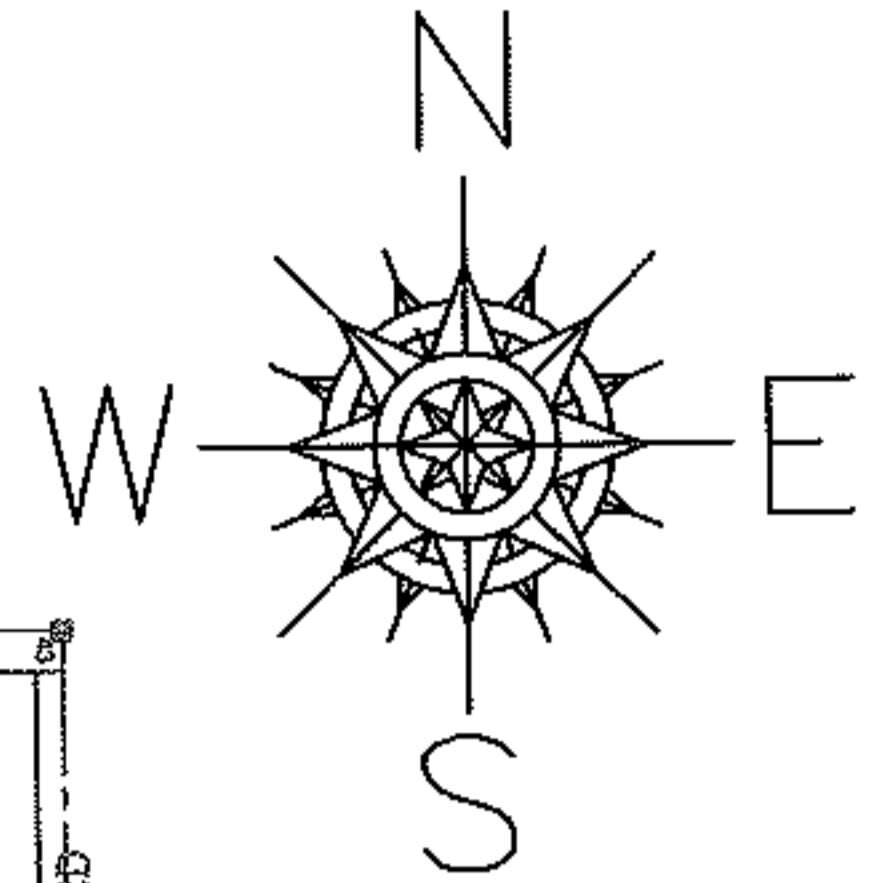

**SPLITS/DEEDS PROCESSED**

LORAIN COUNTY TAX MAP DEPARTMENT  
226 MIDDLE AVE. ELYRIA, OHIO

SURVEYED BY: BRENT ANDERSON

CLOSURE: 0.00 : 10.00

MAP PAGE(S): 04-00-005-D

APPROVED BY: JAH DATE: 5-29-2013

SCALE: 1" = 600 PRIOR INSTRUMENT: 20060141307