


PARENT PARCEL: 03-00-001-000-144

CHILD PARCEL: _____

STARTING POINT: _____

15-03151-A

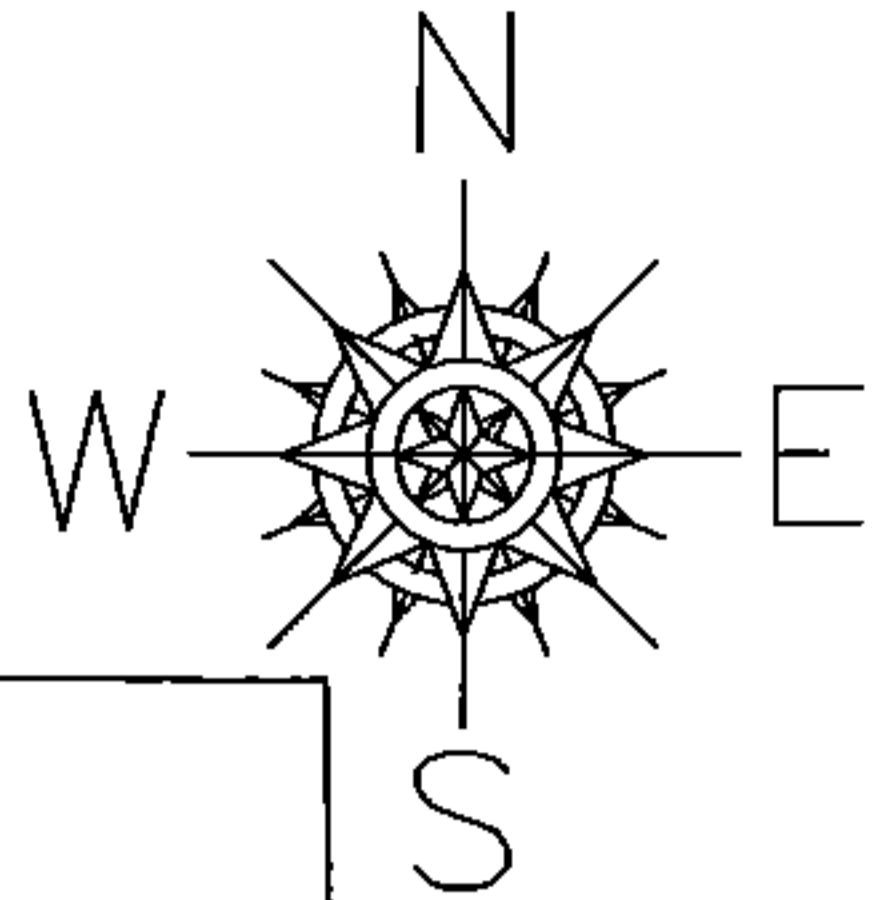

EXCEPTION
0.04 A.

48.21
74.72
47.78

400.32

535.86

-144
~~6.48 A.~~
6.46 A.

AC. CORR. PER. SURV.
KS ASSOC.

658.04

WATERFORD DR.

R=240
L=92.87

30
30

R=180
L=53.95


118.12

168.00

HOAG DR.

SEE OR VOLUME 1439/488 &
INSTRUMENT NO. 2002-0859561

229.65

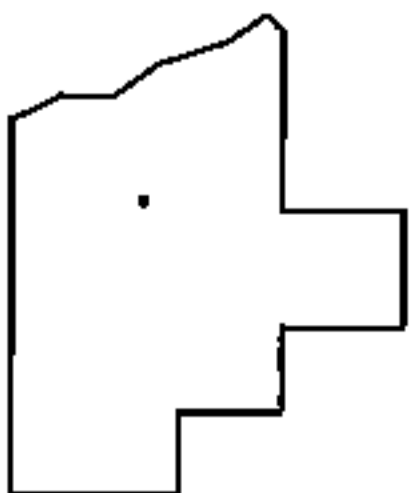

SPLITS/DEEDS PROCESSED

LORAIN COUNTY TAX MAP DEPARTMENT
226 MIDDLE AVE. ELYRIA, OHIO

SURVEYED BY: KS ASSOCIATES

CLOSURE: .01:10,000

MAP PAGE(S): 3-00-001-A

APPROVED BY: RRM DATE: 4-20-15

SCALE: 1"= 100 PRIOR INST.: SEE ABOVE