


PARENT PARCEL: 18-00-021-110-ALL P.P.N. SHOWN

CHILD PARCEL: XX-XX-XXX-XXX-XXX

STARTING POINT: CORRECTING THIS ENTIRE AREA

15-03152-C

MAP CORRECTION PER DEEDS OF ALL PARCELS SHOWN

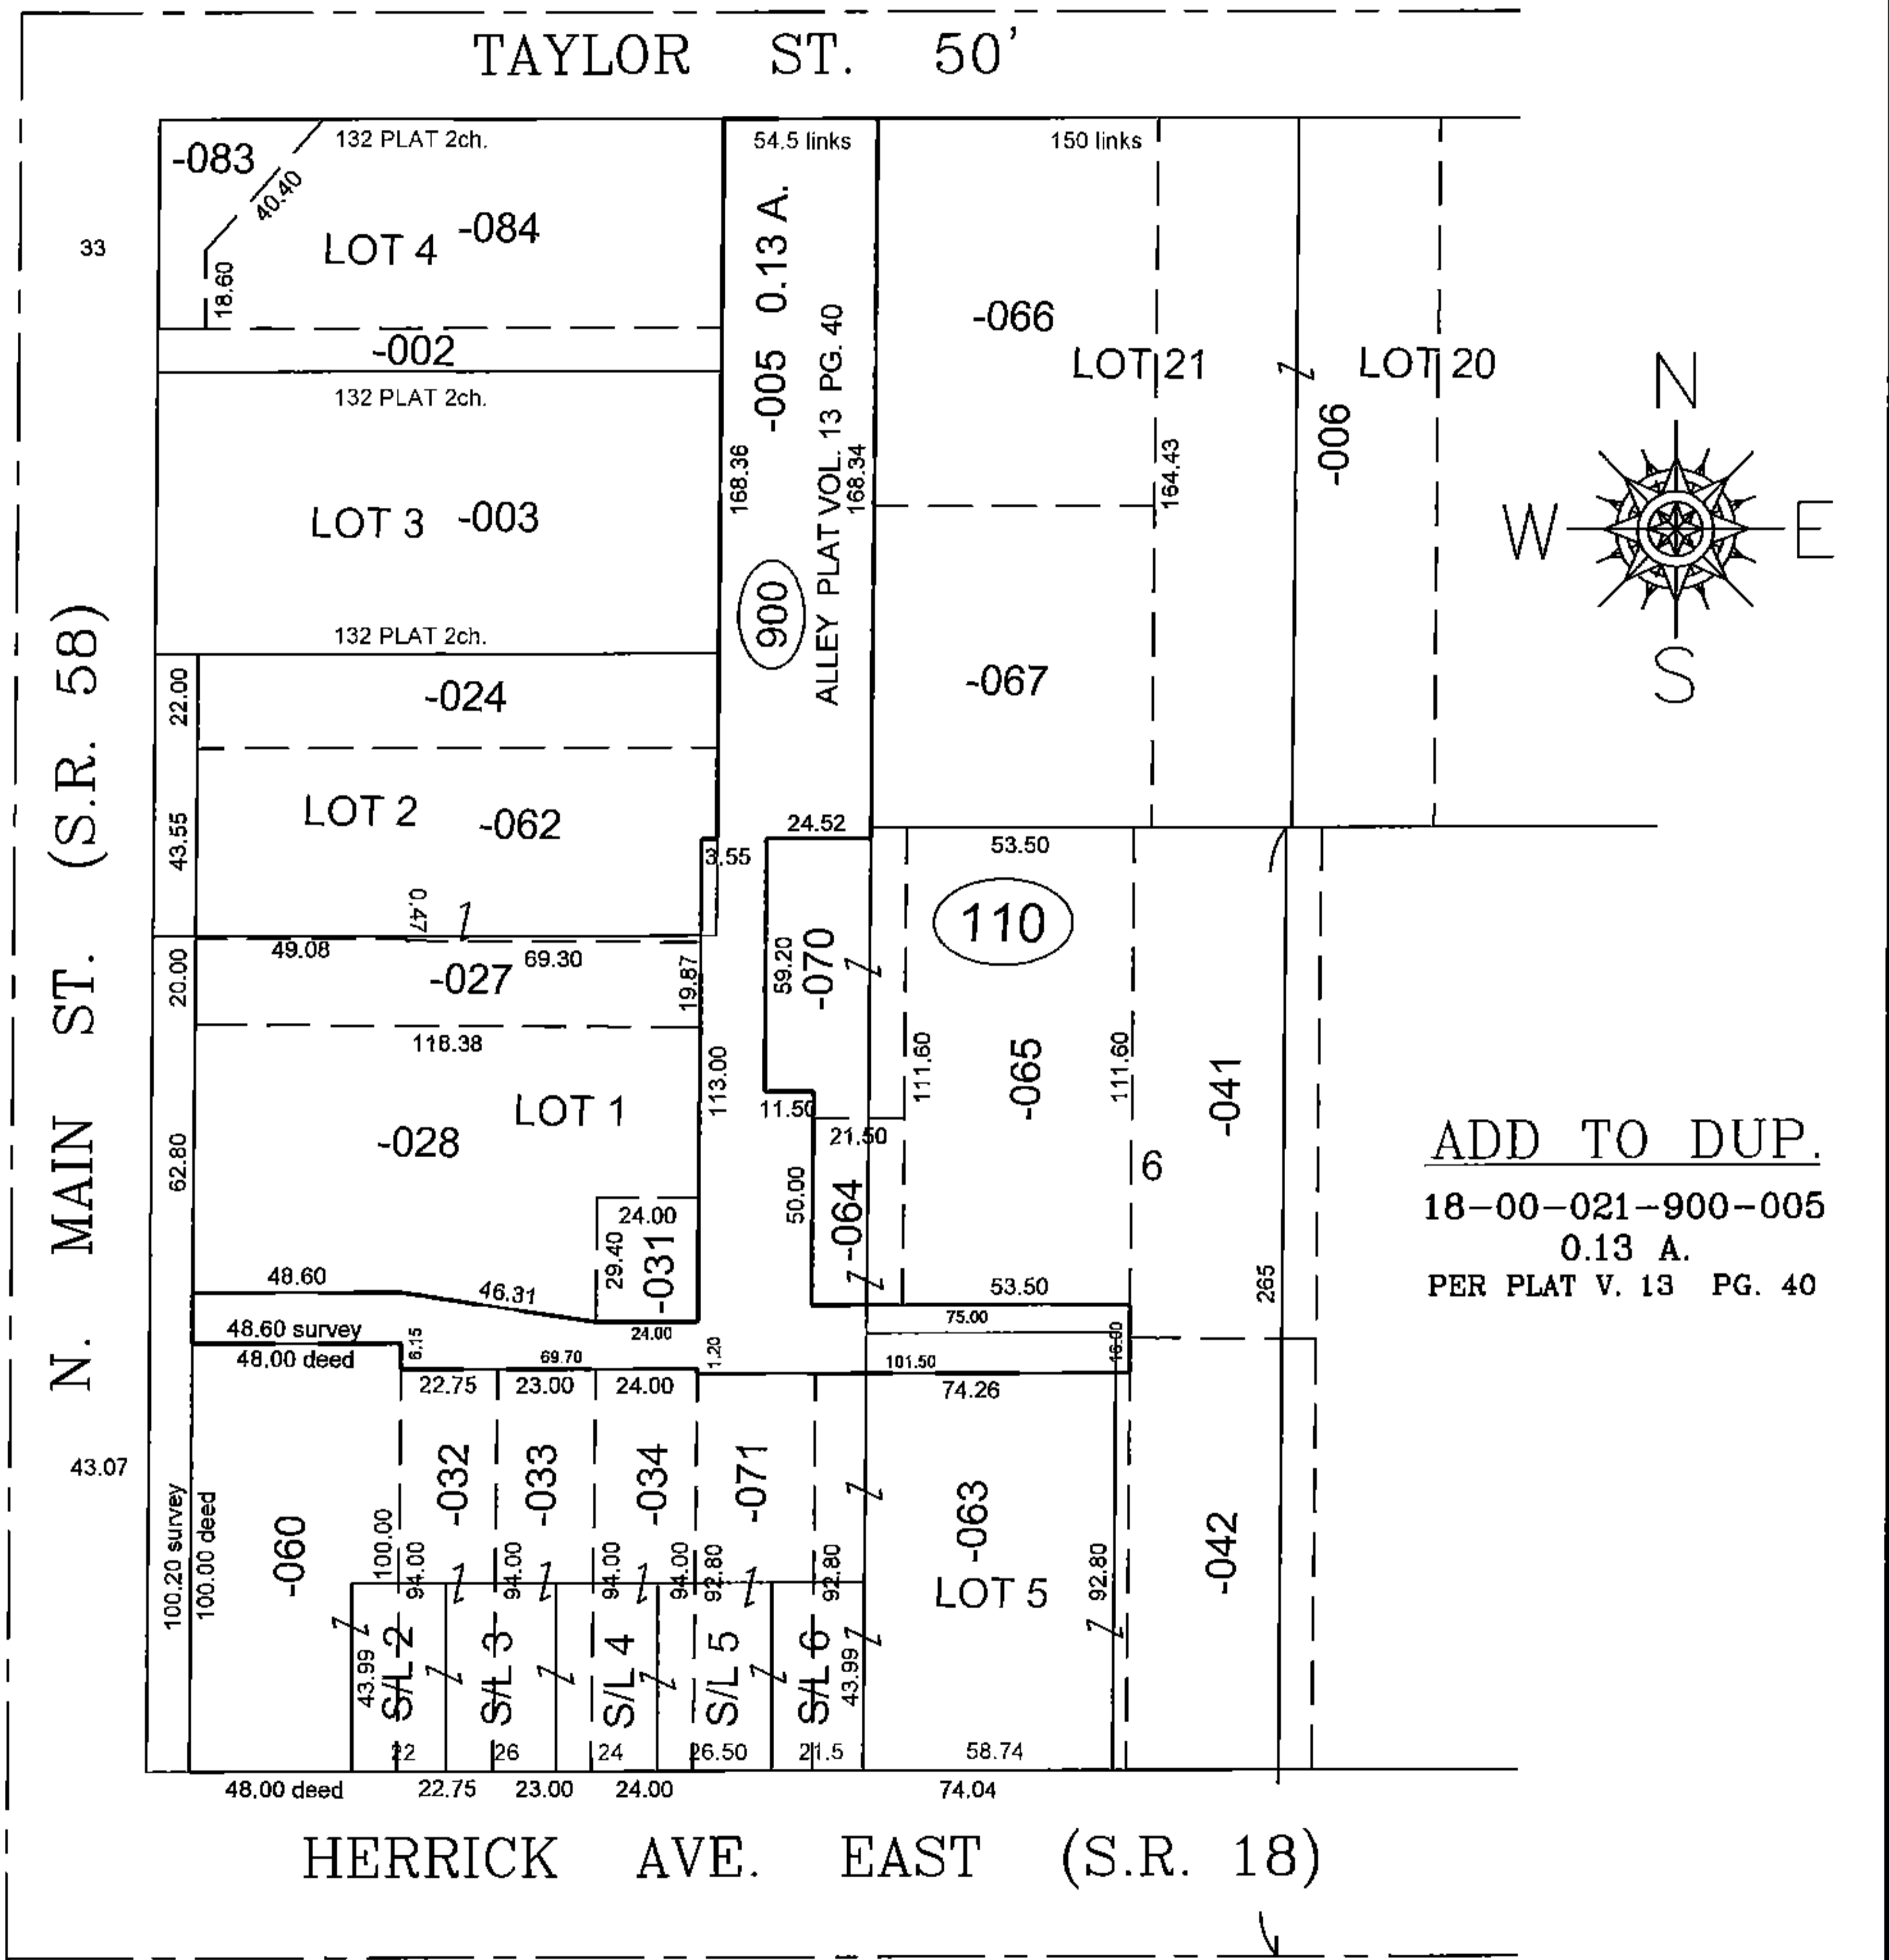

ADD TO DUP.
 18-00-021-900-005
 0.13 A.
 PER PLAT V. 13 PG. 40

SPLITS/DEEDS PROCESSED

LORAIN COUNTY TAX MAP DEPARTMENT
 226 MIDDLE AVE. ELYRIA, OHIO

SURVEYED BY: NA
 CLOSURE: NA
 MAP PAGE(S): 18-00-021-C
 APPROVED BY: TJS DATE: 4/23/15
 SCALE: 1" = 100' PRIOR INSTRUMENT: DV XXXX/XXX