
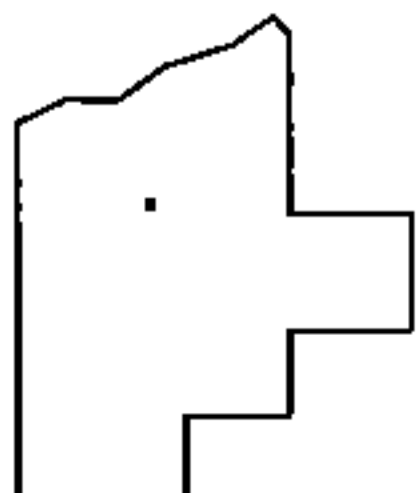
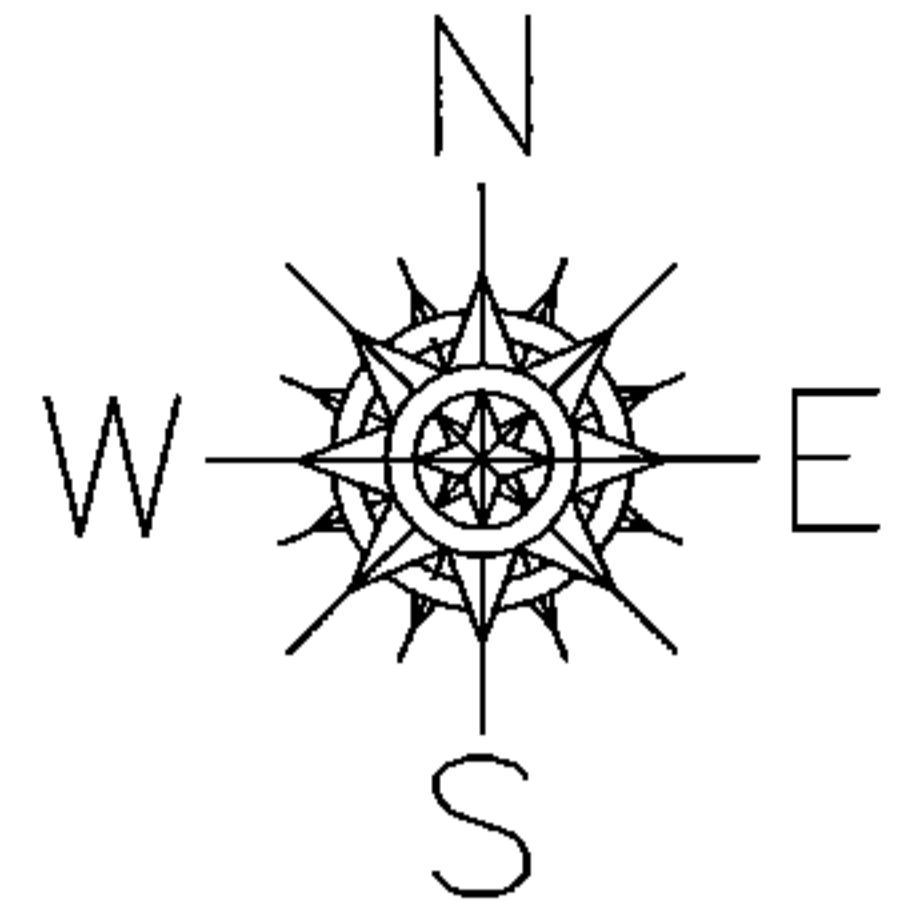


PARENT PARCEL: 04-00-027-101-177

CHILD PARCEL: _____

STARTING POINT: AT A MON BOX AT THE INTERSECTION OF C/L OF WALNUT DR. AND C/L OF PINE CT.

15-03154-A

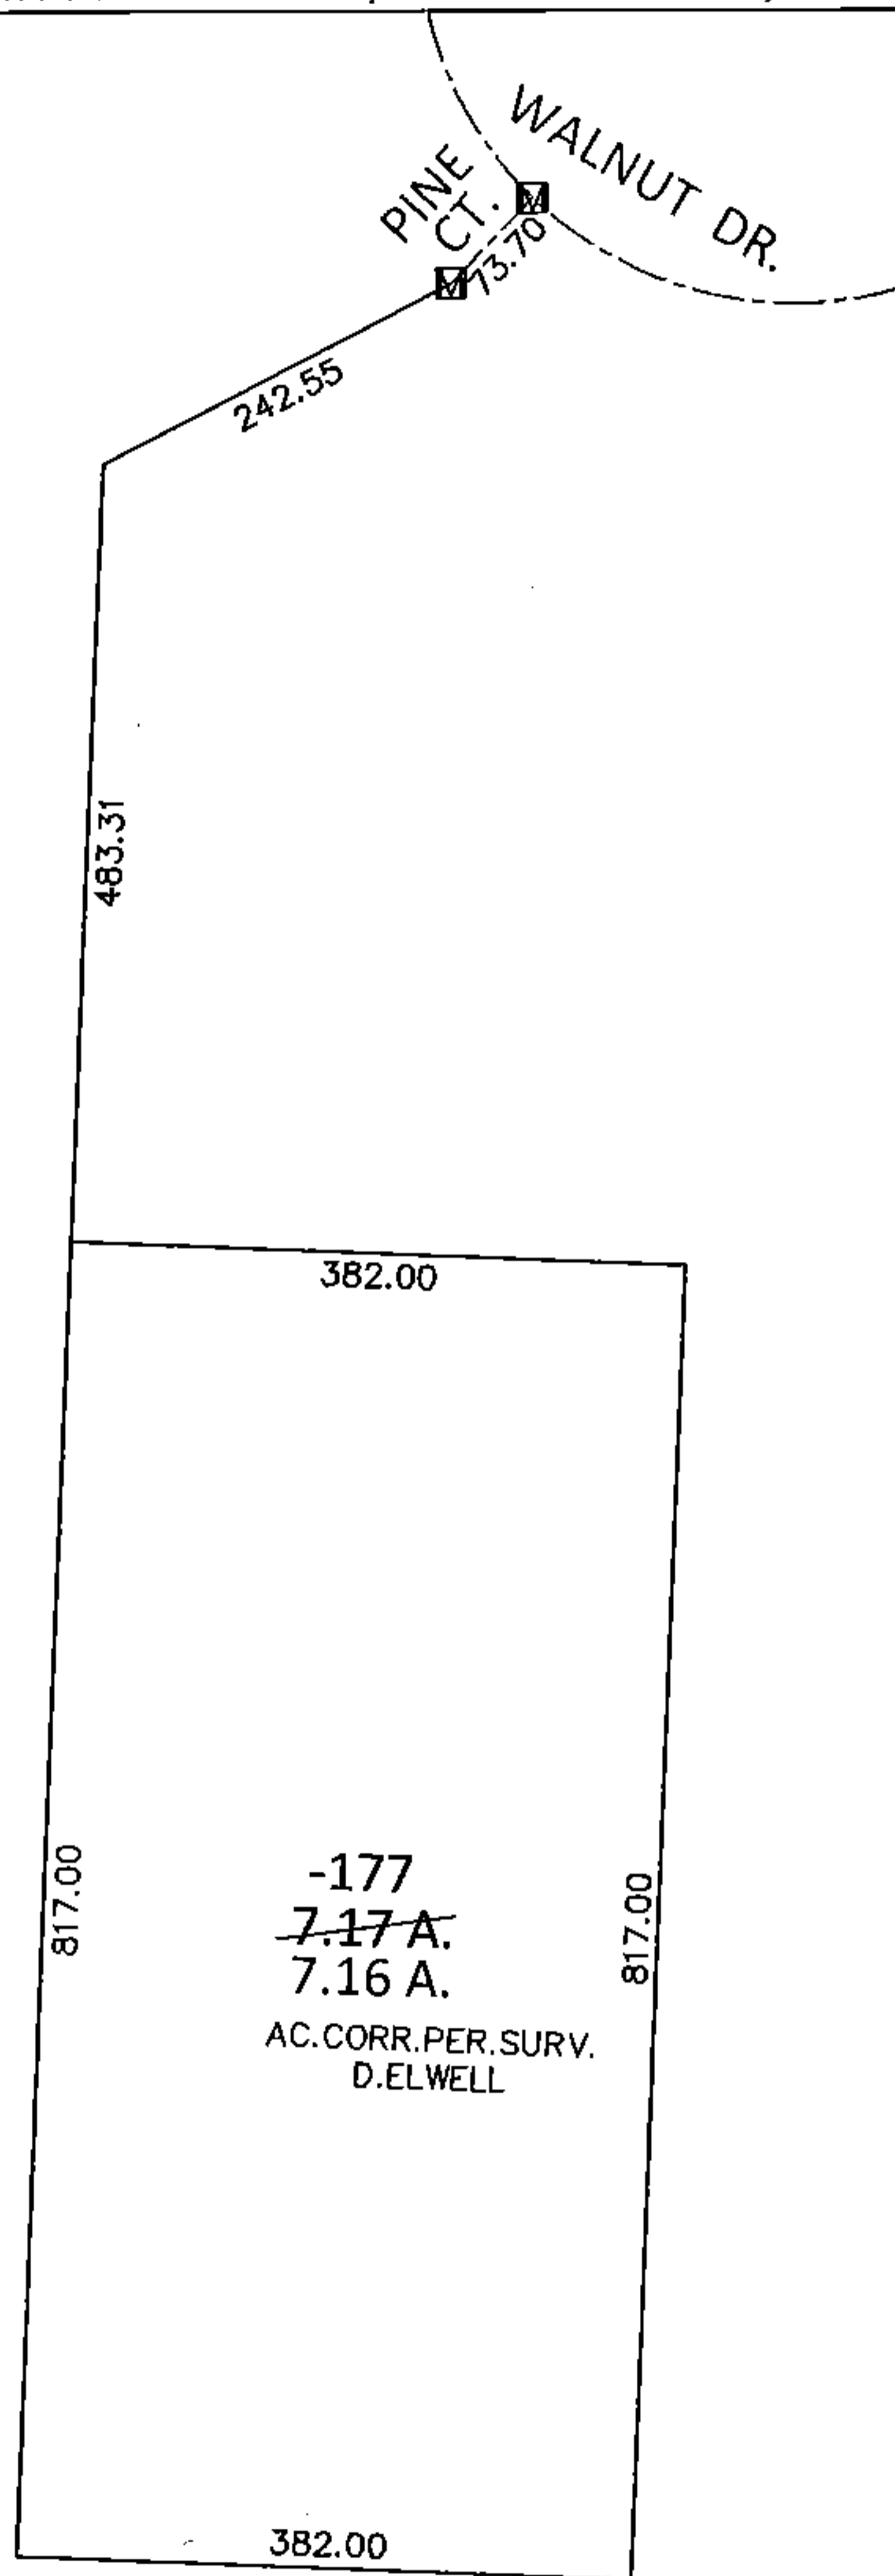

SPLITS/DEEDS PROCESSED

LORAIN COUNTY TAX MAP DEPARTMENT
226 MIDDLE AVE. ELYRIA, OHIO

SURVEYED BY: DAVID L. ELWELL

CLOSURE: .00:10,000

MAP PAGE(S): 4-00-027-B & F

APPROVED BY: RRM DATE: 4-24-15

SCALE: 1"= 200 PRIOR INST.: 20070197599