
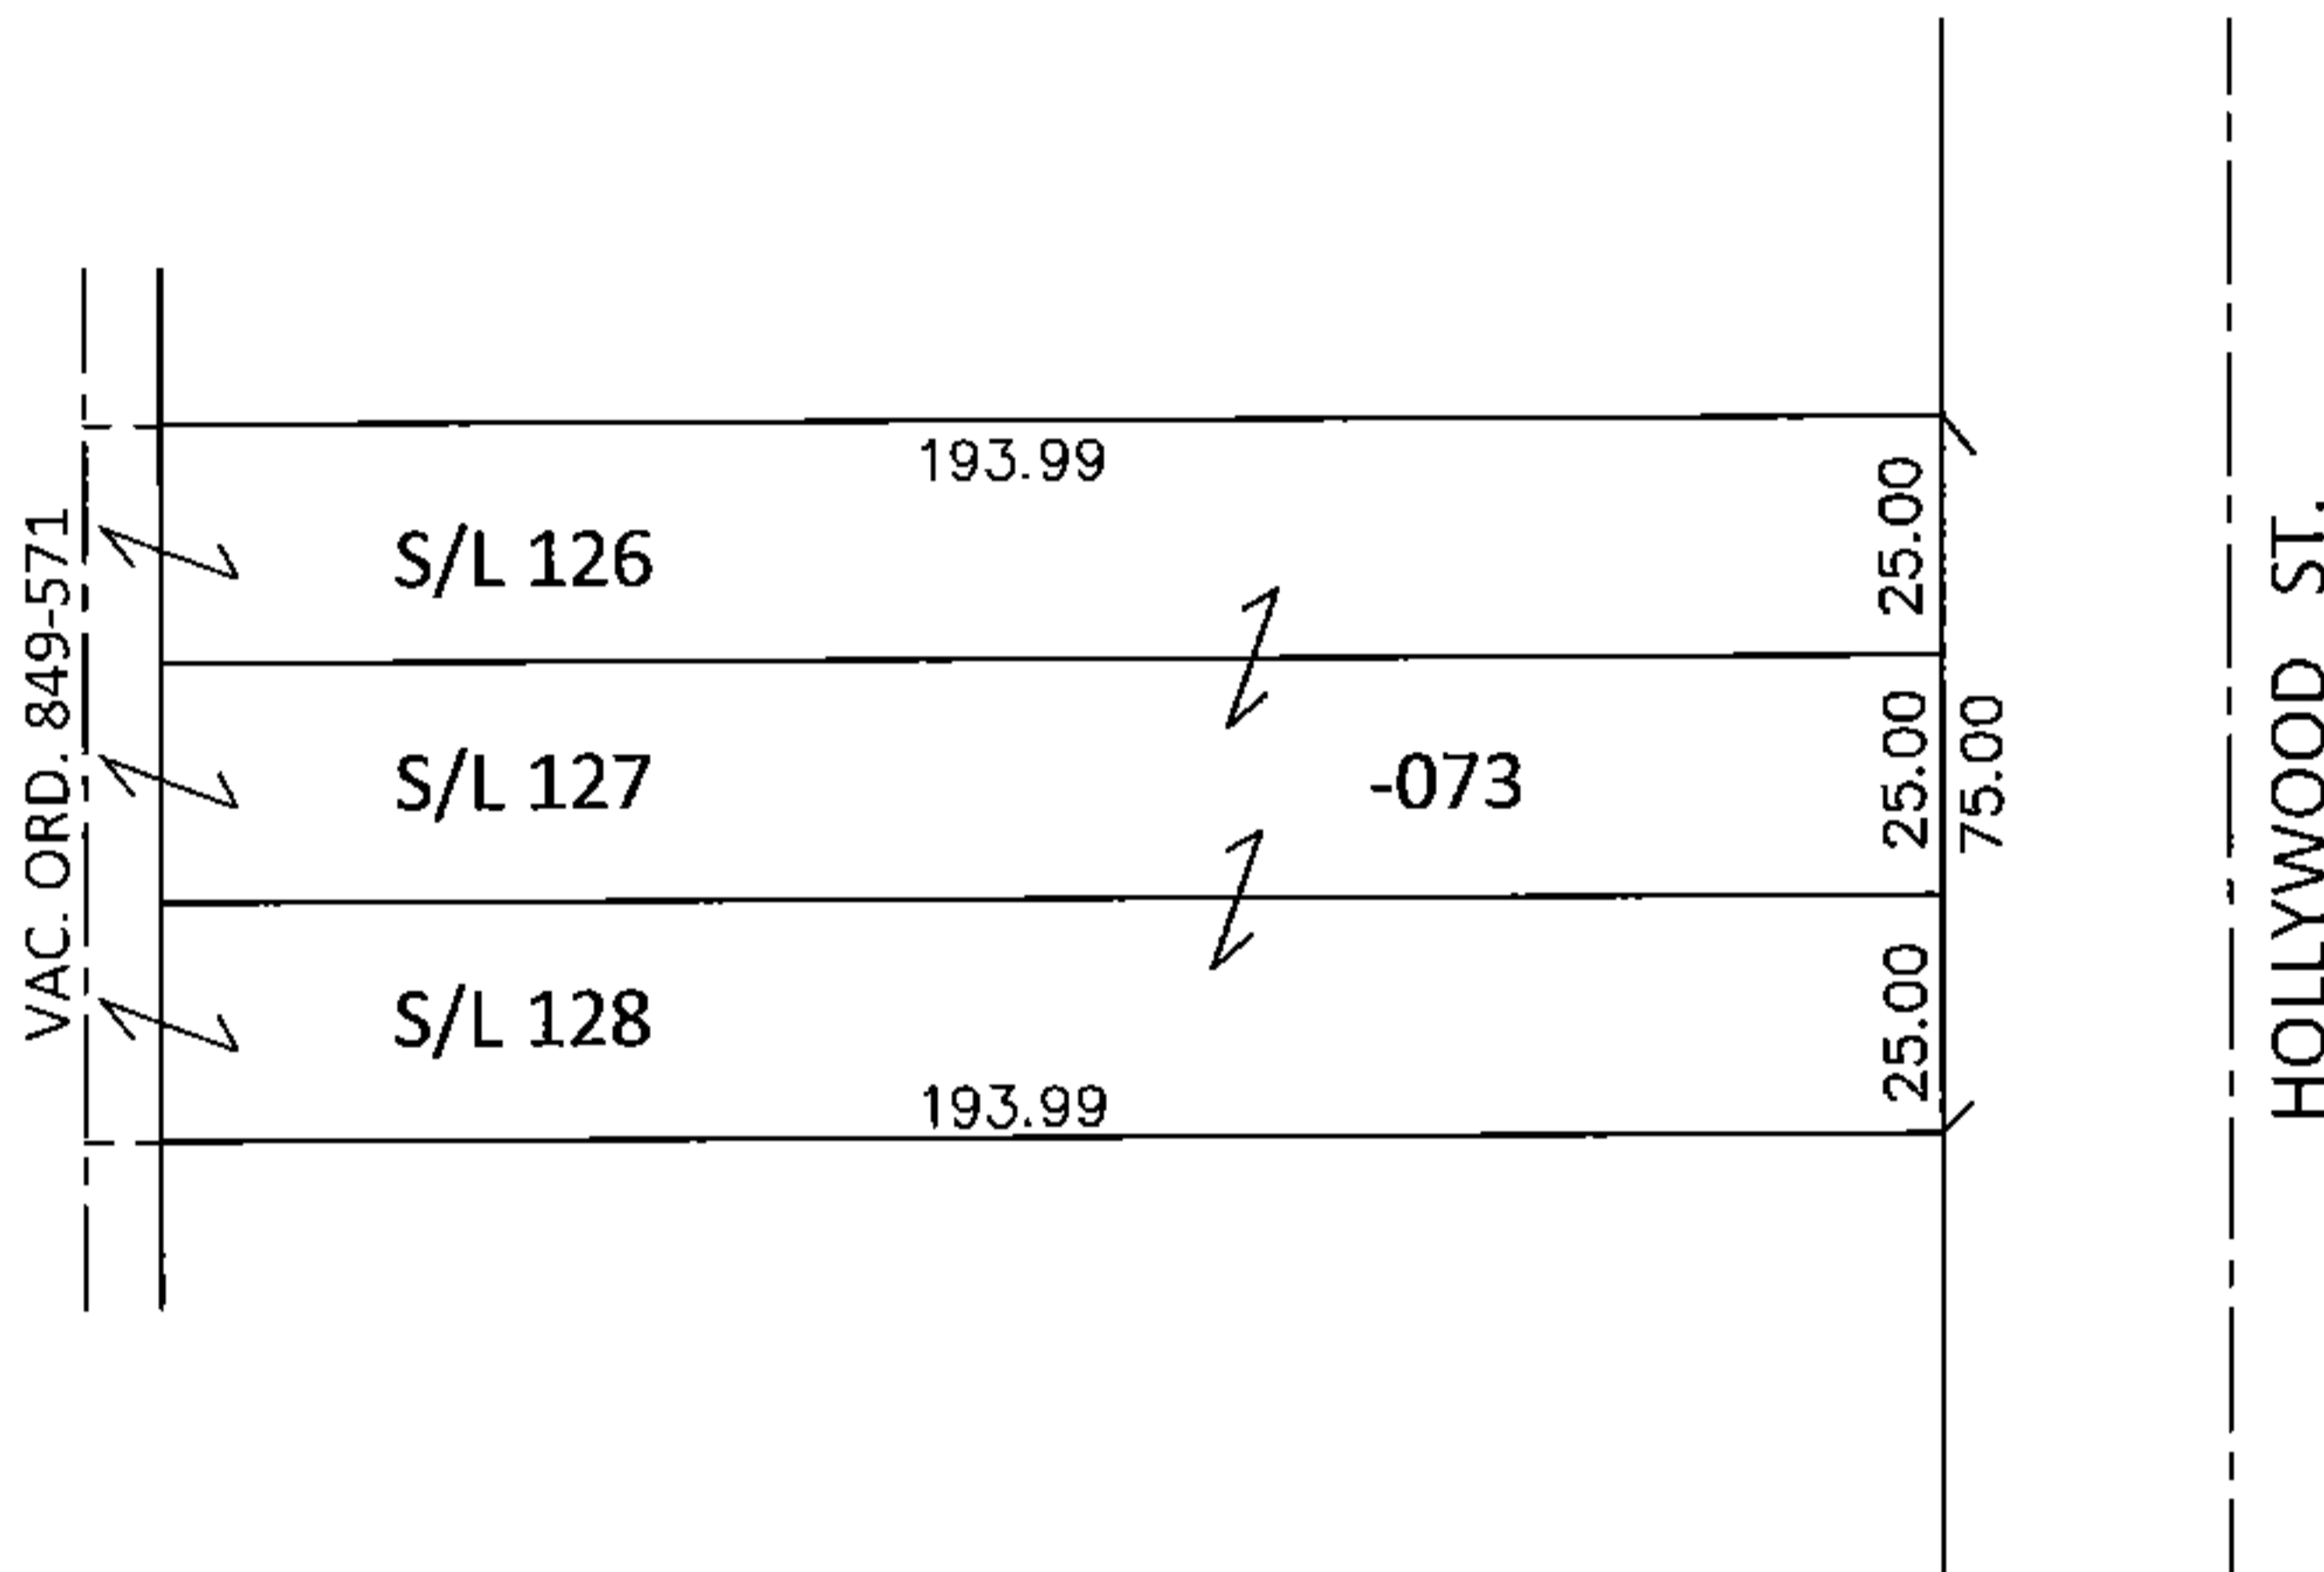


PARENT PARCEL: 09-00-075-101-073

CHILD PARCEL: _____

STARTING POINT: S/L'S 126 THRU 128 IN HOLLYWOOD ADD. (VOL.7 PG.55)

15-03157-C

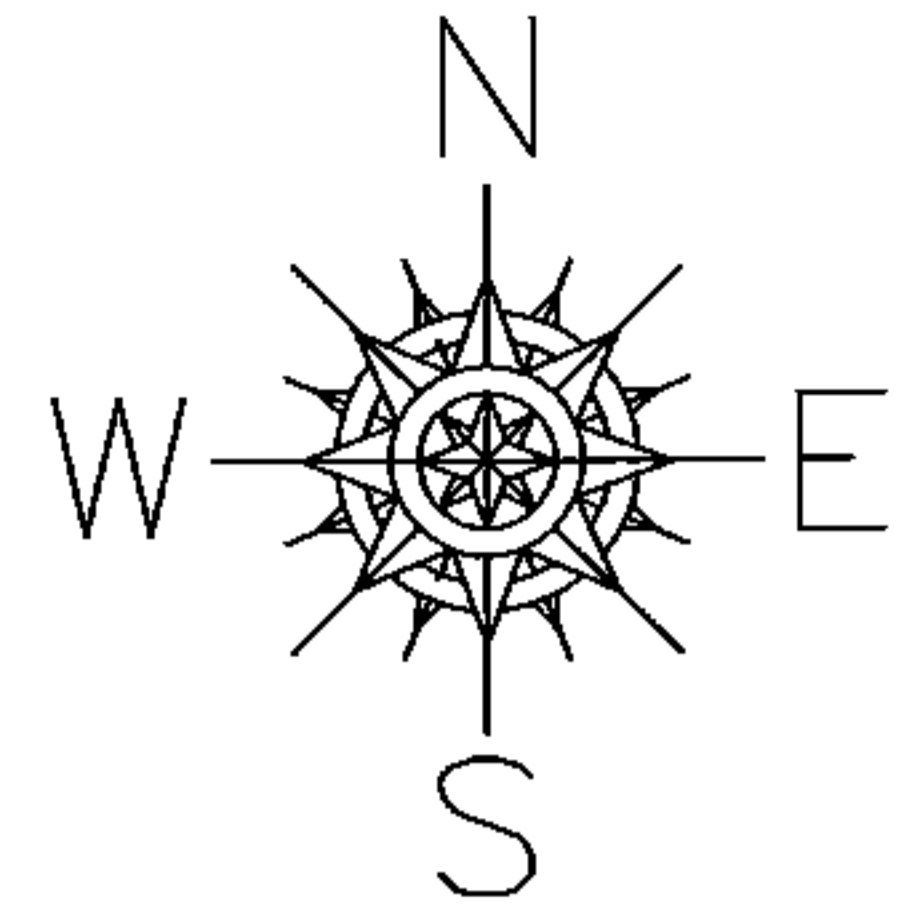


DEPTH CORRECTION

09-00-075-101-073

193.99

75 X 186

CORR.PER.DEED & ORD. 849-571

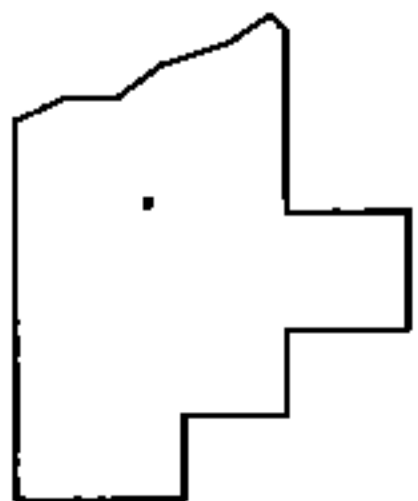

SPLITS/DEEDS PROCESSED

LORAIN COUNTY TAX MAP DEPARTMENT
226 MIDDLE AVE. ELYRIA, OHIO

SURVEYED BY: N/A

CLOSURE: N/A

MAP PAGE(S): 9-00-075-A

APPROVED BY: RRM DATE: 4-28-15

SCALE: 1"= 50' PRIOR INST.: 20140513095