
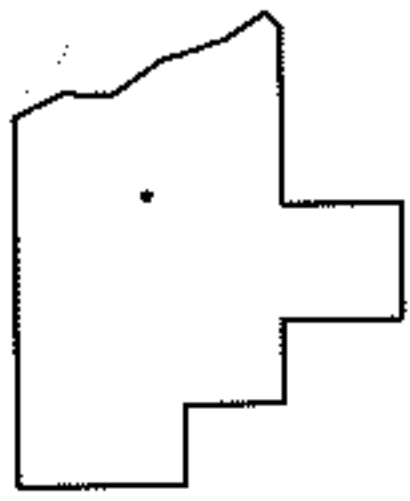
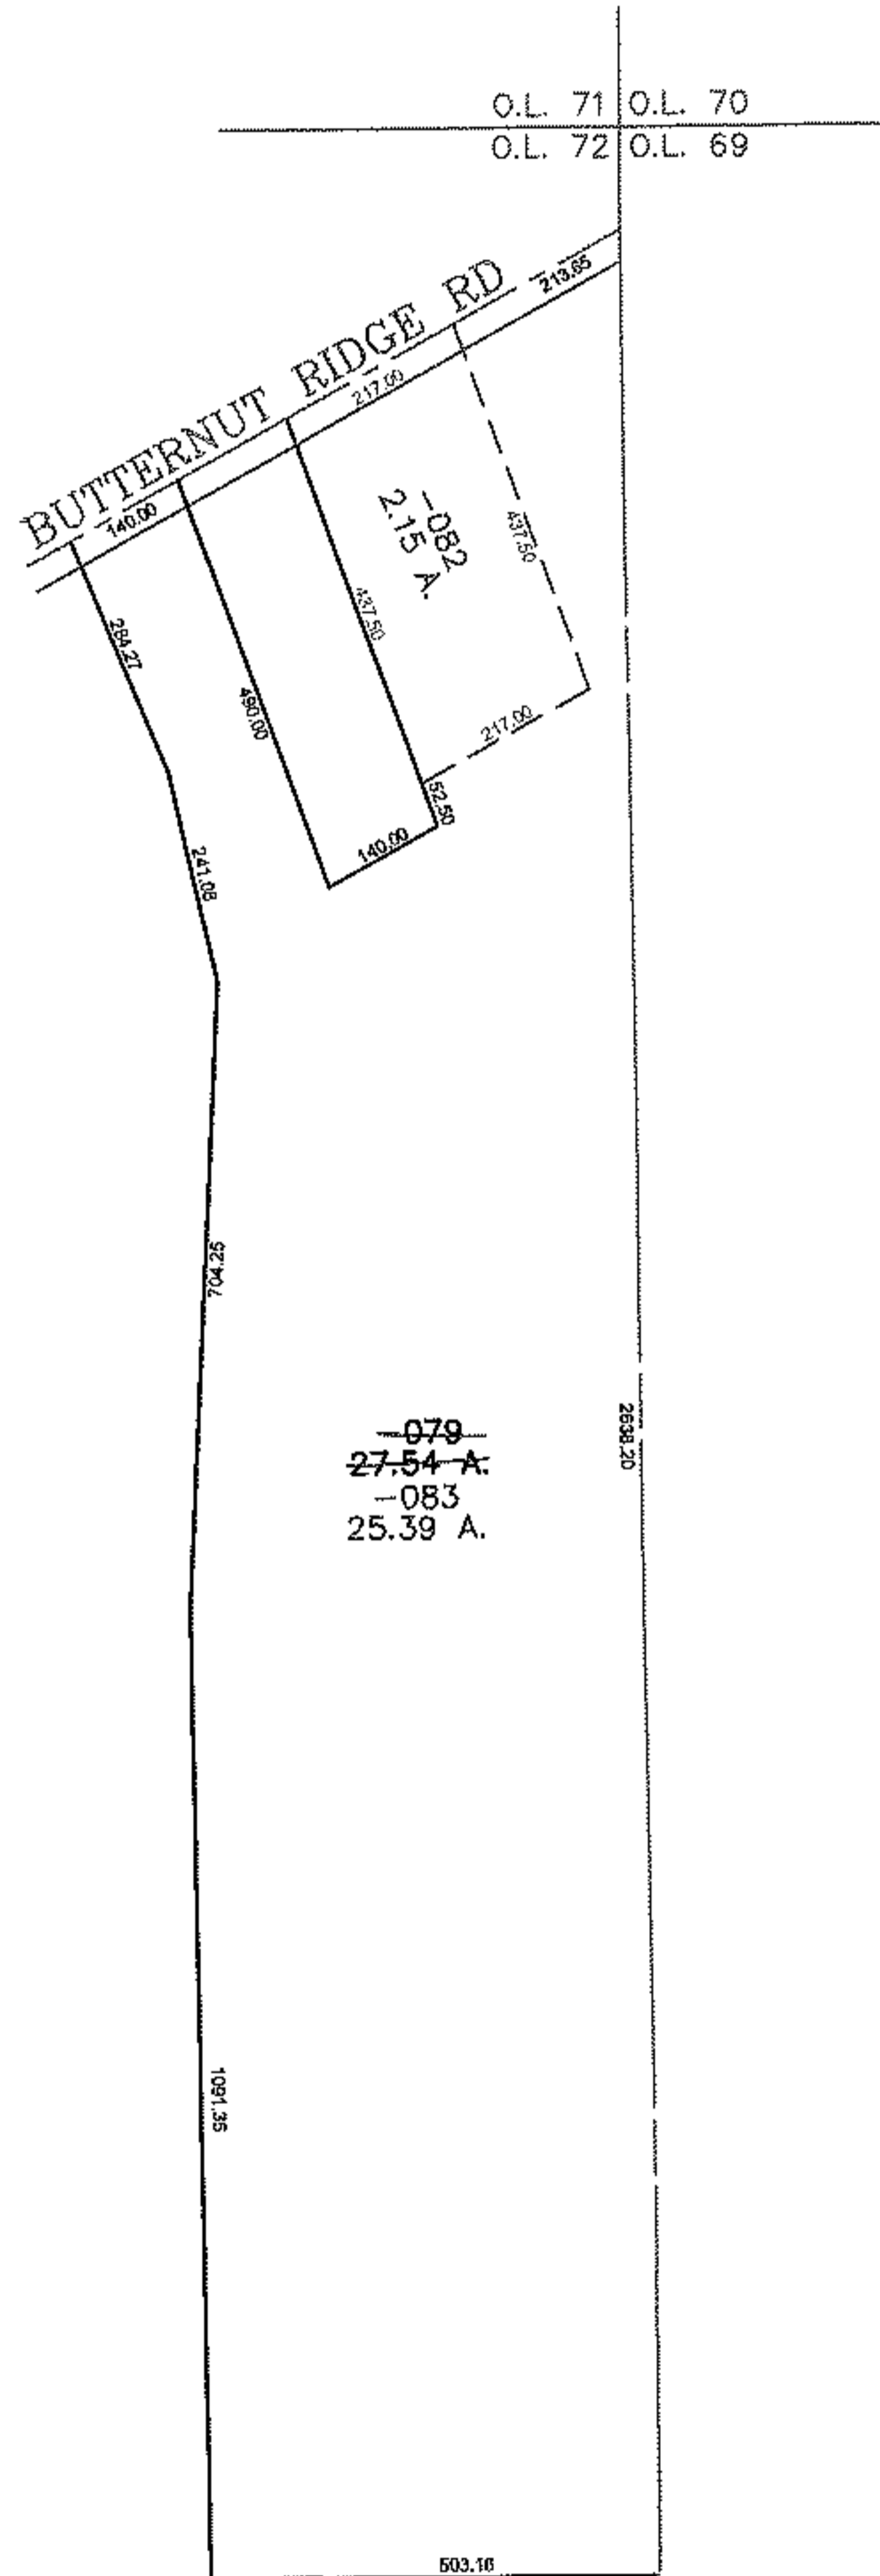


PARENT PARCEL: 11-00-072-000-079

CHILD PARCEL: 11-00-072-000-082, -083

STARTING POINT: CENTERLINE OF BUTTERNUT RIDGE RD & O.L. 72

13-03157

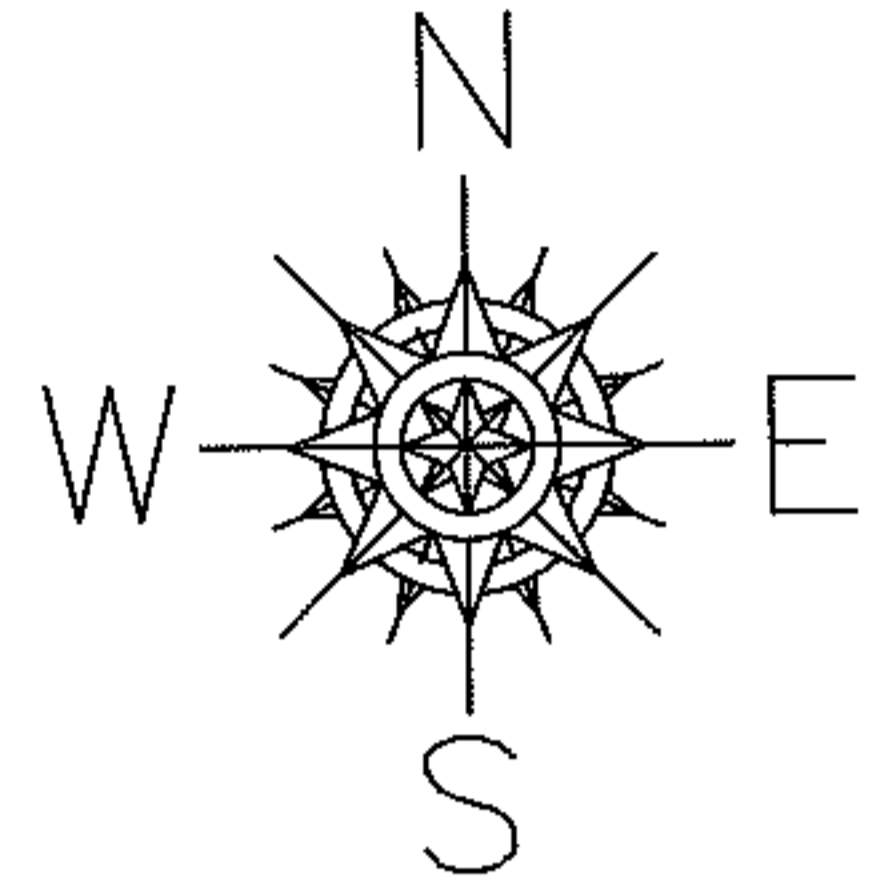

**SPLITS/DEEDS PROCESSED**

LORAIN COUNTY TAX MAP DEPARTMENT  
226 MIDDLE AVE. ELYRIA, OHIO

SURVEYED BY: AMY KELLY

CLOSURE: 0.00 : 10,000

MAP PAGE(S): 11-B

APPROVED BY: JAH DATE: 6-13-2013

SCALE: 1" = 400 PRIOR INST.: 20080267407