
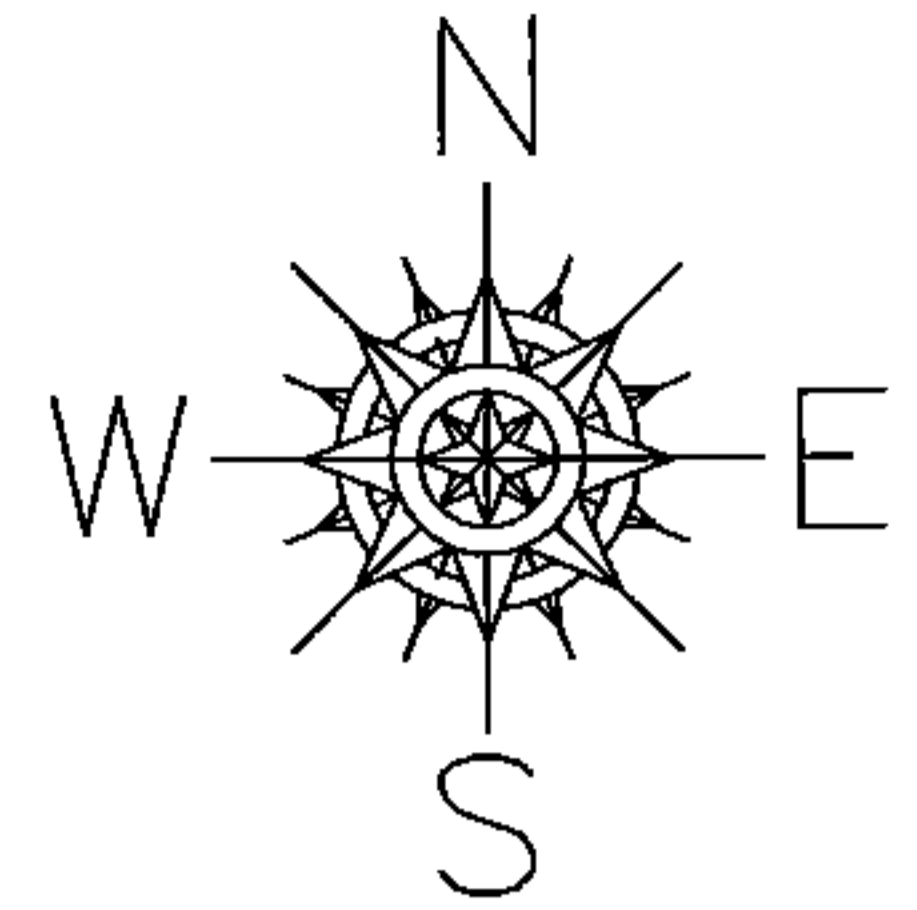


PARENT PARCEL: 05-00-060-105-019

CHILD PARCEL: 05-00-060-105-048, -049

STARTING POINT: INTERSECTION OF C/L OF NORTH RIDGE RD. AND C/L OF OBERLIN RD.

15-03158-U

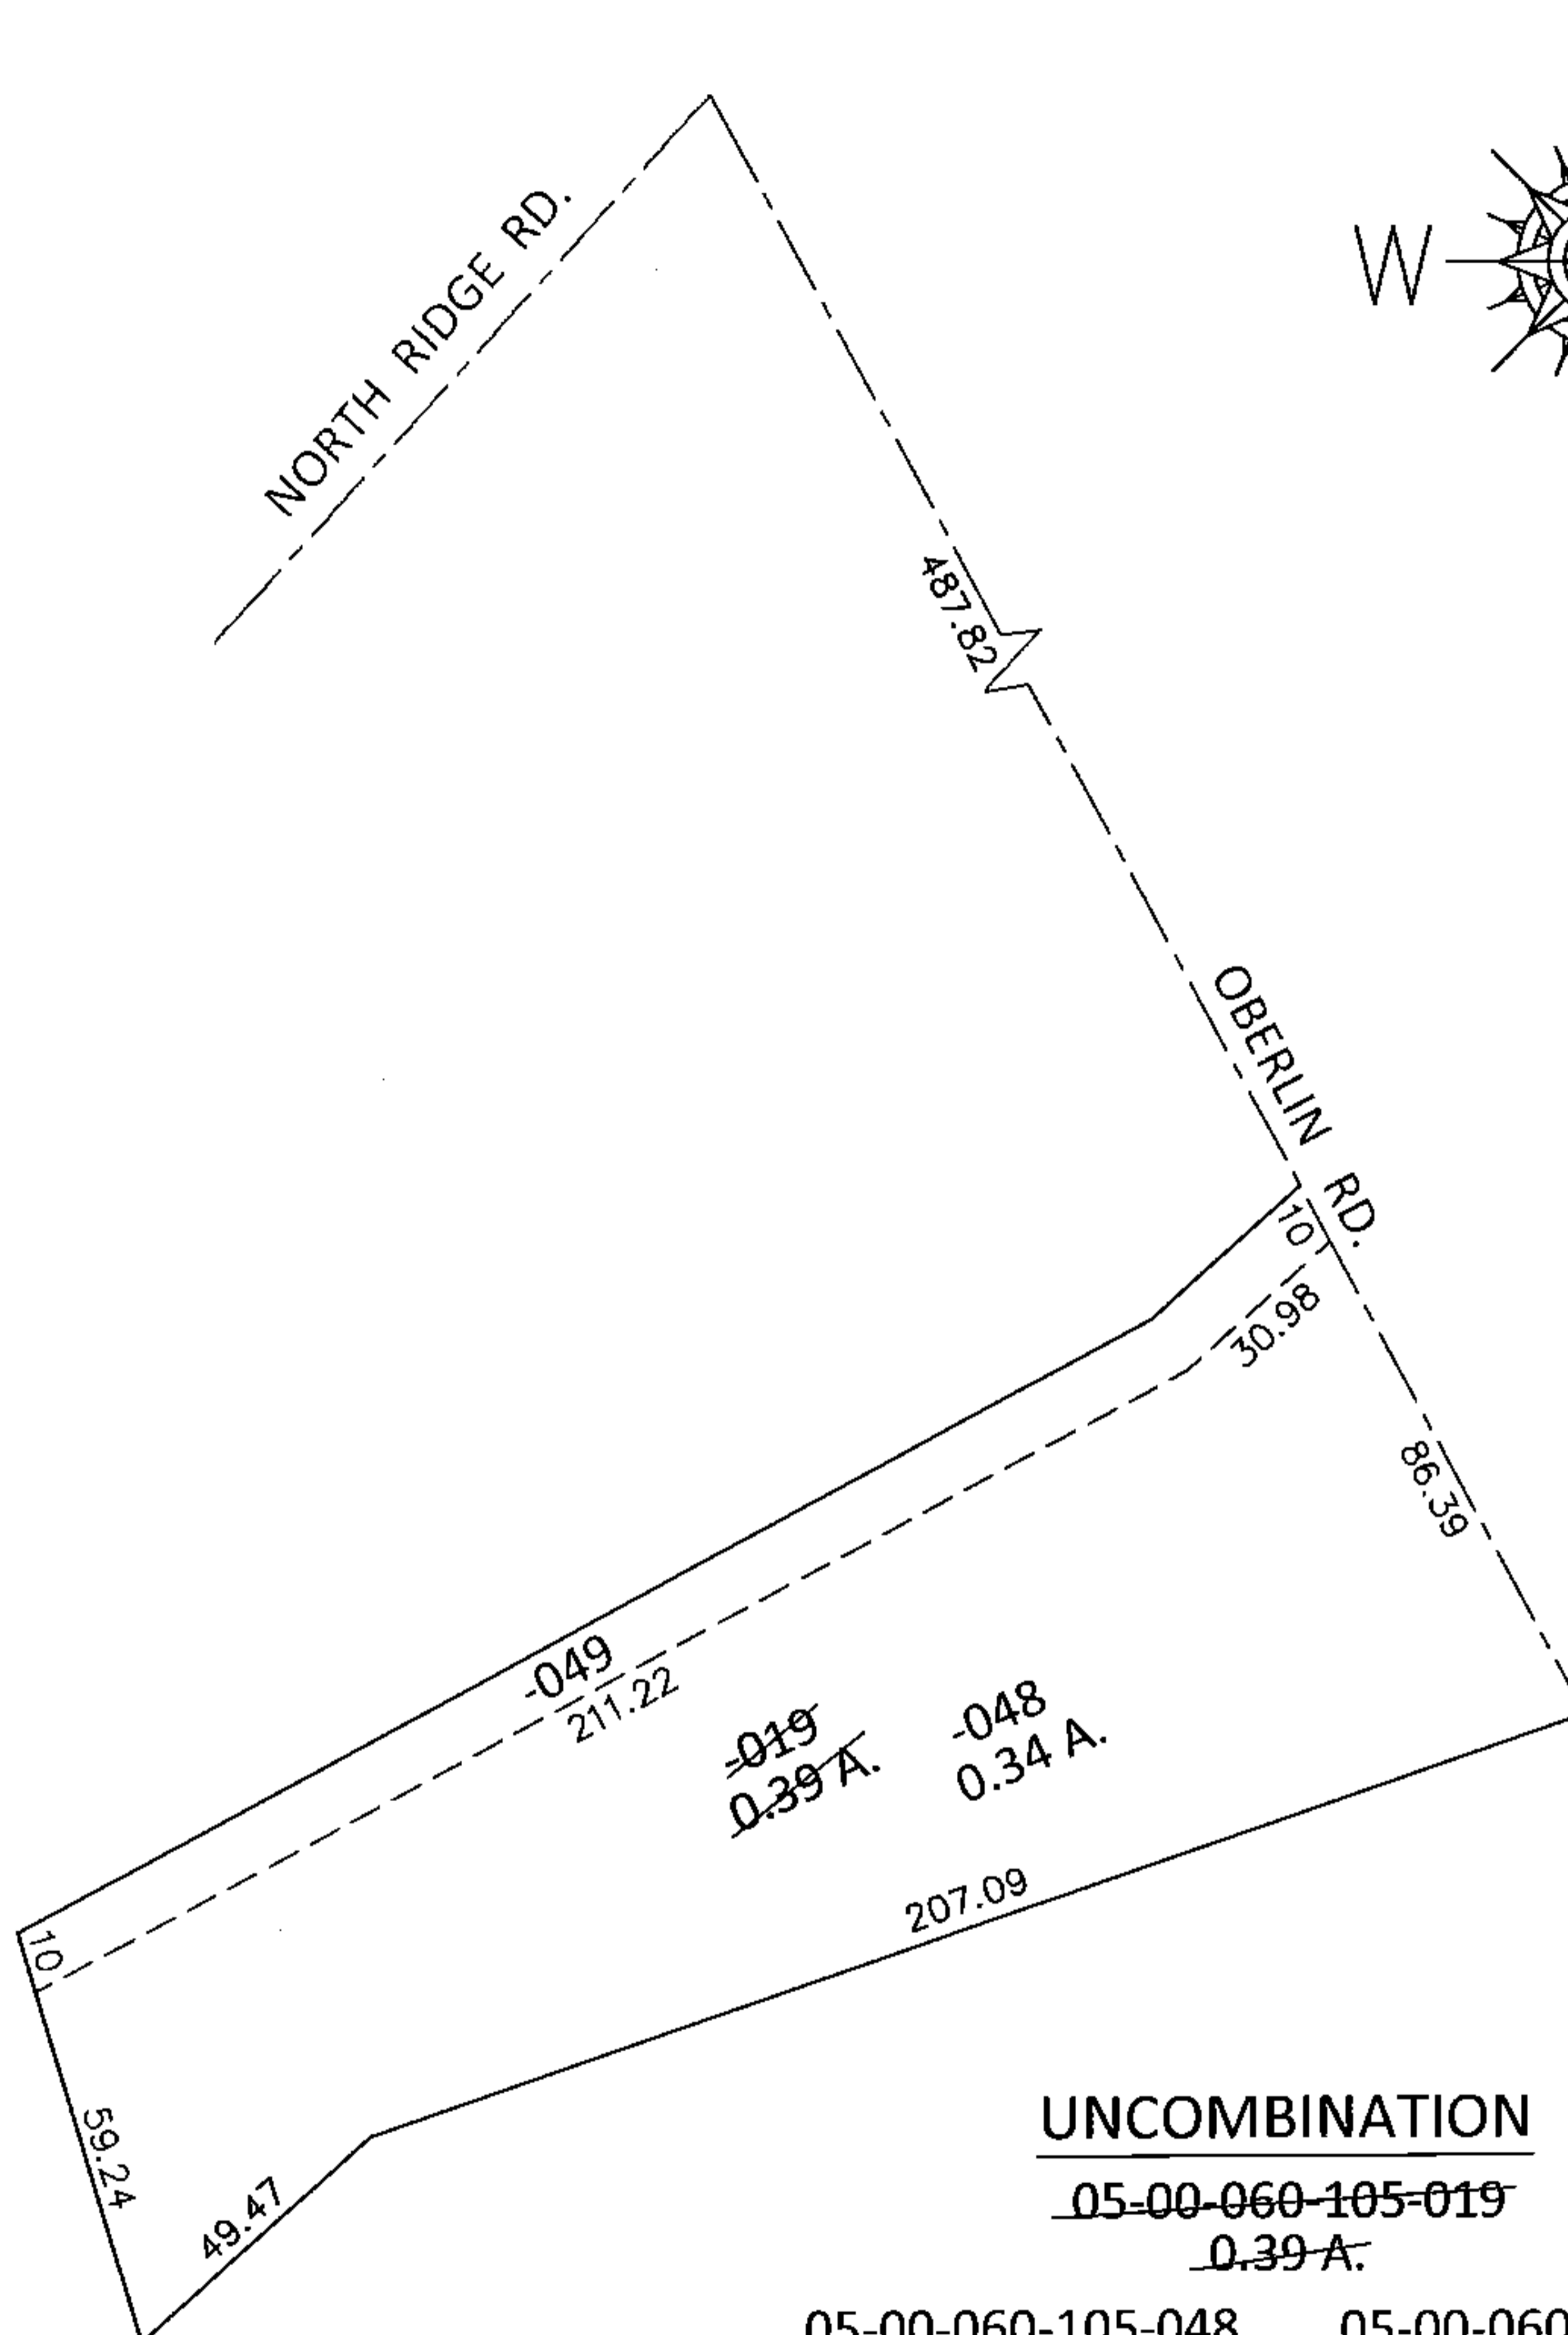


UNCOMBINATION

~~05-00-060-105-019~~
~~0.39 A.~~

05-00-060-105-048
0.34 A.

05-00-060-105-049
10 X 242.20

PER PRIOR DEEDS

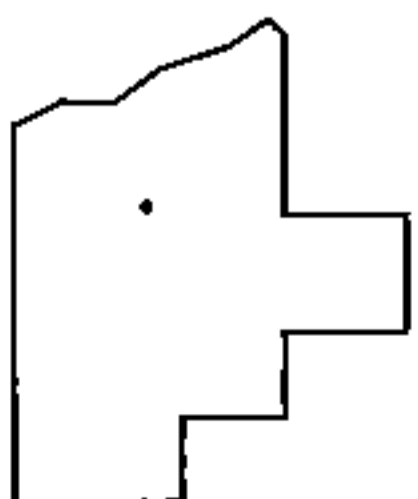

SPLITS/DEEDS PROCESSED

LORAIN COUNTY TAX MAP DEPARTMENT
226 MIDDLE AVE. ELYRIA, OHIO

SURVEYED BY: N/A

CLOSURE: N/A

MAP PAGE(S): 5-00-060-B

APPROVED BY: RRM DATE: 4-28-15

SCALE: 1" = 50' PRIOR INST.: 20110369590