
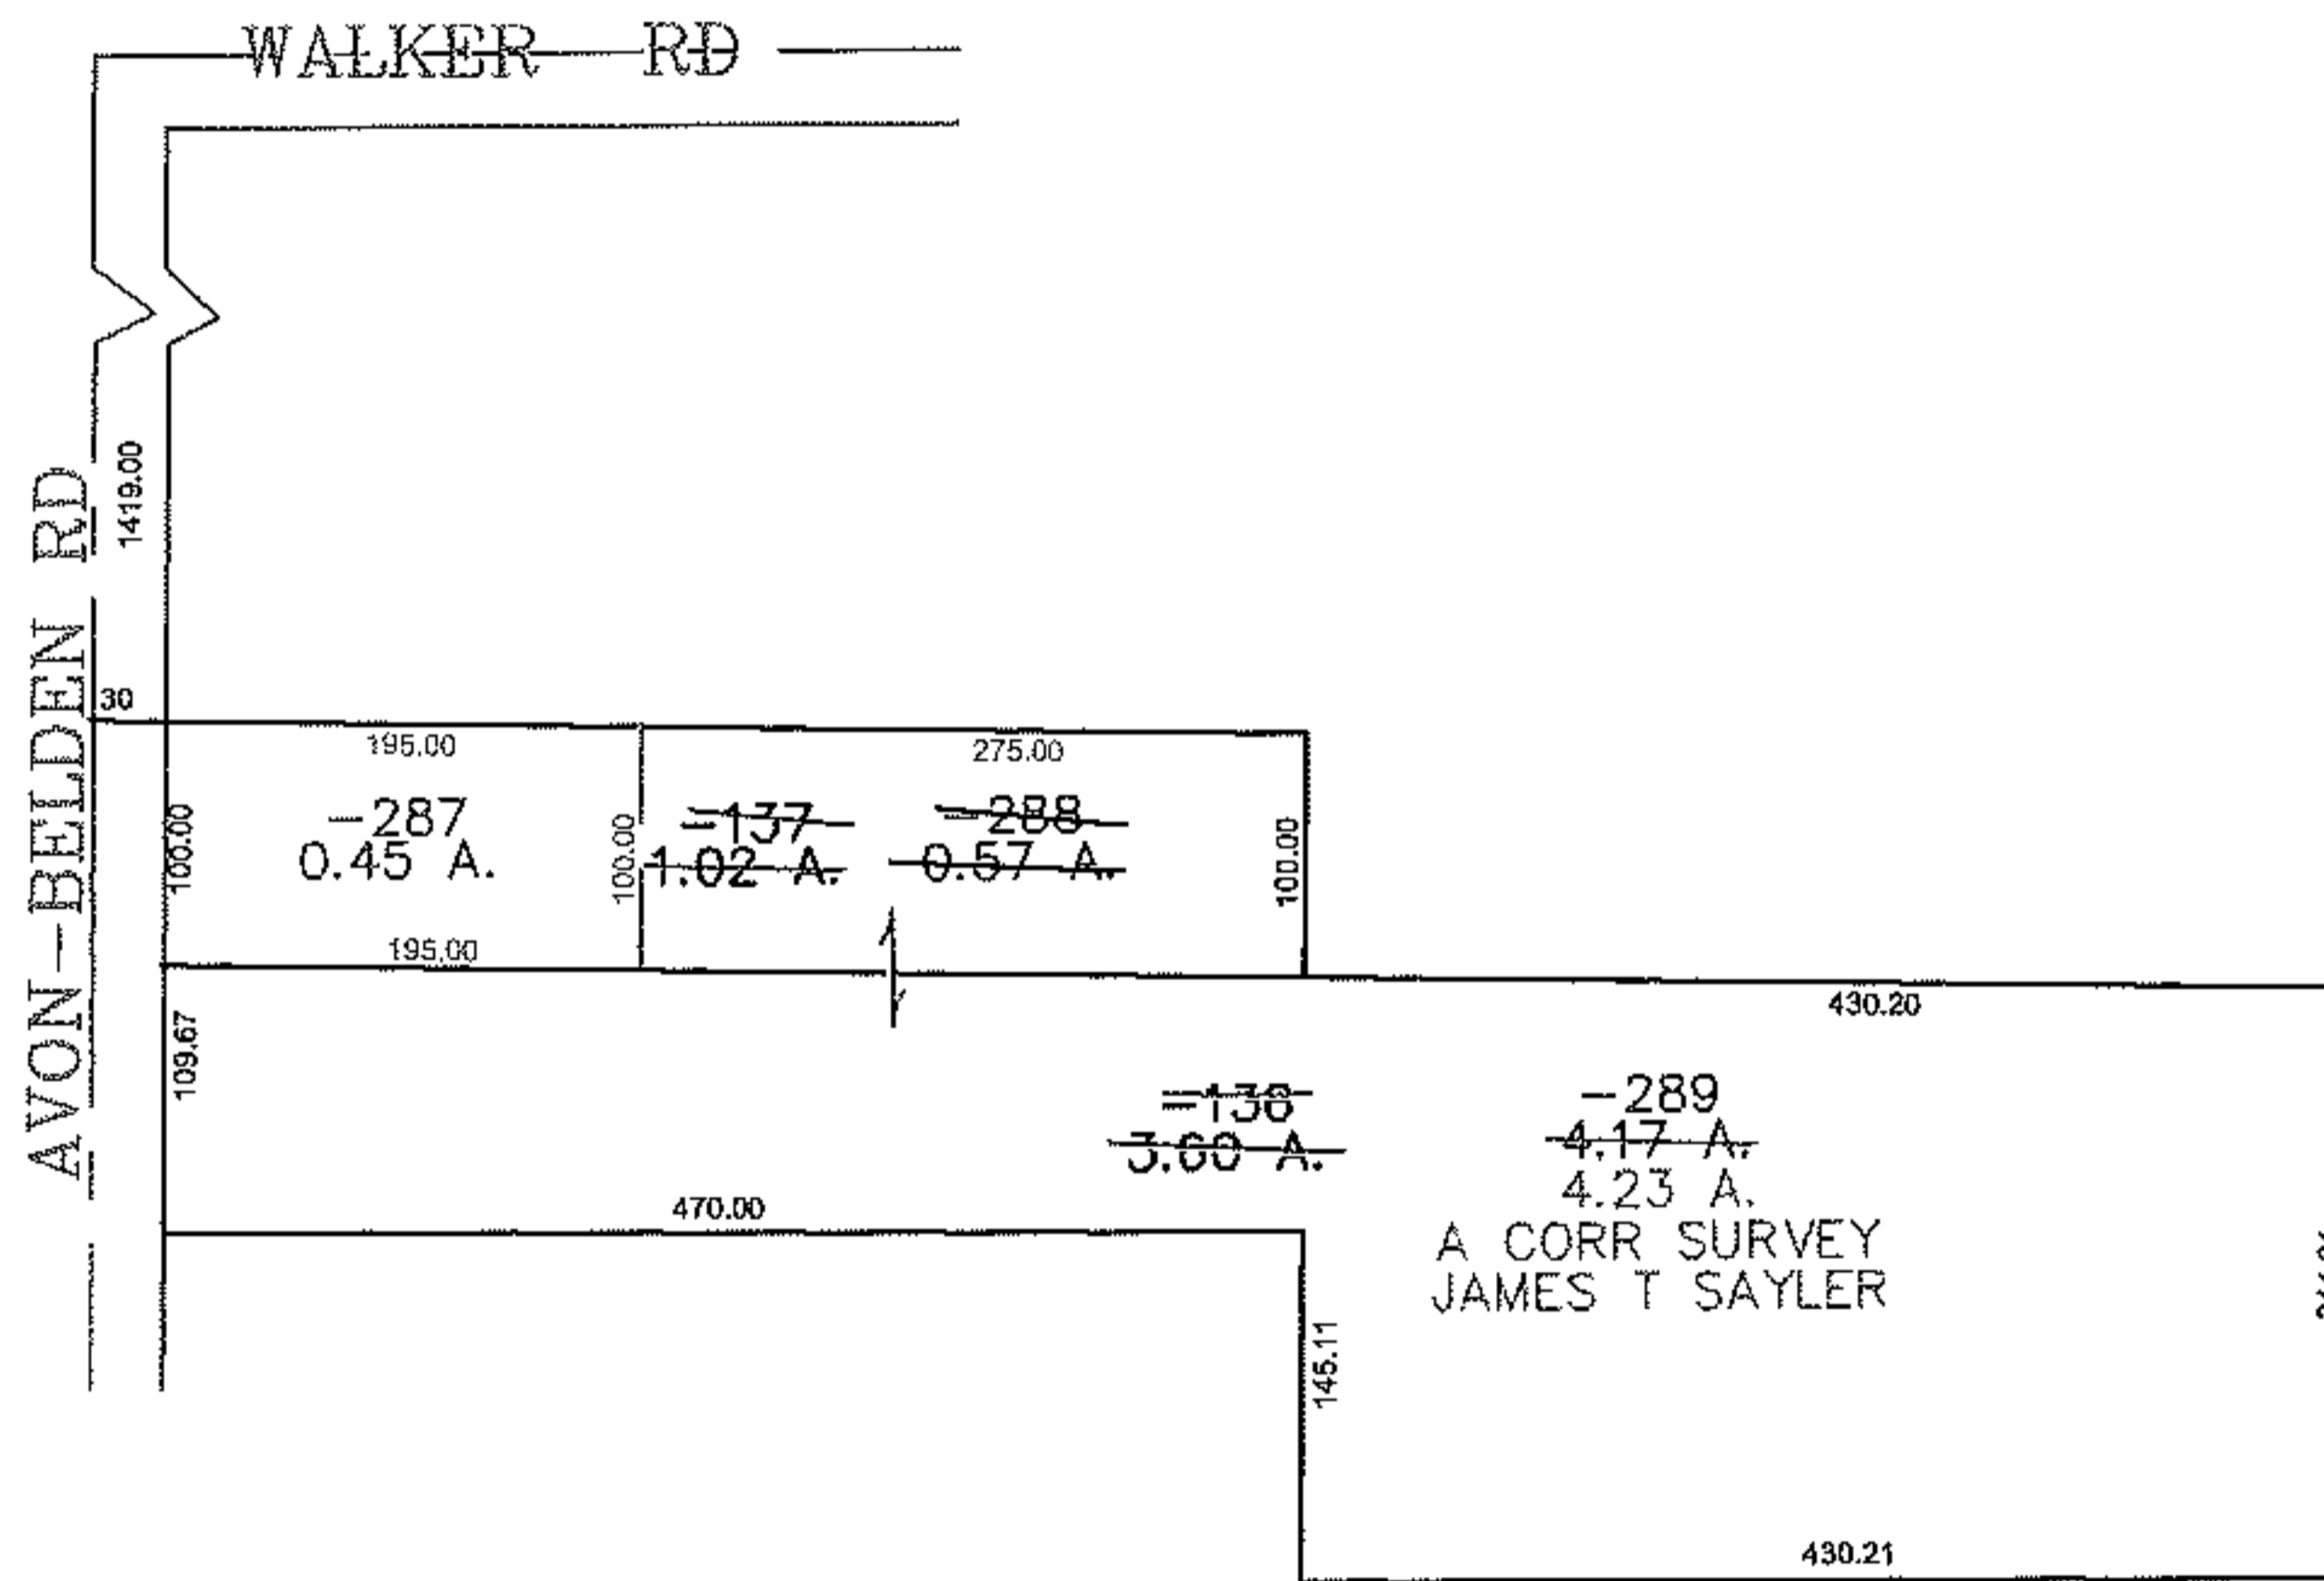


PARENT PARCEL: 04-00-017-103-137, -136
CHILD PARCEL: 04-00-017-103-287, -288, -289
STARTING POINT: CENTERLINE OF AVON-BELDEN RD & WALKER RD

13-03158

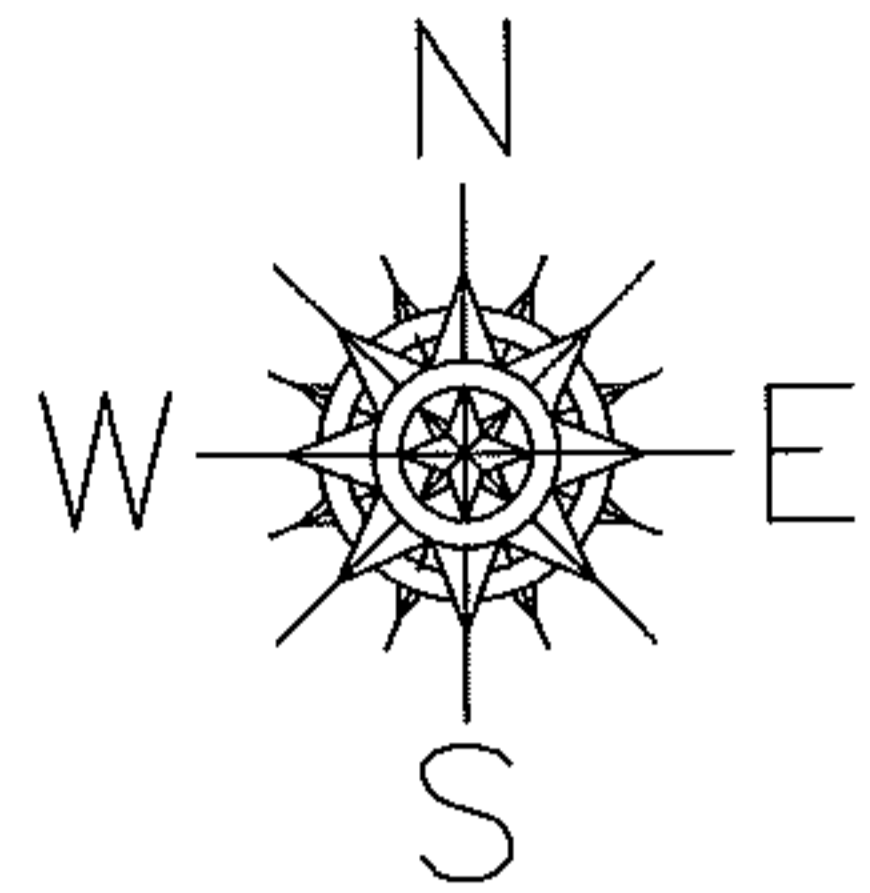

SPLITS/DEEDS PROCESSED
LORAIN COUNTY TAX MAP DEPARTMENT
226 MIDDLE AVE. ELYRIA, OHIO

SURVEYED BY: JAMES T SAYLER
CLOSURE: 0.00 : 10.000
MAP PAGE(S): 04-00-017-C
APPROVED BY: JAH DATE: 6/14/2013
SCALE: 1" = 200' PRIOR INSTRUMENT: OR 1121/664