


PARENT PARCEL: 05-00-012-101-005, -006

CHILD PARCEL: 05-00-012-101-053


STARTING POINT: CENTERLINE OF PYLE-SOUTH AMHERST RD & SOUTHWEST CORNER OF S/L 4

13-03159

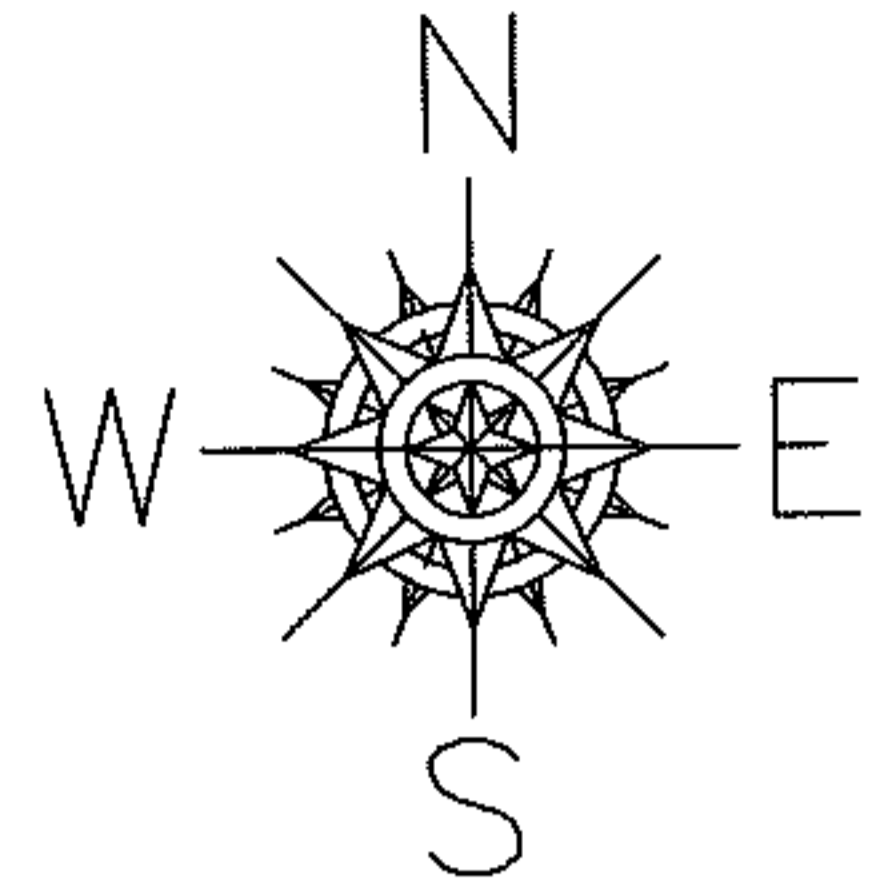

MAROY ALLOTMENT NO 1
VOL 15 PG 70

4 -002

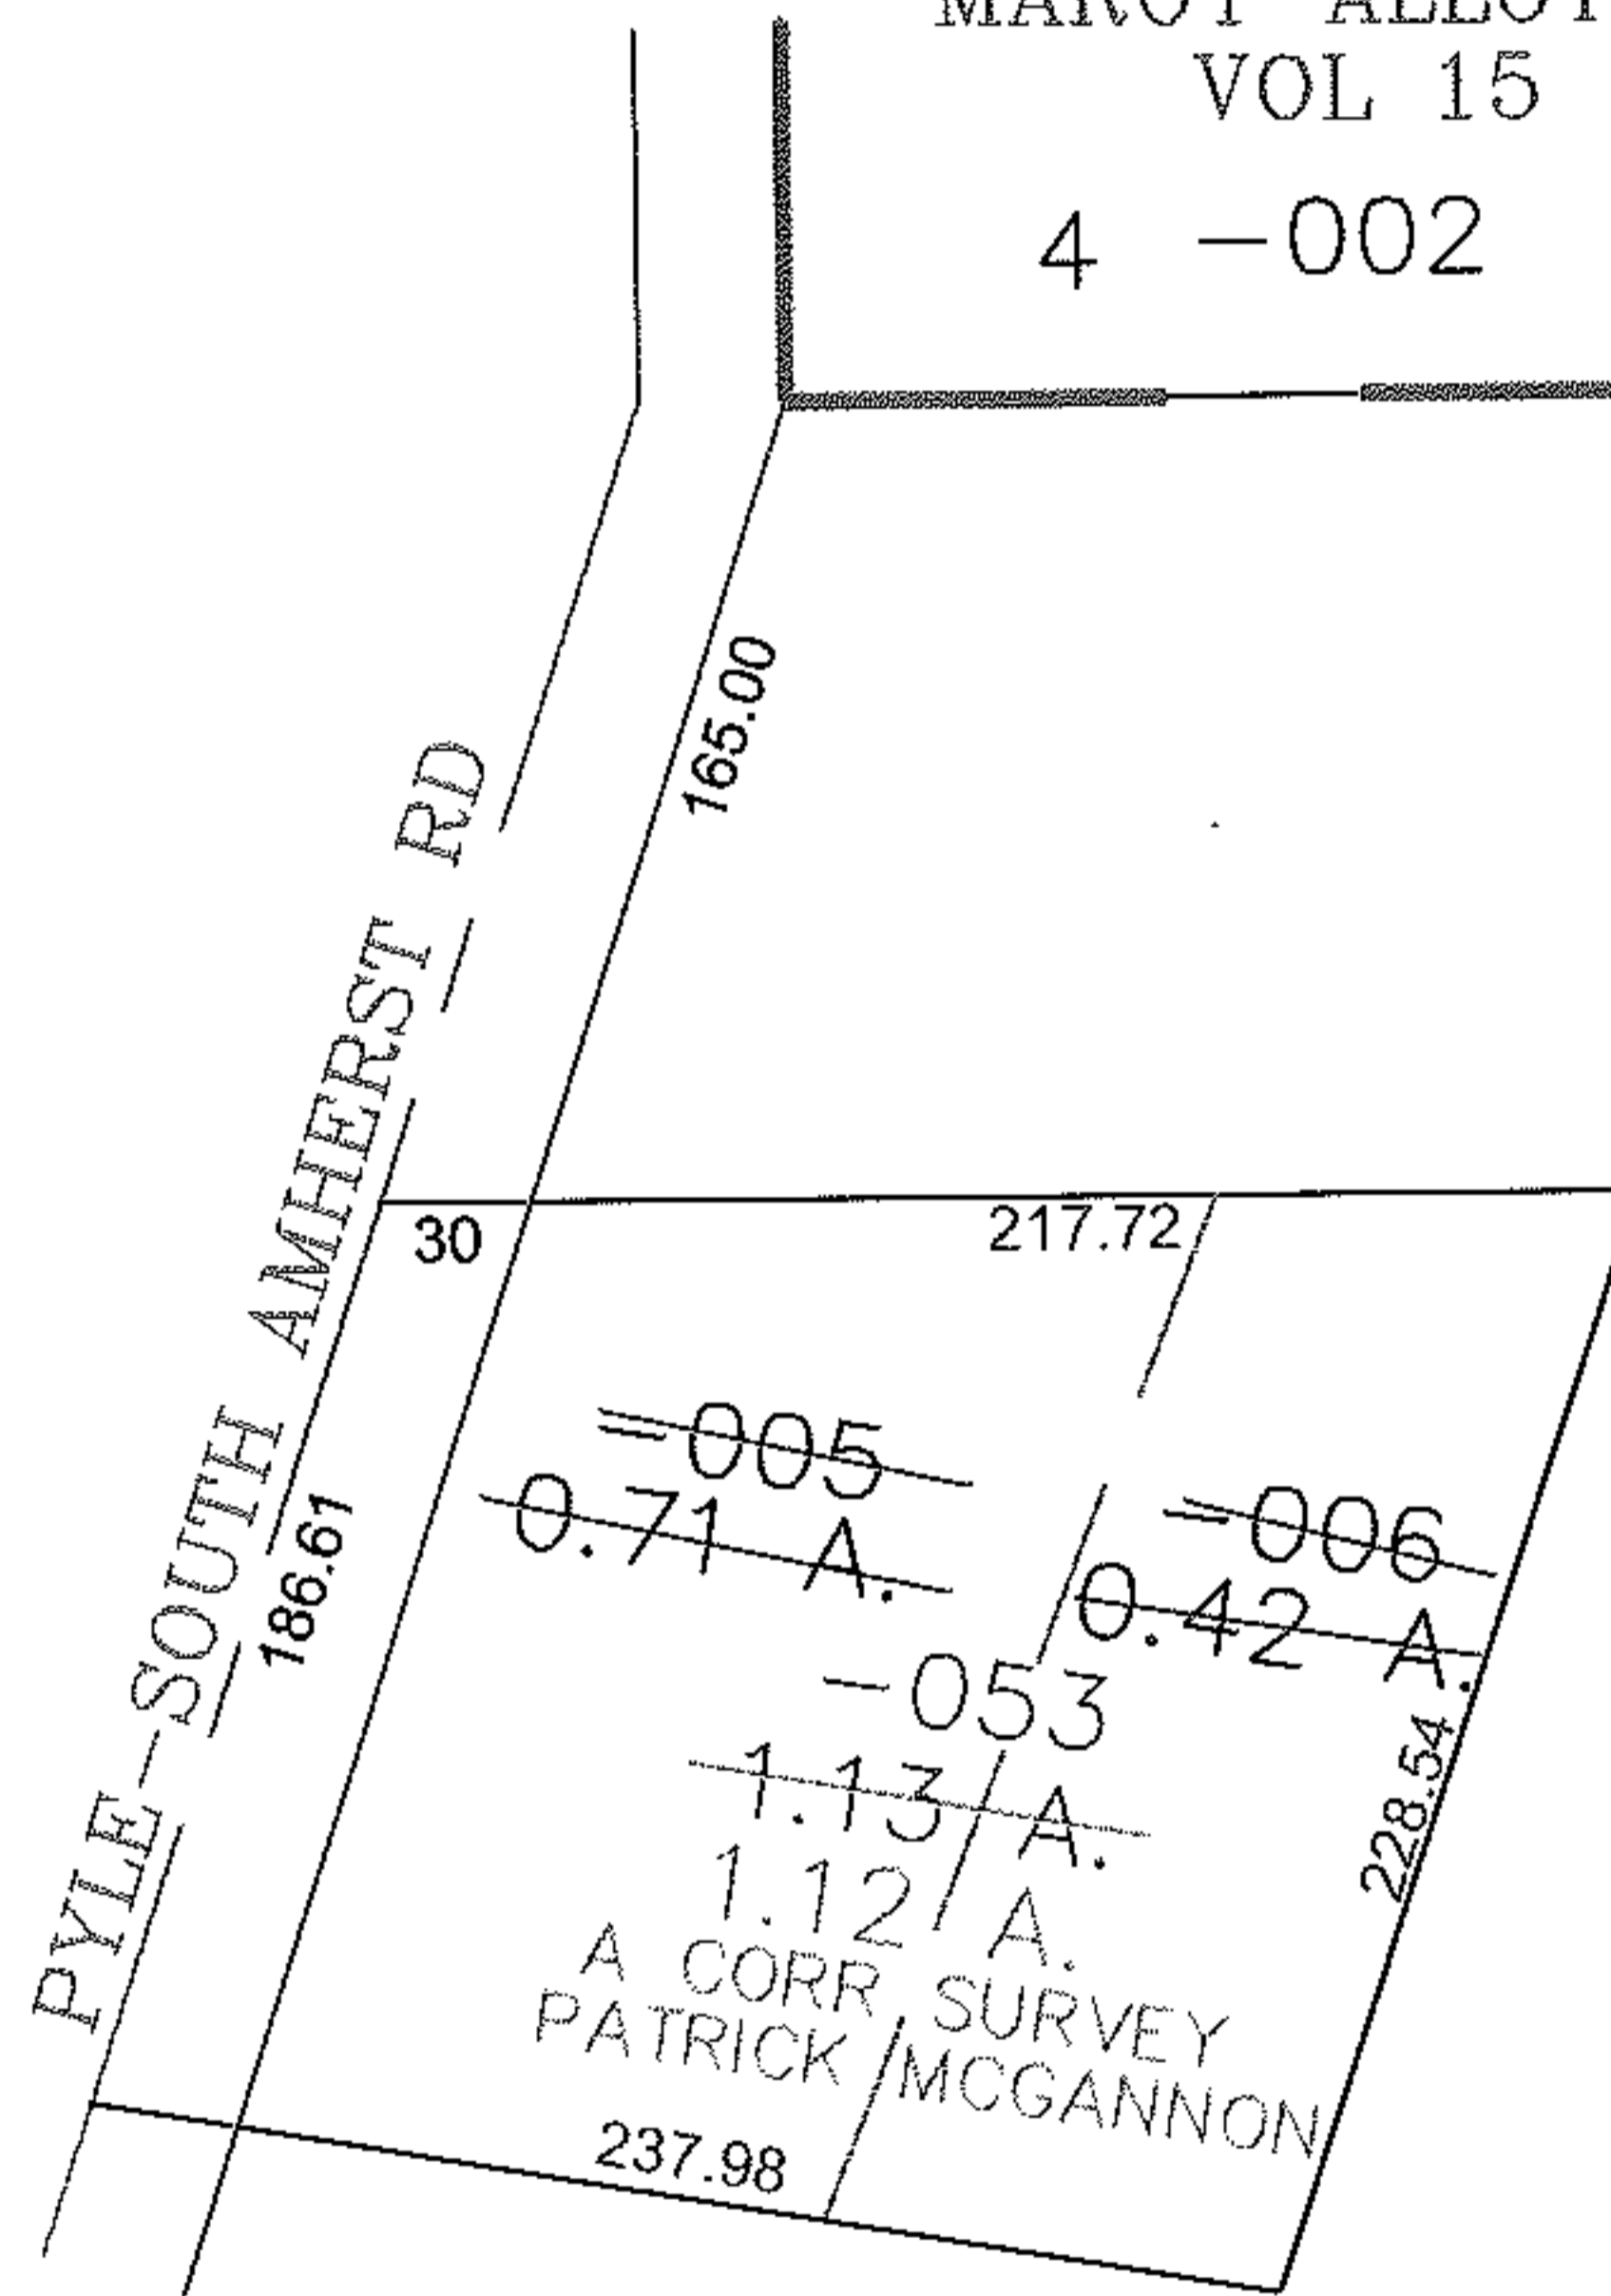

SPLITS/DEEDS PROCESSED

LORAIN COUNTY TAX MAP DEPARTMENT
226 MIDDLE AVE. ELYRIA, OHIO

SURVEYED BY: PATRICK MCGANNON

CLOSURE: 0.00 : 10.000

MAP PAGE(S): 05-00-012-A

APPROVED BY: JAH DATE: 6/27/2013

SCALE: 1" = 100 PRIOR INSTRUMENT: 20080237114