
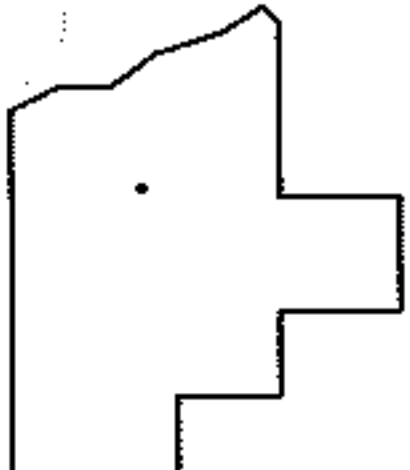
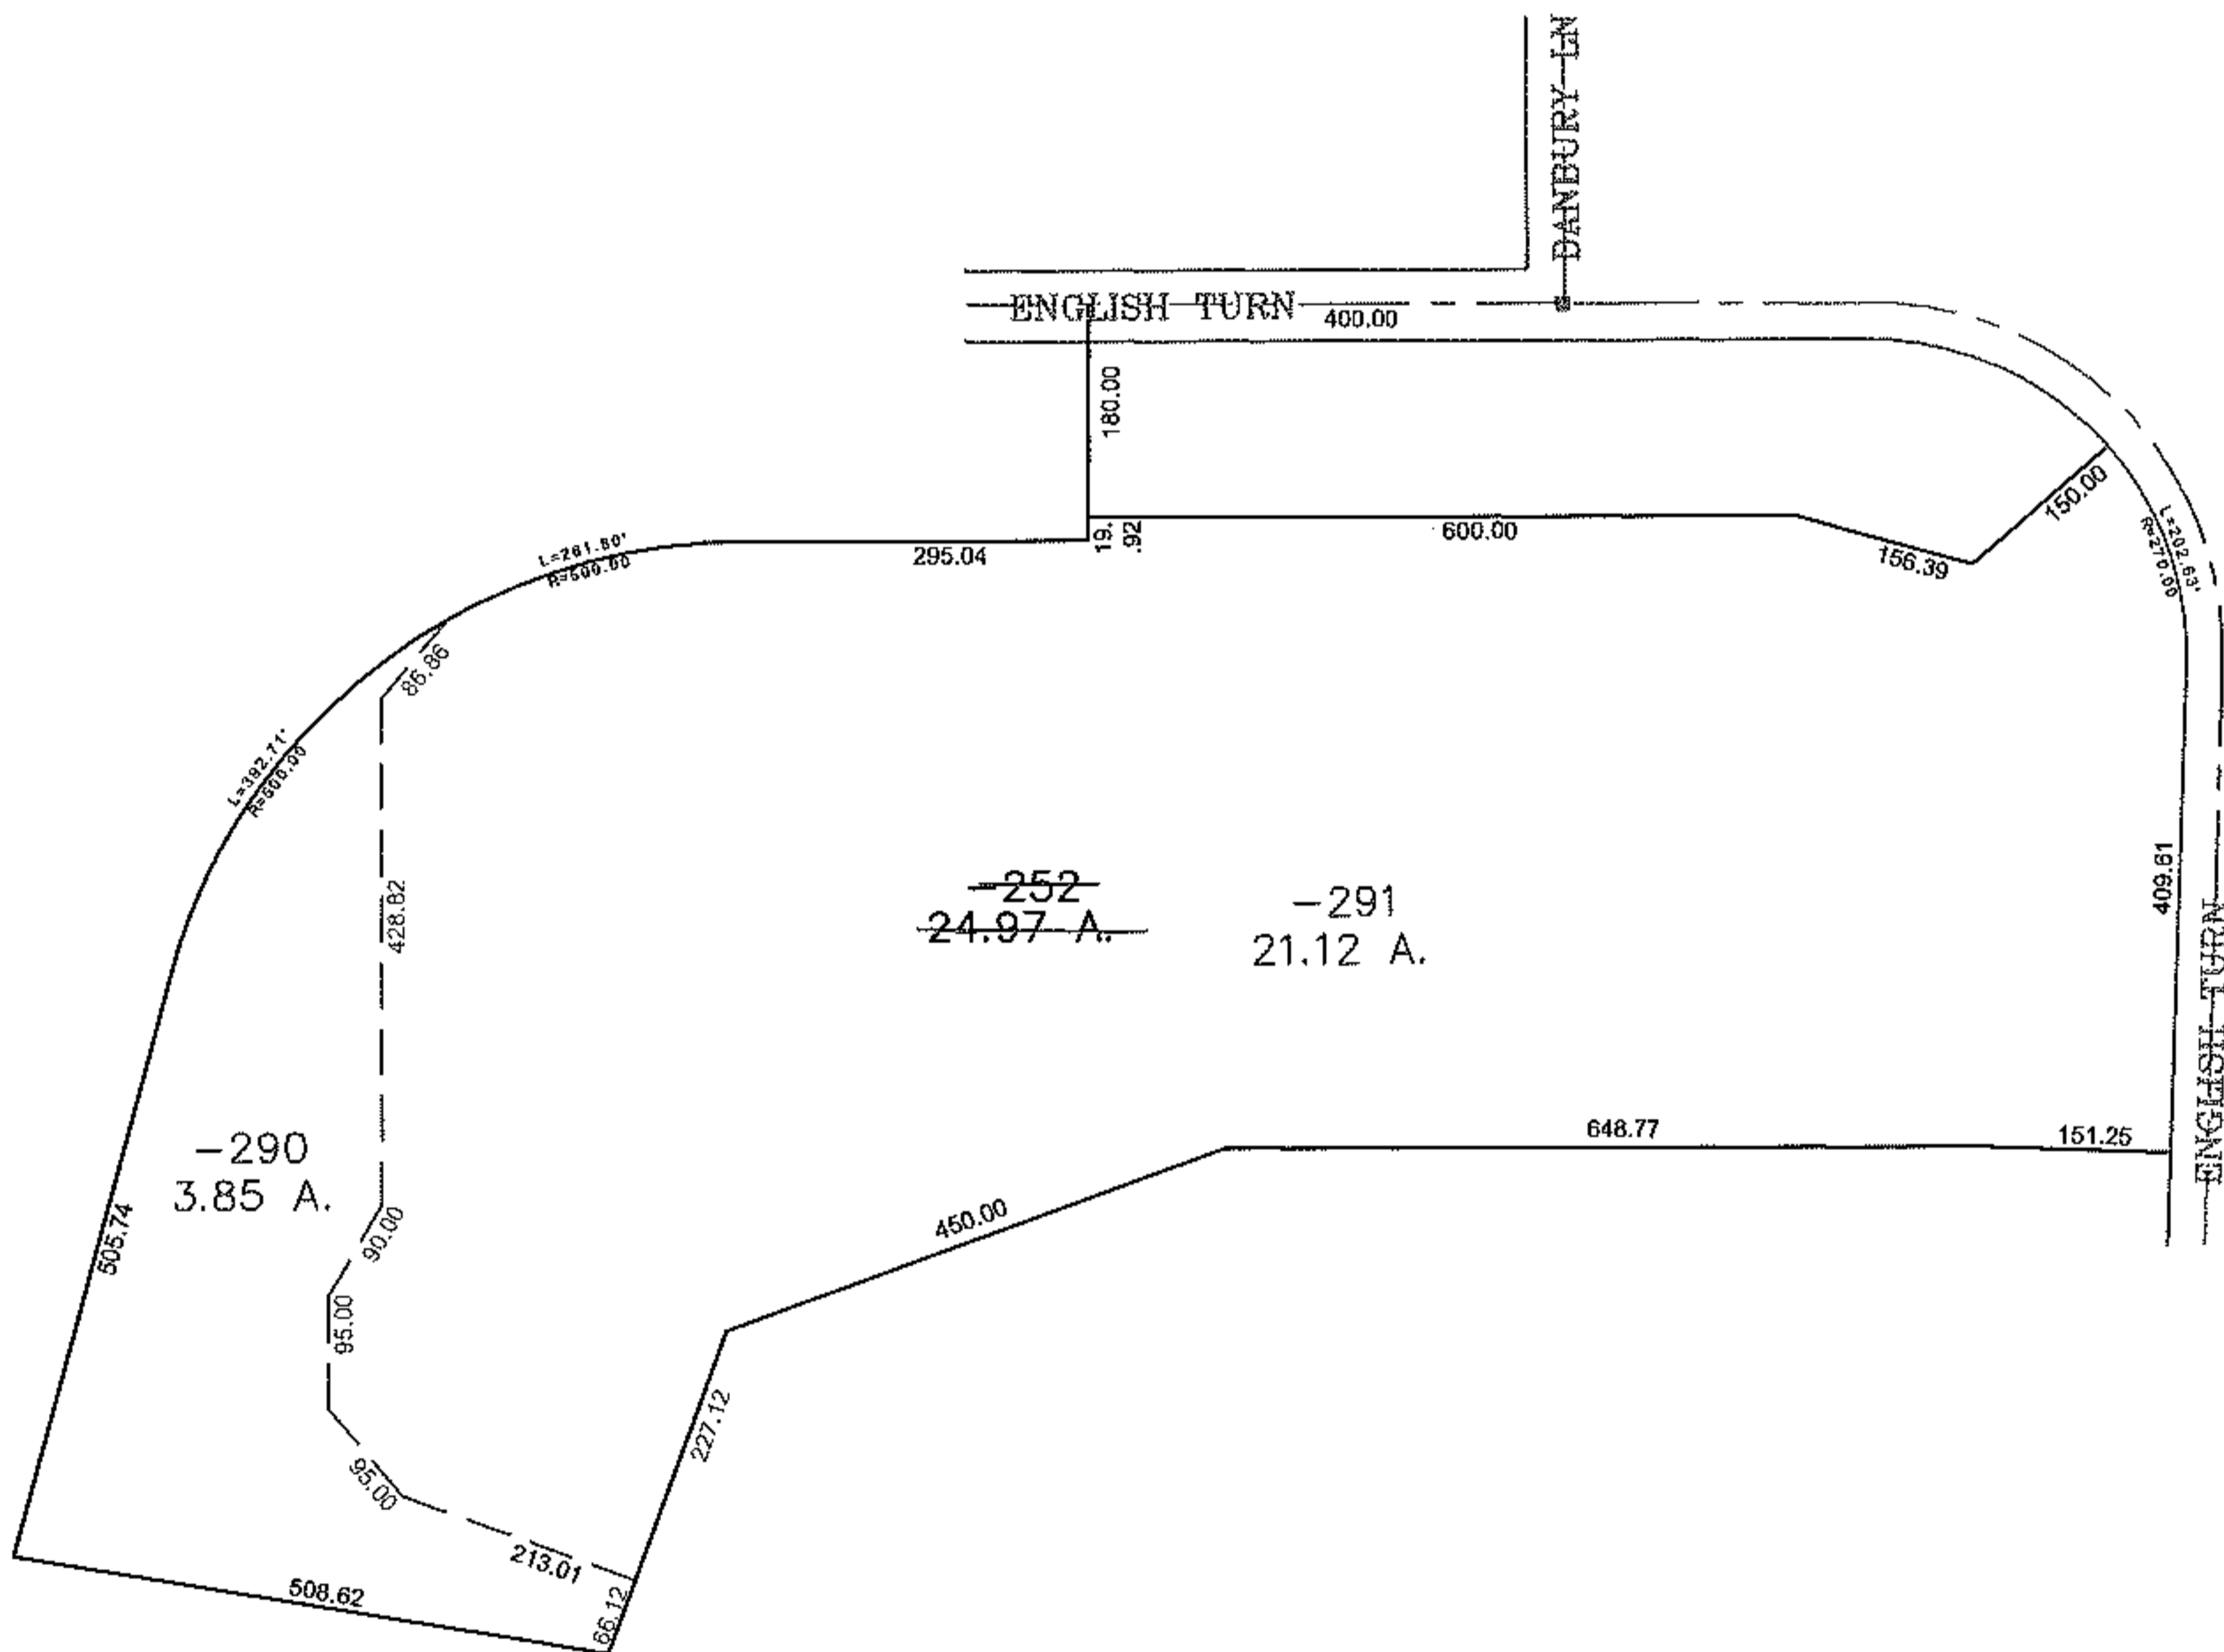


PARENT PARCEL: 04-00-017-103-252

CHILD PARCEL: 04-00-017-103-290, -291

STARTING POINT: CENTERLINE OF DANBURY LN & ENGLISH TURN

13-03160

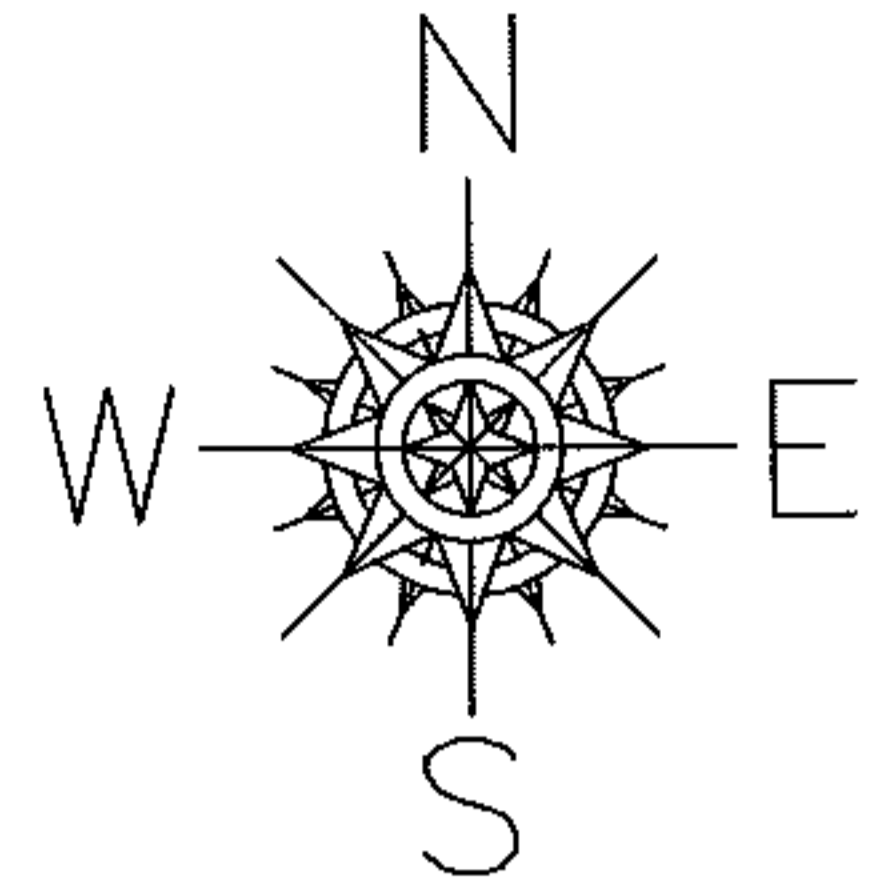

SPLITS/DEEDS PROCESSED
LORAIN COUNTY TAX MAP DEPARTMENT
226 MIDDLE AVE. ELYRIA, OHIO

SURVEYED BY: JAMES T SAYLER
CLOSURE: 0.00 : 10.000
MAP PAGE(S): 04-00-017-D
APPROVED BY: JAH DATE: 6-26-2013
SCALE: 1" = 300 PRIOR INSTRUMENT: PLVOL 92/27