


PARENT PARCEL: ADD TO DUPLICATE

CHILD PARCEL: 04-00-008-101-700-004

STARTING POINT: COMMON AREA

15-03161-A

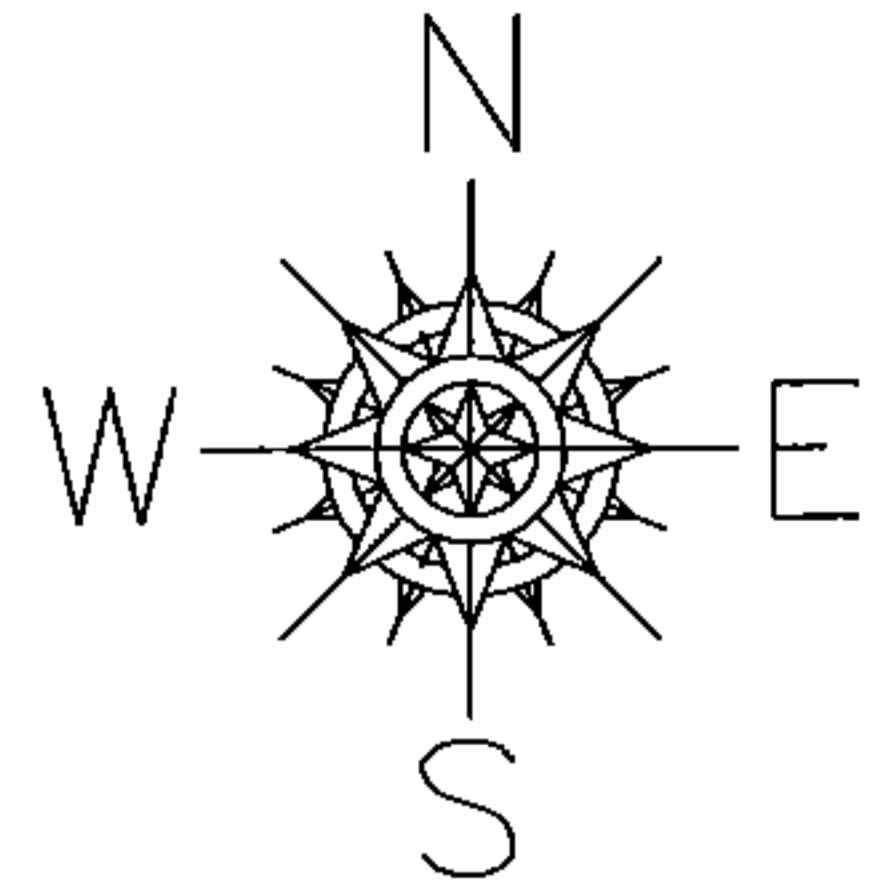



ADD TO DUPLICATE

04-00-008-700-004

1.85 A.

PER PLAT VOL. 88 PG. 30

WALKER RD. 86'

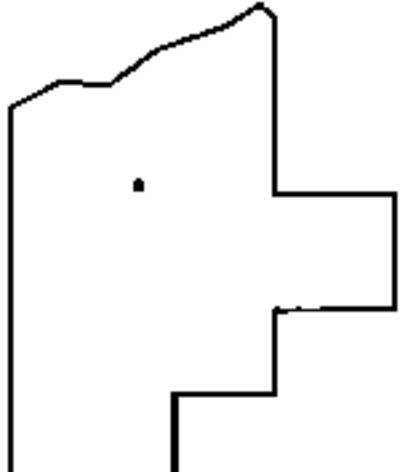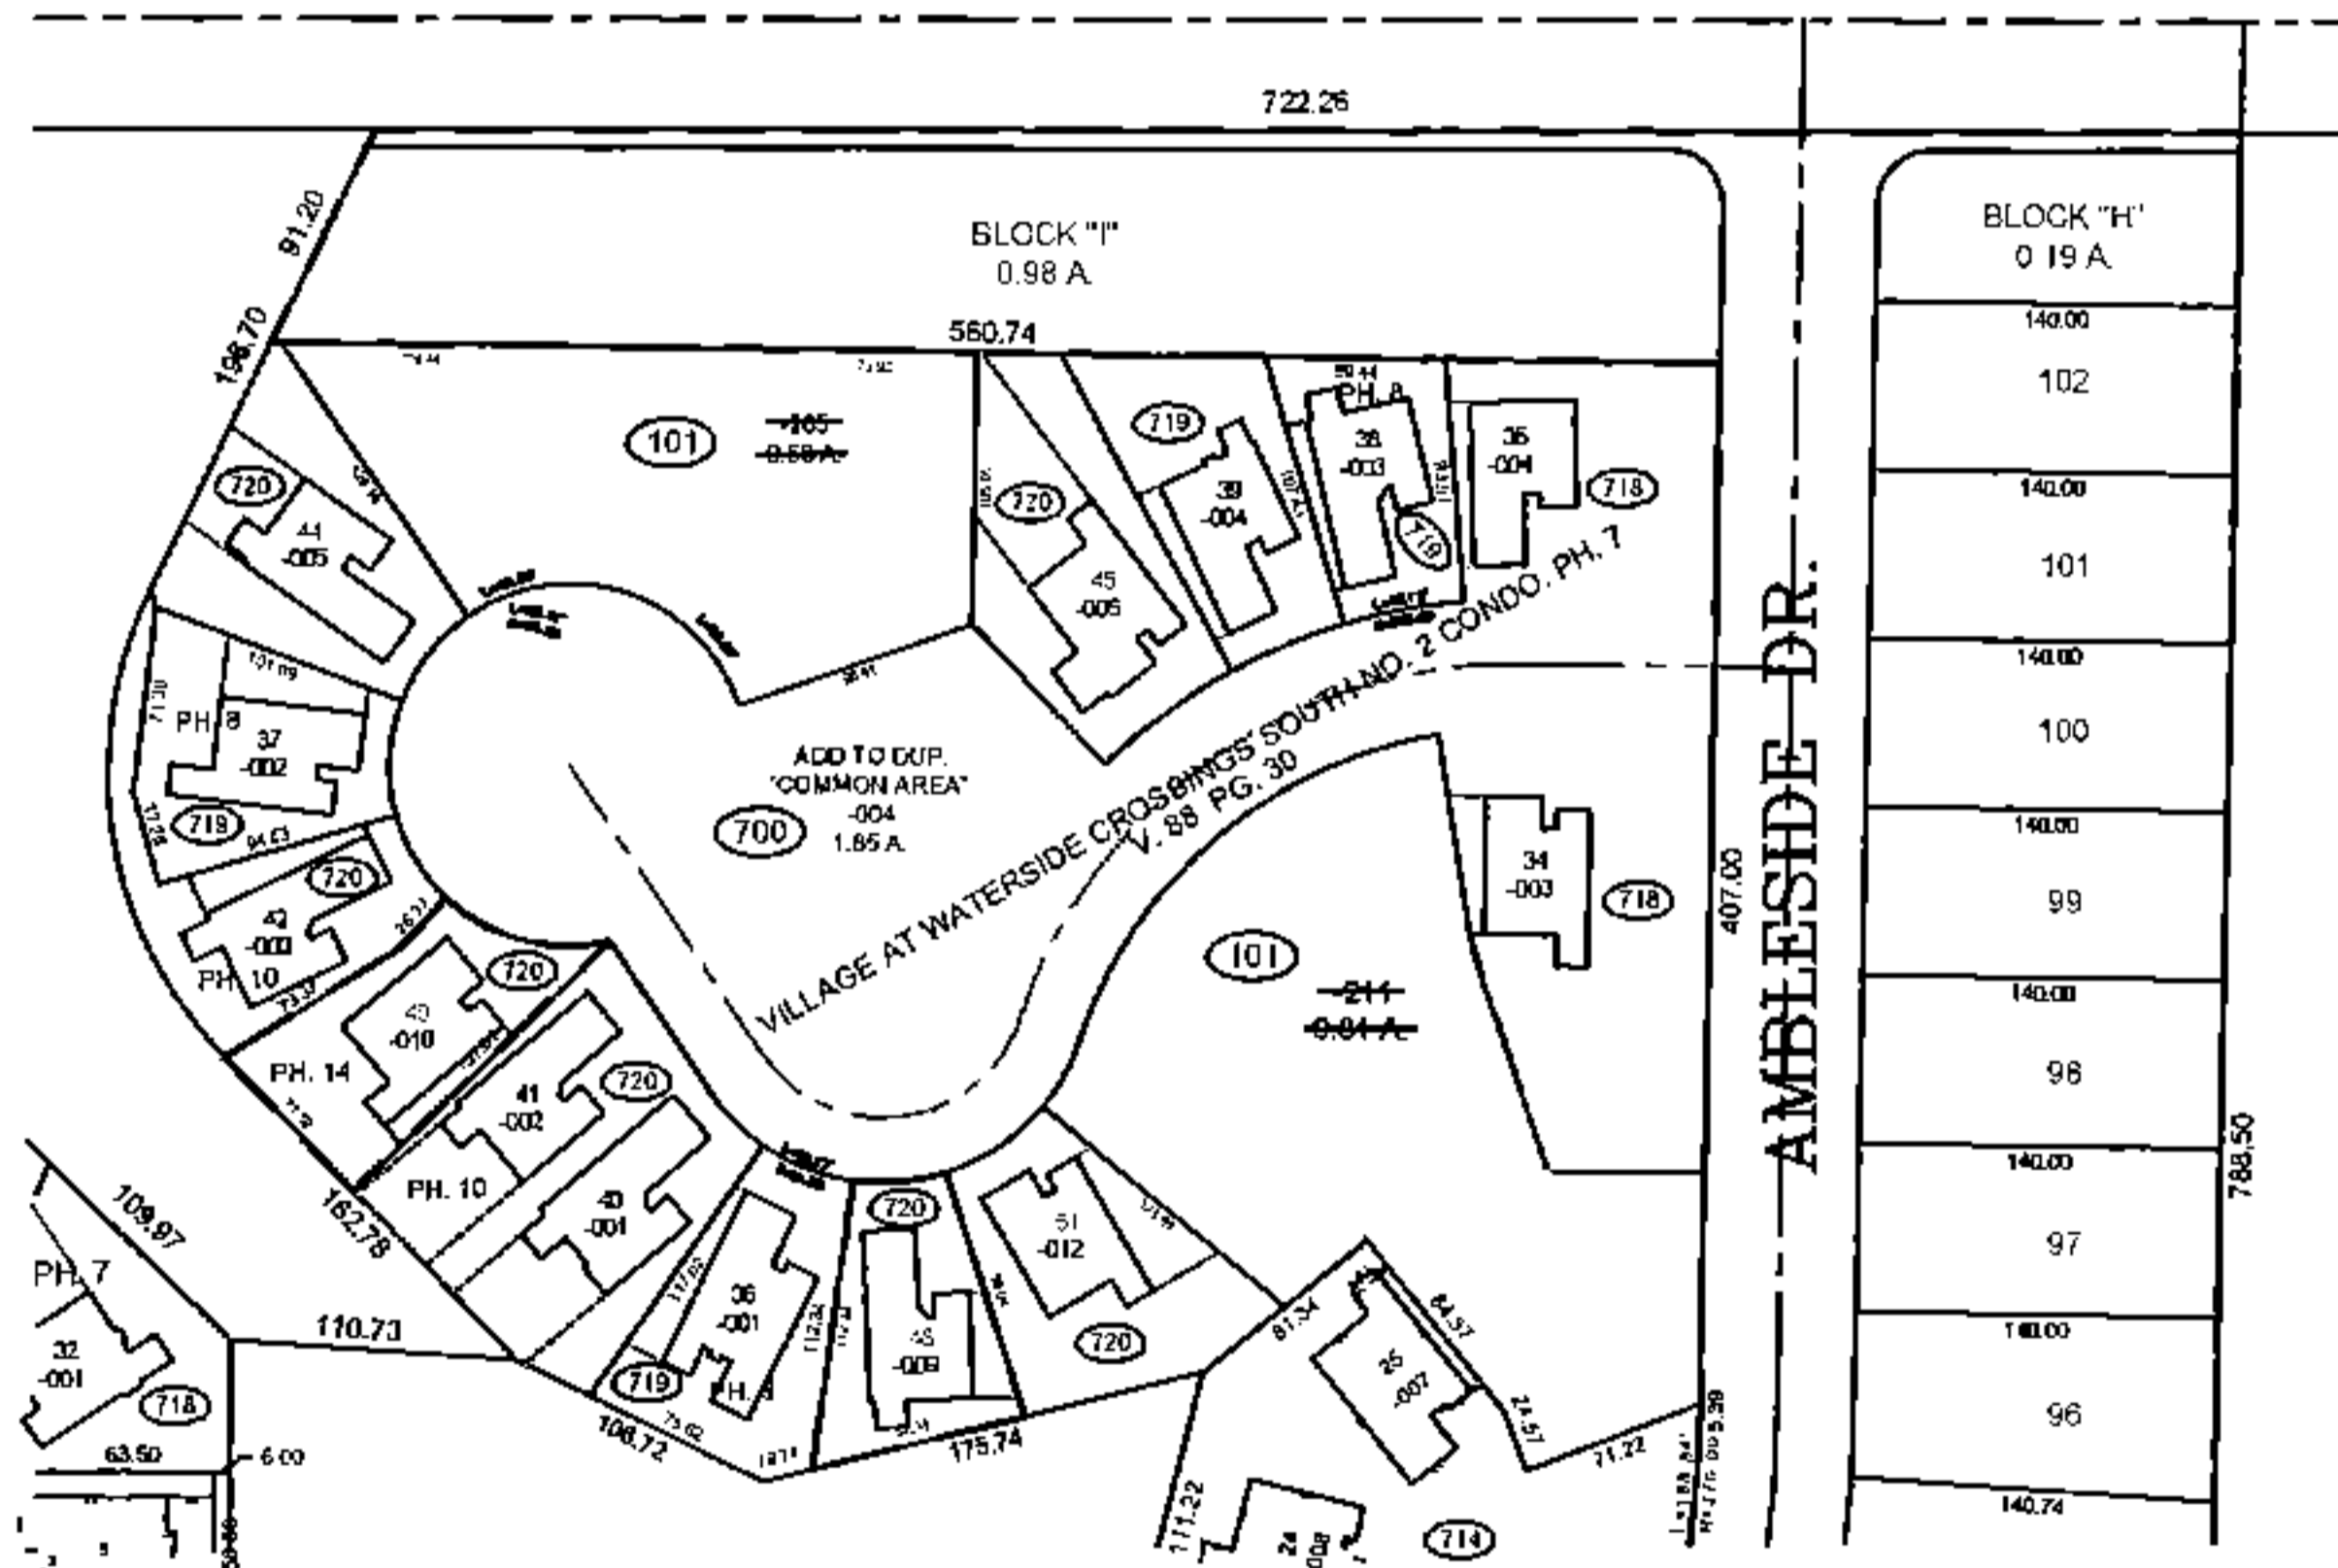

SPLITS/DEEDS PROCESSED
LORAIN COUNTY TAX MAP DEPARTMENT
226 MIDDLE AVE. ELYRIA, OHIO

SURVEYED BY: JAMES SAYLER
CLOSURE: 0.00 : 10,000
MAP PAGE(S): 04-00-008
APPROVED BY: TJS DATE: 5/1/15
SCALE: 1" = 200 PRIOR INSTRUMENT: DV XXXX/XXX

TRANS 5/1/15