
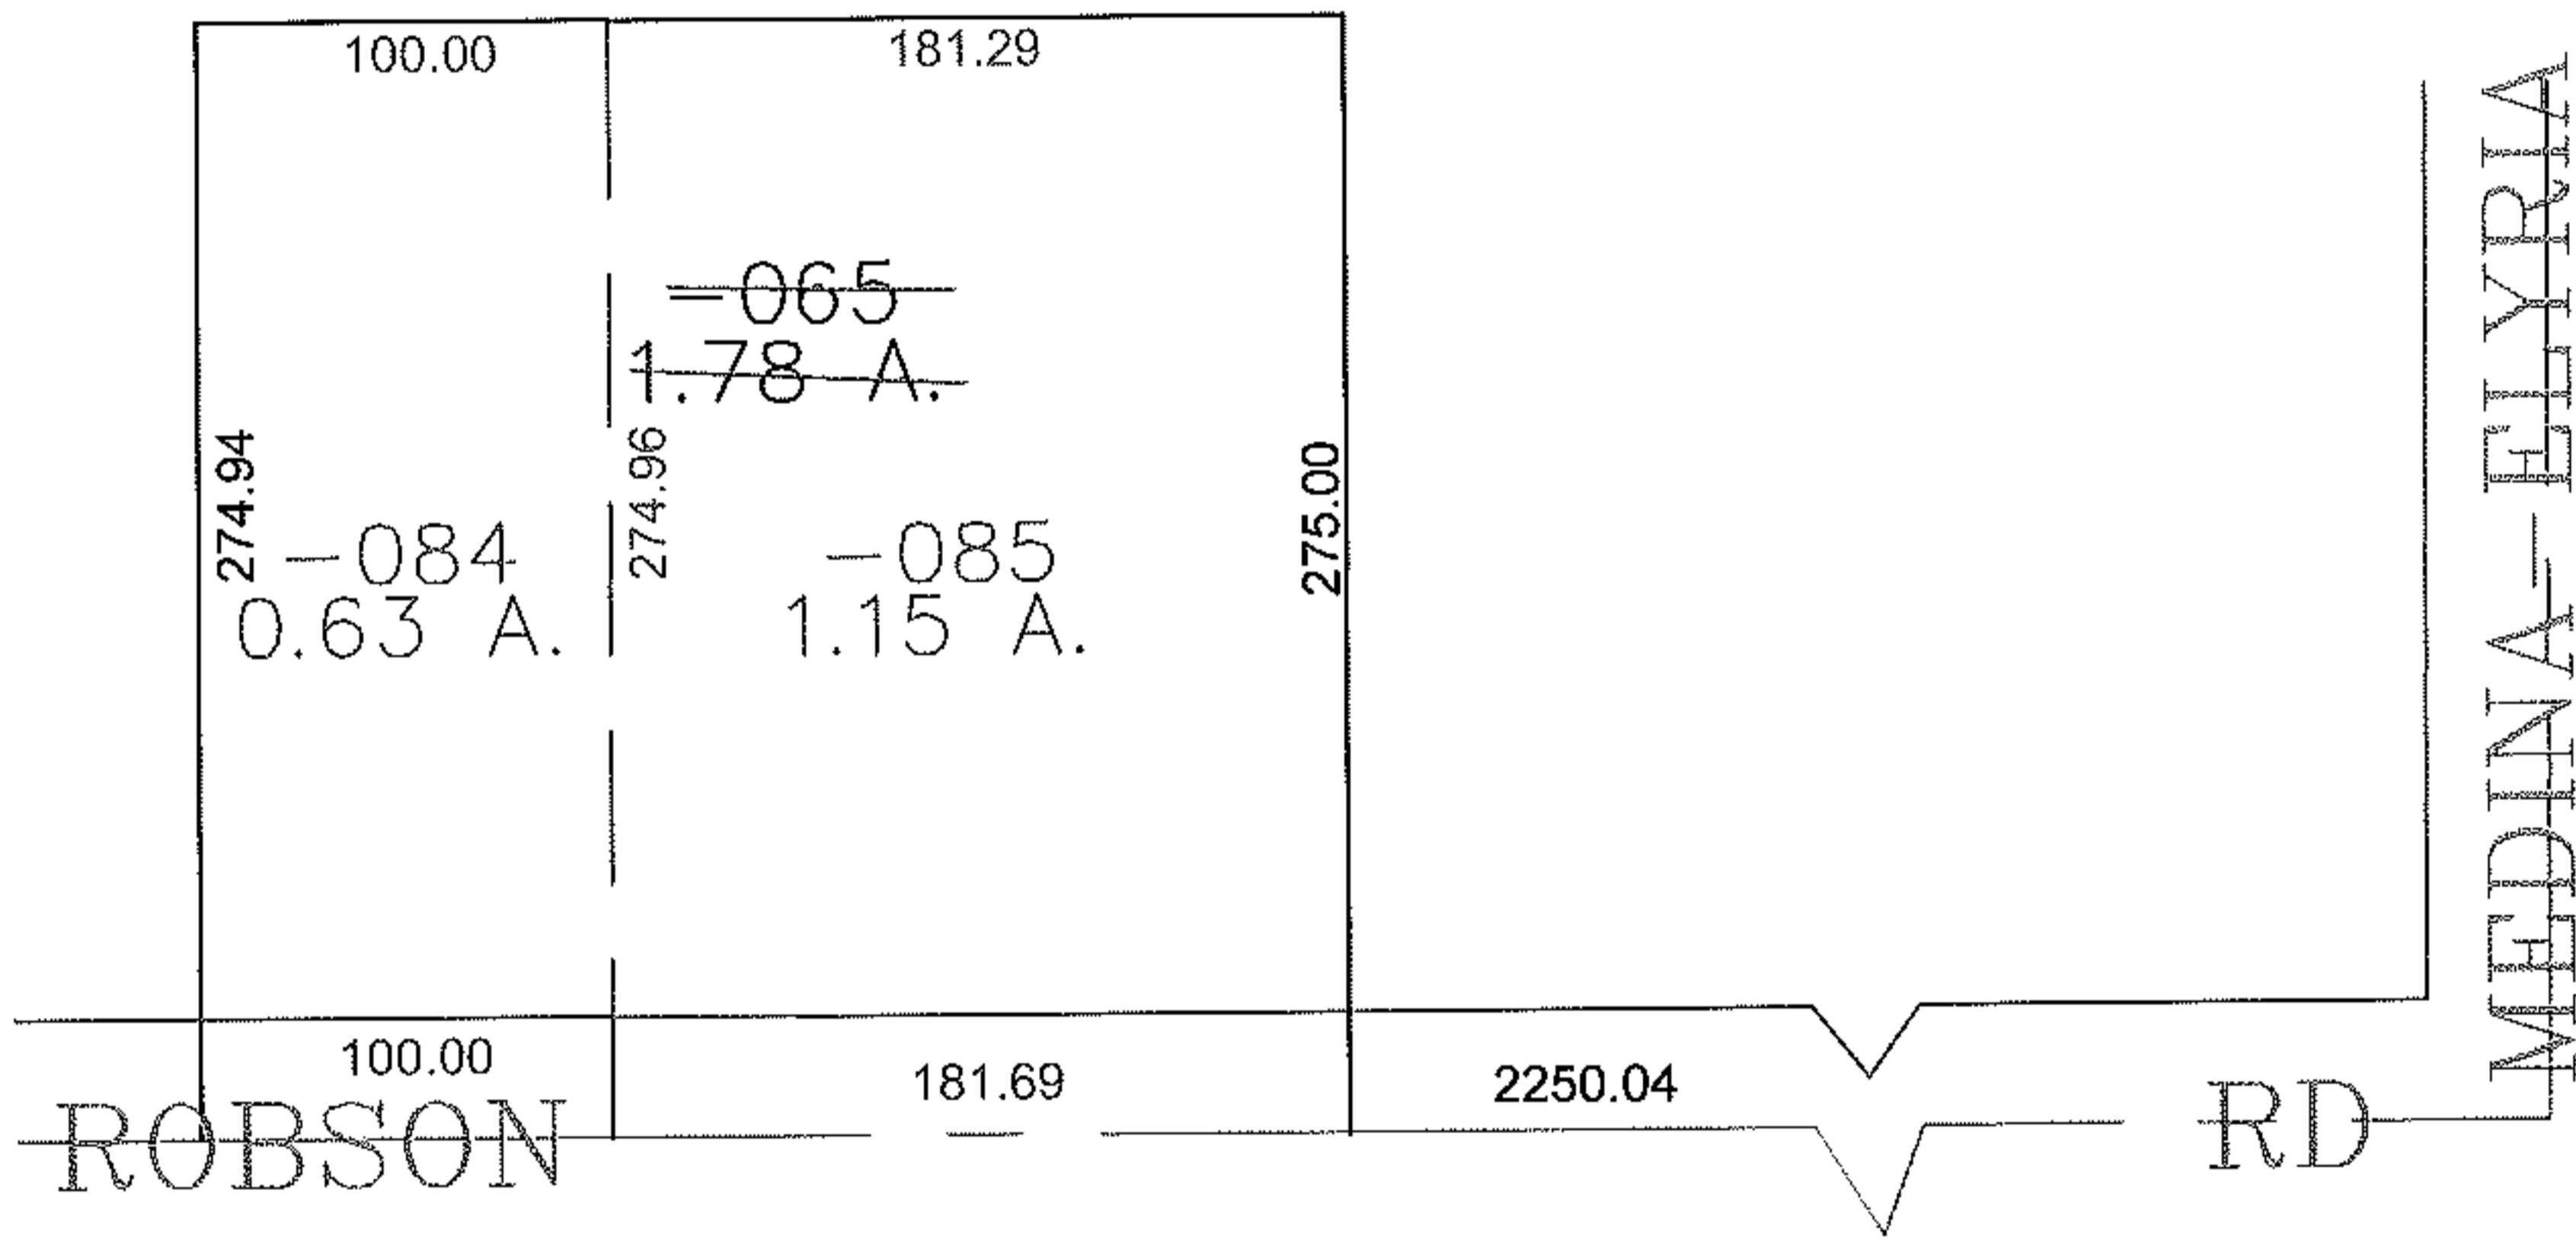


PARENT PARCEL: 10-00-015-116-065

CHILD PARCEL: 10-00-015-116-084, -085

STARTING POINT: CENTERLINE OF ROBSON RD & MEDINA-ELYRIA RD

13-03161

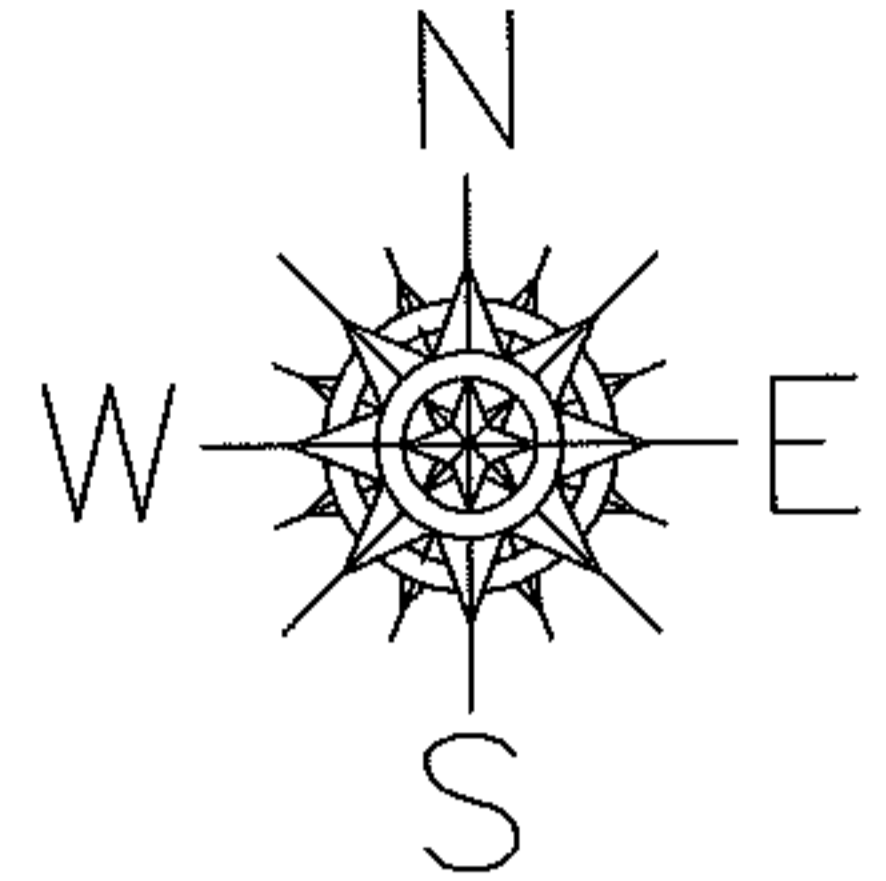

SPLITS/DEEDS PROCESSED

LORAIN COUNTY TAX MAP DEPARTMENT
226 MIDDLE AVE. ELYRIA, OHIO

SURVEYED BY: THOMAS SIMON
CLOSURE: 0.00 : 10.000
MAP PAGE(S): 10-00-015-G
APPROVED BY: JAH DATE: 6-27-2013
SCALE: 1" = 100 PRIOR INSTRUMENT: 19990601035