


PARENT PARCEL: 04-00-008-700-005

CHILD PARCEL: DROP FROM DUPLICATE

STARTING POINT: COMMON AREA

15-03162-D

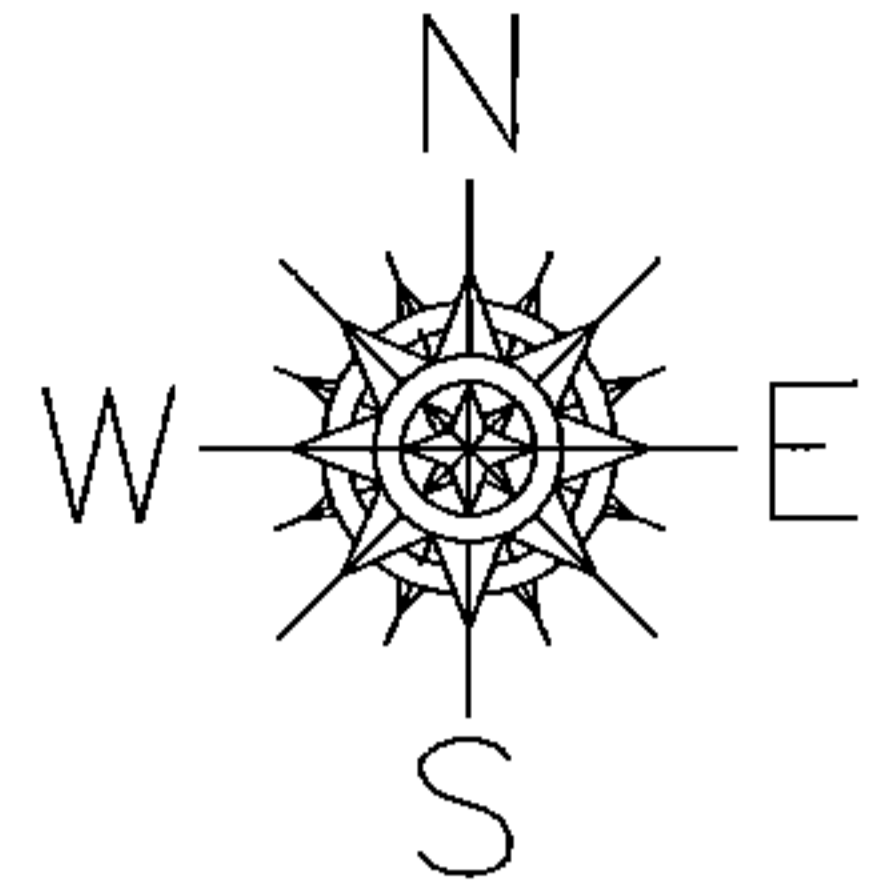


# DROP FROM DUPLICATE

## COMMON AREA

04-00-008-700-005

1.84 A.

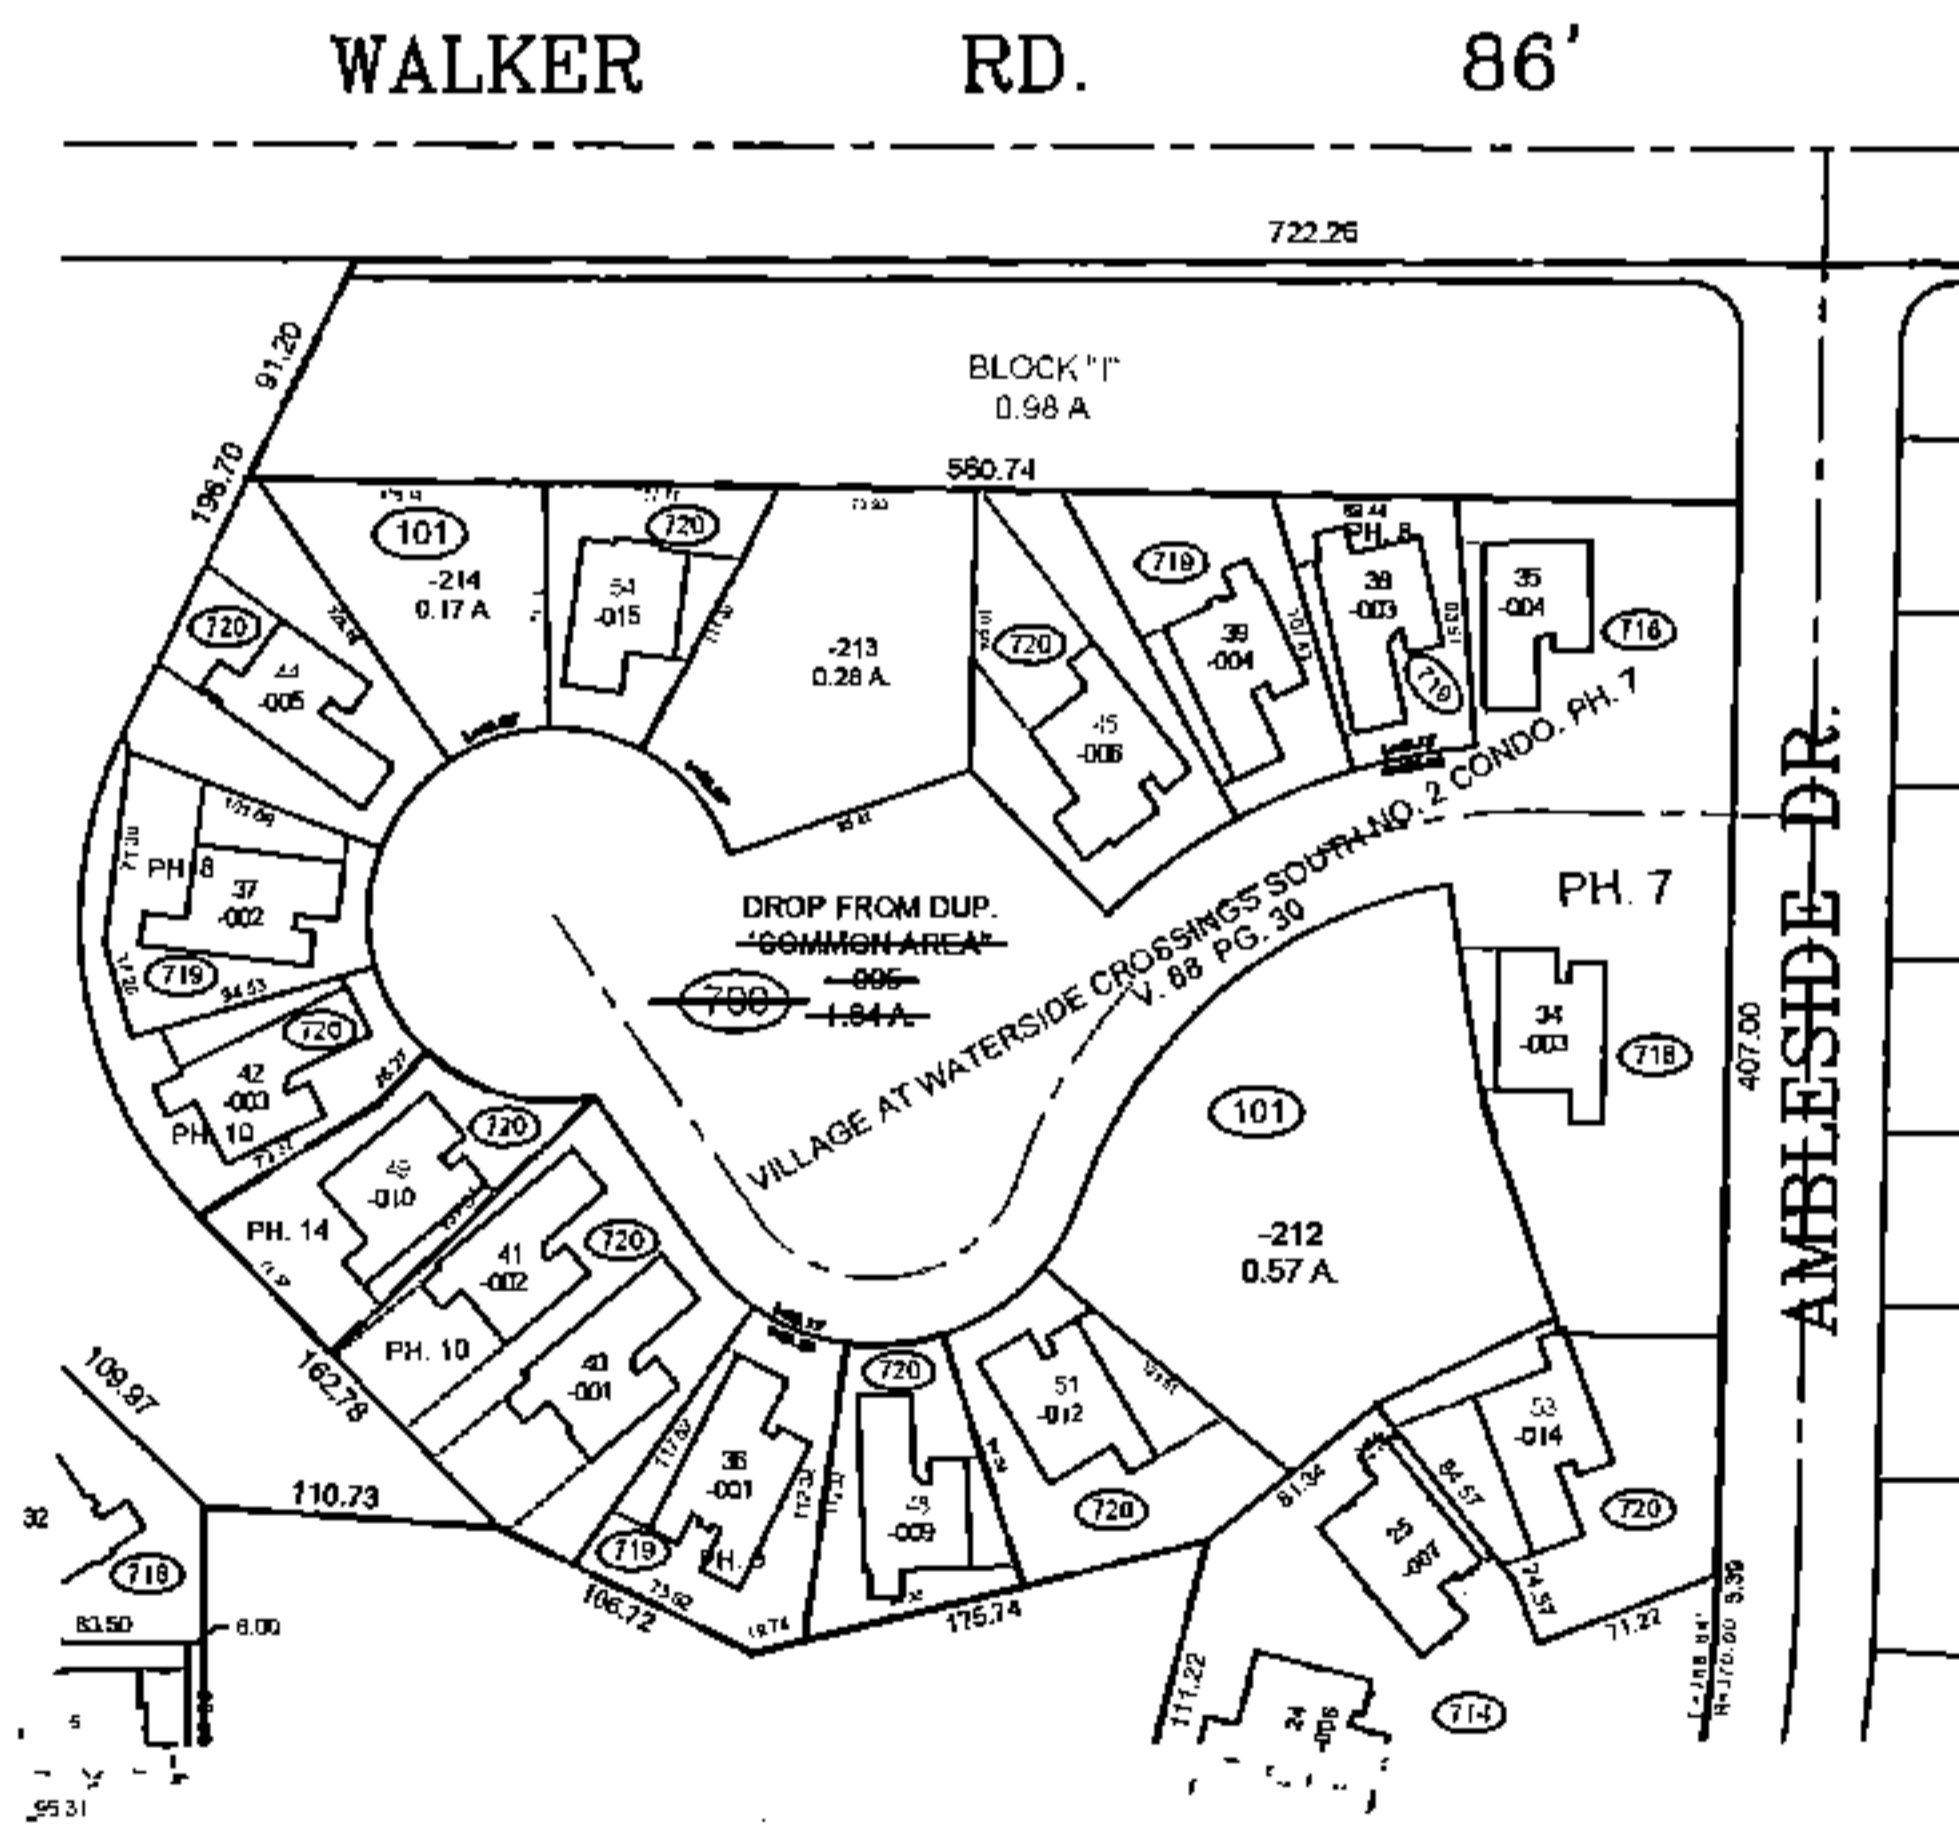

### SPLITS/DEEDS PROCESSED

LORAIN COUNTY TAX MAP DEPARTMENT  
226 MIDDLE AVE. ELYRIA, OHIO

SURVEYED BY: JAMES SAYLER

CLOSURE: 0.00 : 10.000

MAP PAGE(S): 04-00-008

APPROVED BY: TJS DATE: 5/1/15

SCALE: 1" = 200' PLATON INSTRUMENT: DV XXXX/XXX

V:\SPLITS\Pink\2015\15-03162-D\dwg\15-03162-D.dwg, 5/1/20

Trans 5/1/15