


PARENT PARCEL: 14-00-111-000-007

CHILD PARCEL: 14-00-111-000-010, -011

STARTING POINT: AT A MON BOX AT THE NORTHEAST CORNER OF O.L.111

13-03166

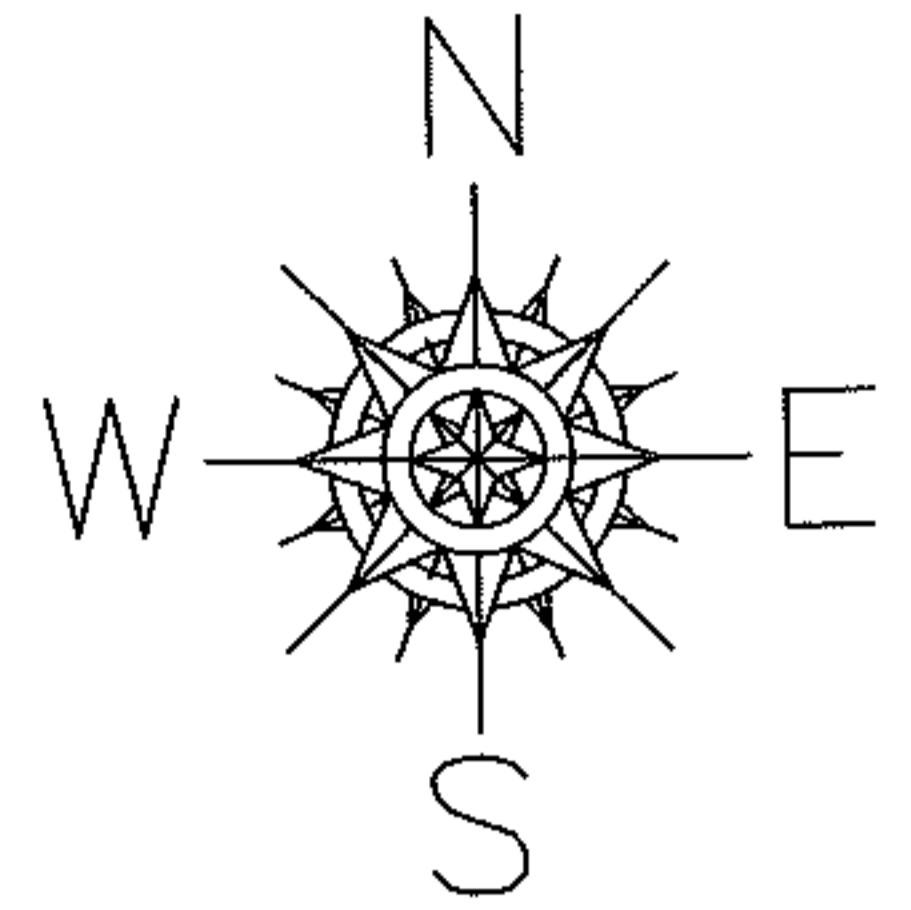

O.L.110

O.L.111

WHITNEY RD.

423.76

200.00

QUARRY RD.

607.92

-011
62.06 A.

~~-007~~
~~67.52 A.~~

-010
5.46 A.


489.57

161.60
138.30
221.33
154.86
62.45
.25

145.63

149.18

221.33

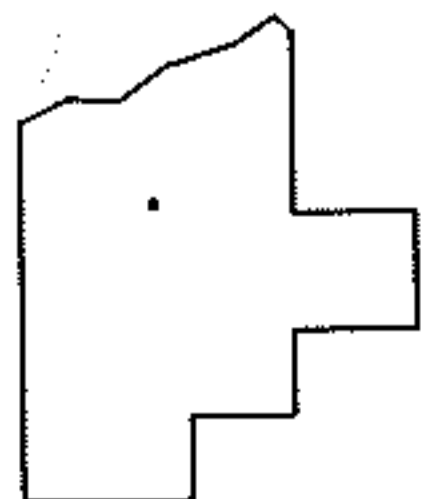

SPLITS/DEEDS PROCESSED

LORAIN COUNTY TAX MAP DEPARTMENT
226 MIDDLE AVE. ELYRIA, OHIO

SURVEYED BY: RICHARD D. CARLSON

CLOSURE: .01:10,000

MAP PAGE(S): 14-E

APPROVED BY: RRM DATE: 7-5-13

SCALE: 1"=200 PRIOR INST.: DV 1372/823